

WATER DISTRIBUTION SYSTEM IMPROVEMENTS

TO SERVE

ADDITIONAL COURTROOM AND CHAMBERS IN JUVENILE COURTHOUSE


PRIVATE PROJECT NO. 1484 PPW (607853)

CITY OF WICHITA, KANSAS

JAMES L. ARMOUR, P.E. - CITY ENGINEER

INDEX OF SHEETS

SHEET NO. CV200	TITLE SHEET
SHEET NO. CV201	KEY MAP AND GENERAL NOTES
SHEET NO. CV202	STANDARD DETAILS
SHEET NO. CV203	PLAN/PROFILE
SHEET NO. CV204-206	SOIL EROSION BMP DETAILS

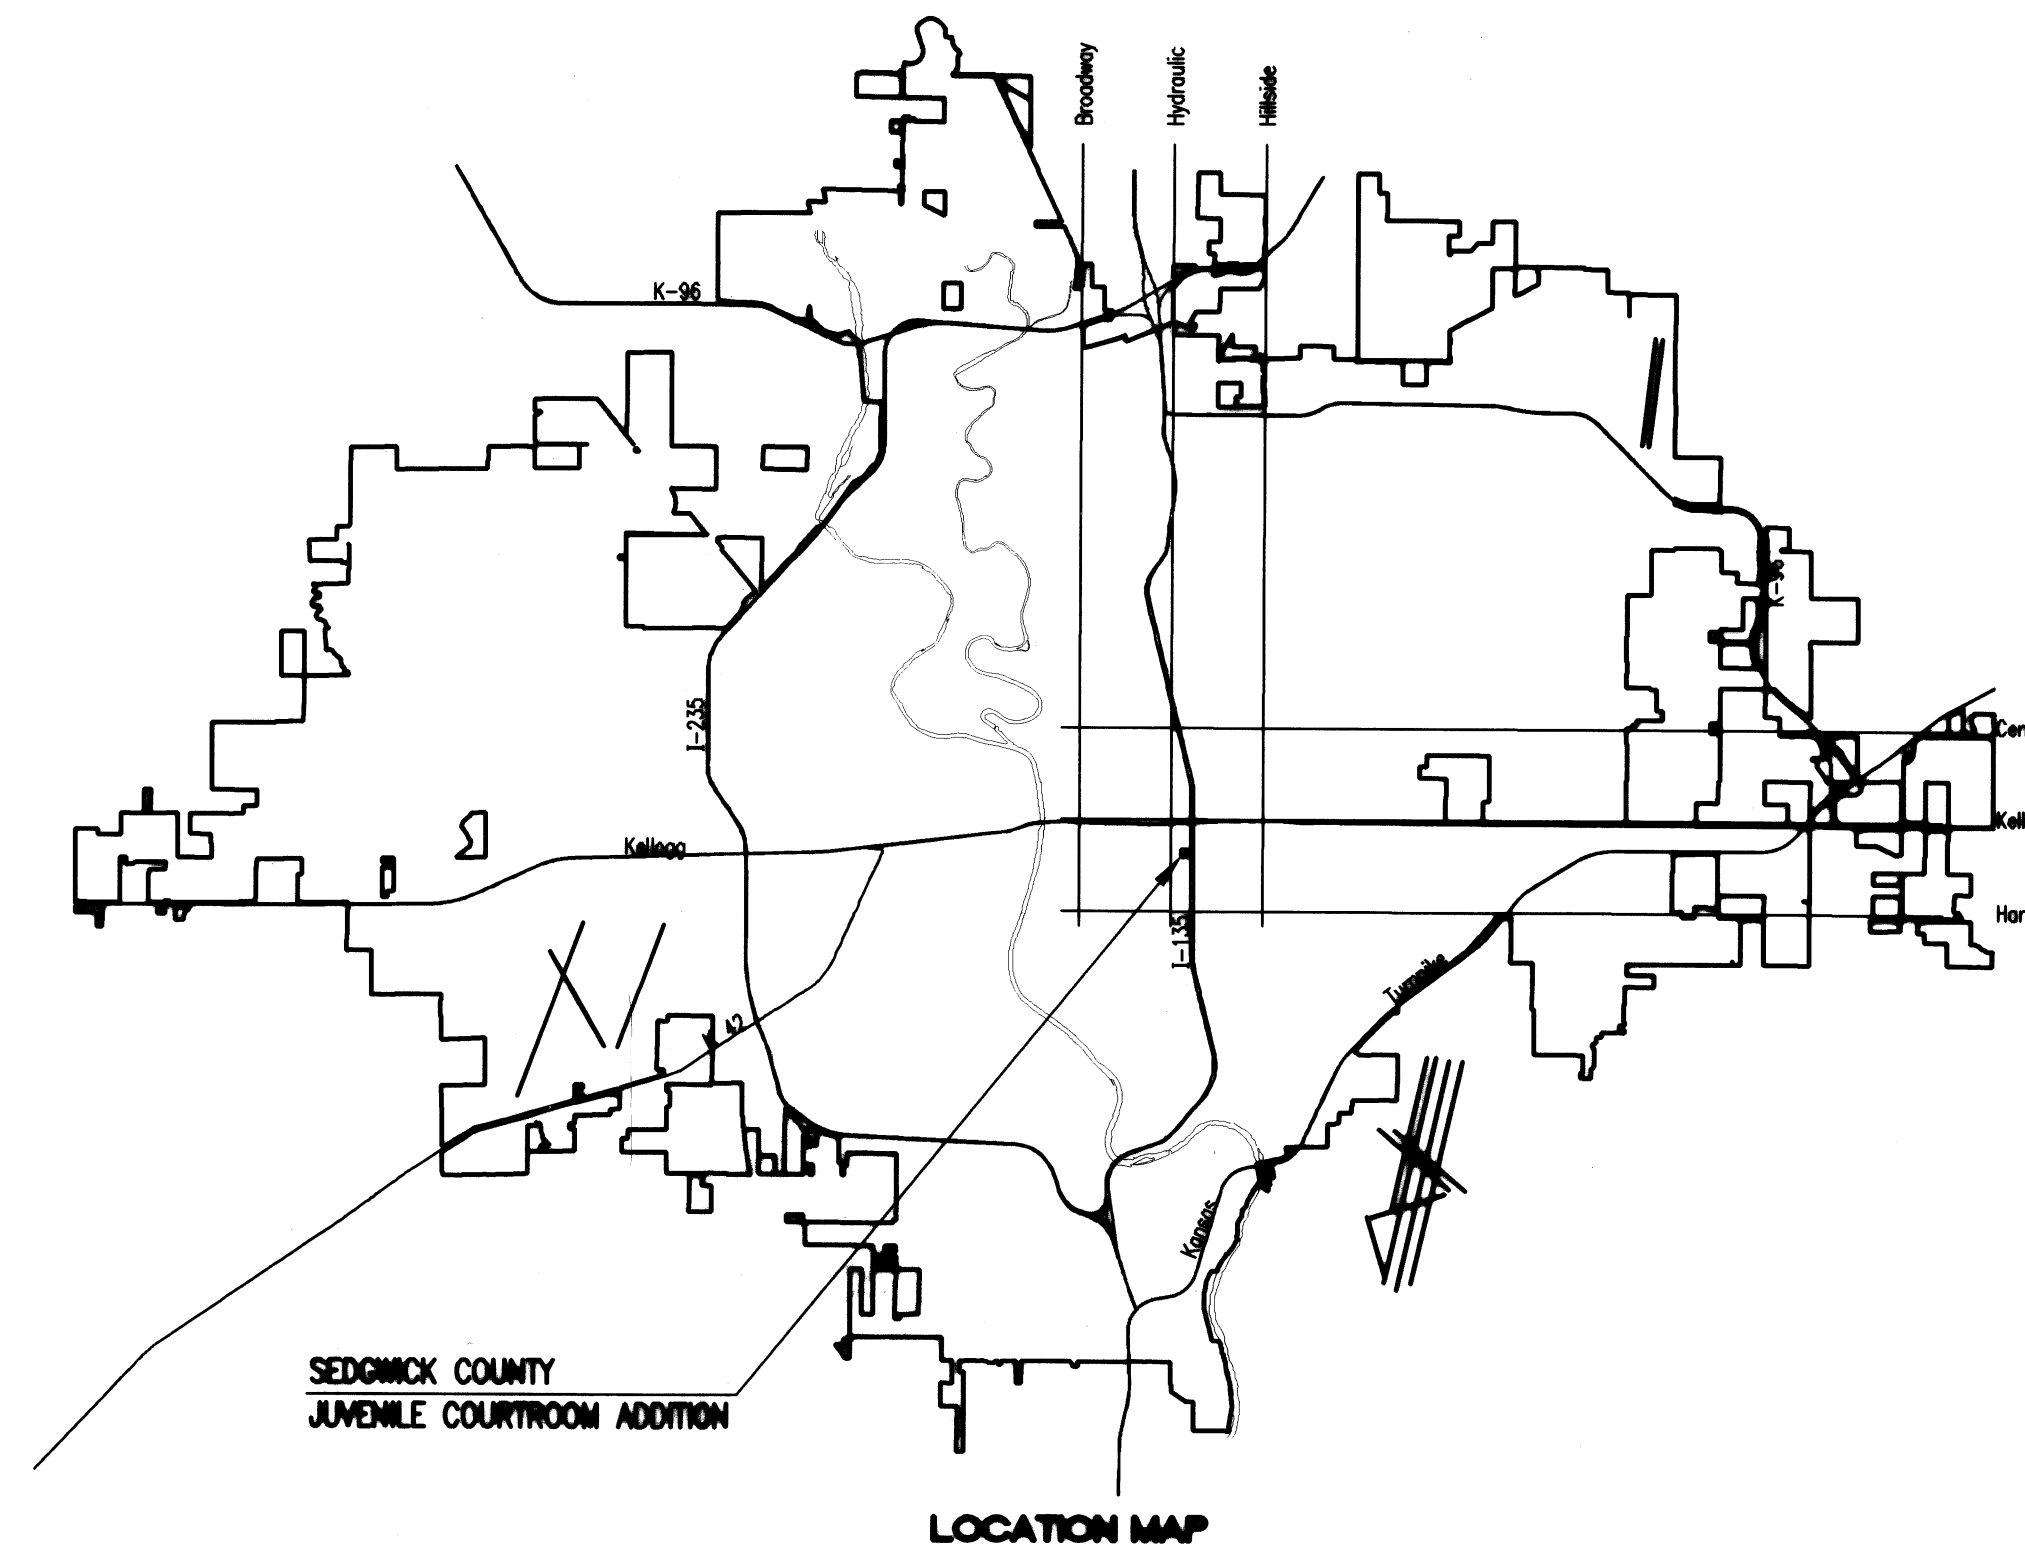

APPROVED AS NOTED
 BY CITY ENGINEER OF WICHITA,
 BY WICHITA WATER UTILITIES,
 & BY WICHITA FIRE DEPARTMENT

Water Mains (Public Works) *[Signature]* 10/8/09
 Water Mains (Water Utilities) *[Signature]* 10/8/09
 Fire Prot. Line *[Signature]* 10/9/09

NOTE TO CONTRACTORS


PUBLIC PROPERTY:
 Inspection and testing for the waterline is to be provided by a Licensed Consulting Engineering Firm under contract with the Owner/Developer. Said inspection to be in accordance with the City of Wichita standard construction engineering practices and certified by a Licensed Professional Engineer licensed in the State of Kansas. No work shall be performed in dedicated easements or public right-of-way by the Contractor without such inspection nor shall any work be commenced without written authorization by the City Engineer. All Construction and Materials shall comply with the City of Wichita Specifications and Standards (on file and available in the City Engineer's Office).

PRIVATE PROPERTY:
 Installation and testing for the fire protection line is to be performed by a City of Wichita licensed fire protection contractor in accordance with the fire codes as adopted by the City of Wichita. All materials and construction practices for the fire protection line shall comply with the fire codes as adopted by the City of Wichita (available from the City of Wichita Fire Department). The Contractor shall not commence work without notification and approval of the Wichita Fire Department.
 Inspection of the fire protection line is to be provided by the City of Wichita Fire Department and by a licensed Consulting Engineering Firm under contract with the Contractor.
 The contractor shall not start work until the project inspector is assigned to the project and present on the site. Any work done without inspection will be required to be uncovered for inspection.

As Built Plans:
 CONTRACTOR: McCullough Exc.
 INSPECTOR: Larry Gann, K E Miller Engineering
 .PDF by: LGG 4-28-2010

OCTOBER 2009

PLANS PREPARED BY
PROFESSIONAL ENGINEERING CONSULTANTS, P.A.
 ENGINEERS
 WICHITA, KANSAS

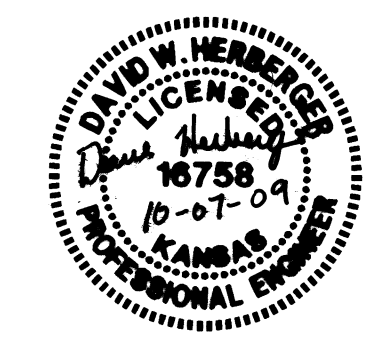

Sheet 10-07-2009 10:44:08 AM by: MCL
 Plot Scale: 1:1 10-07-2009 10:45:26 AM
 C:\2002\02116\09\PPW\02116-009-C-PPW\TITLE