

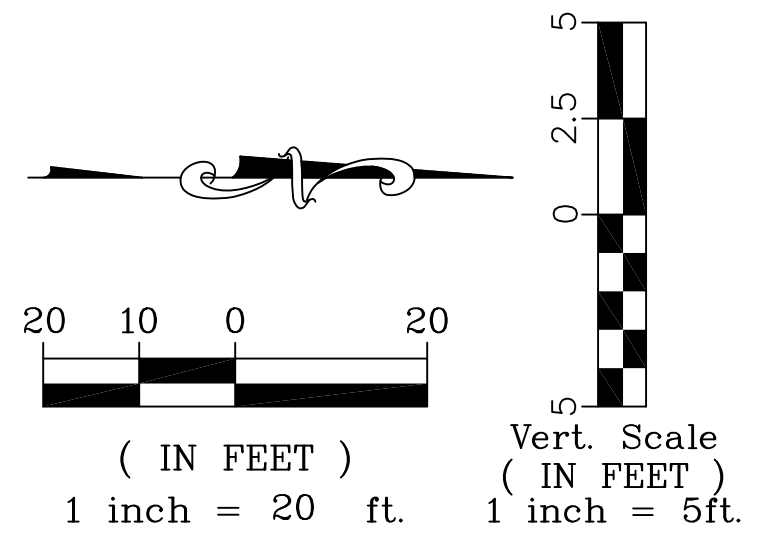


FHWA REG. NO.	STATE	PROJECT NO.:	YEAR	SHEET NUMBER	TOTAL SHEETS
	KANSAS				

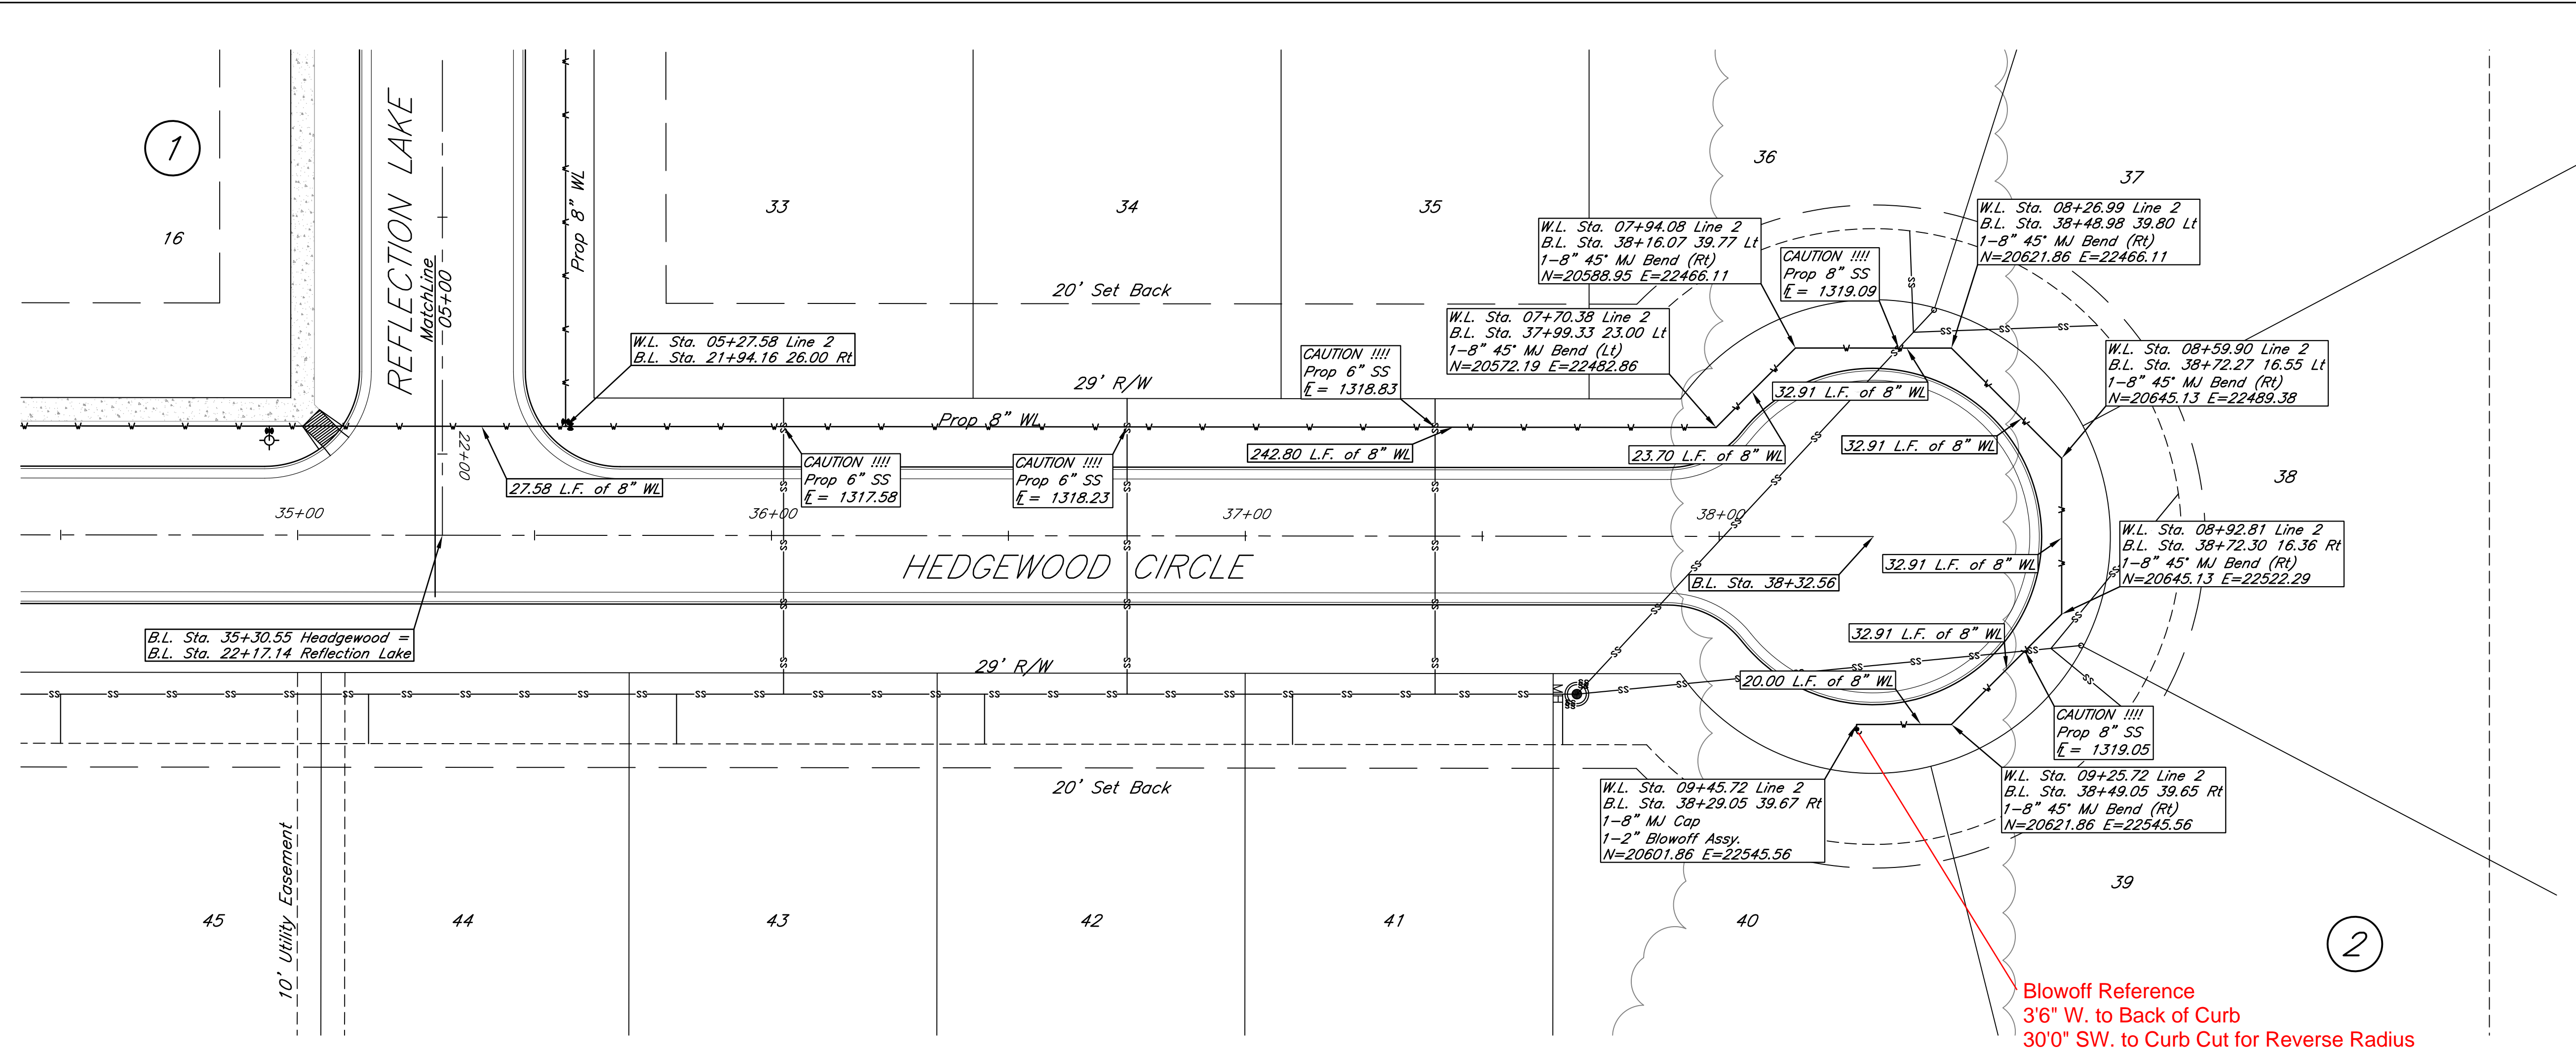

**RECORD DRAWING**  
3-29-2010

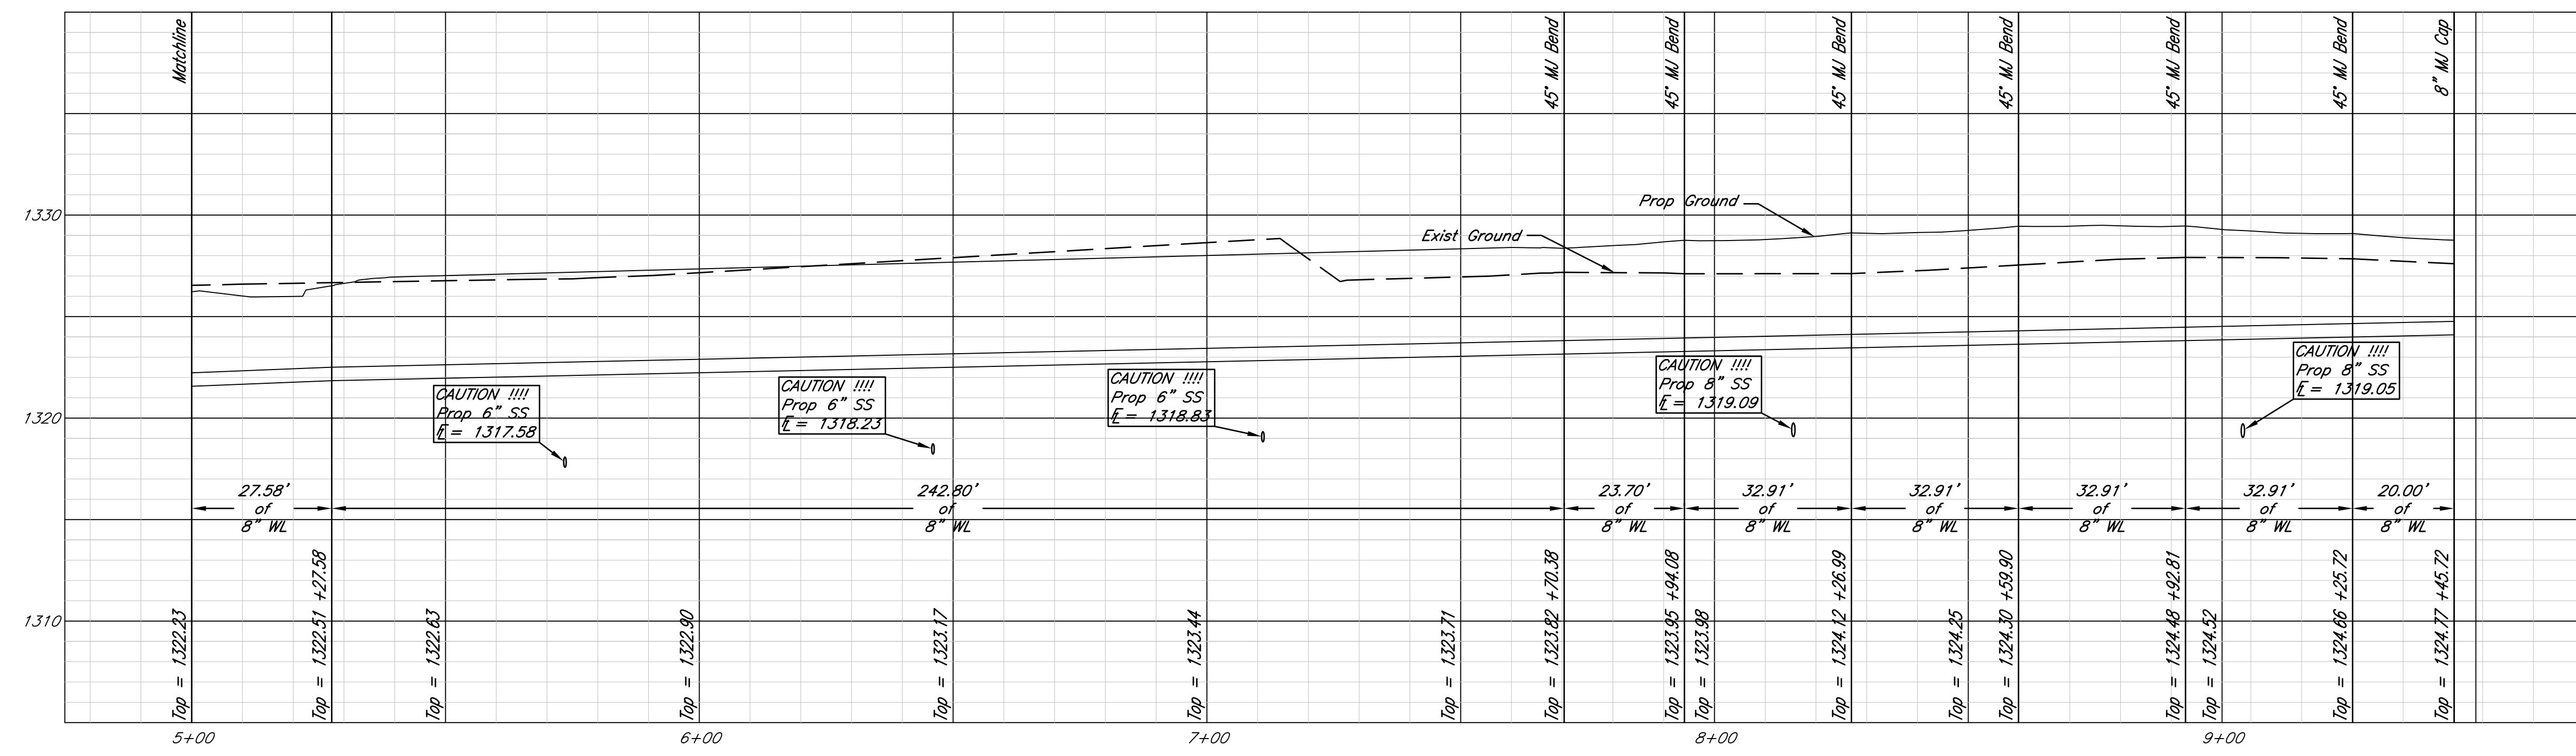

Reflection Lake 3rd Addition  
Line 2 05+00 - 09+46  
Andover, Kansas