



City of Wichita  
Sedgwick County, Kansas

# STREET AND STORM SEWER IMPROVEMENTS MEAD, FROM CENTRAL AVENUE TO 3rd STREET

CITY PROJECT NUMBER: 472 84561  
OCA NUMBER: 766158

CITY ENGINEER:  
MR. JAMES L. ARMOUR, PE


Kansas Paving - Contractor  
K. Graber - City of Wichita, Inspector  
As-built  
Release Date: 10/15/2009  
:APRosas 4/5/2010

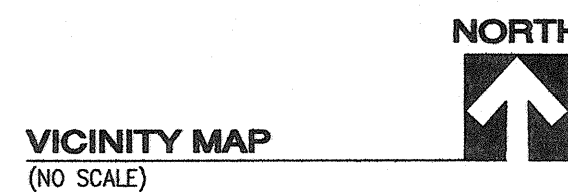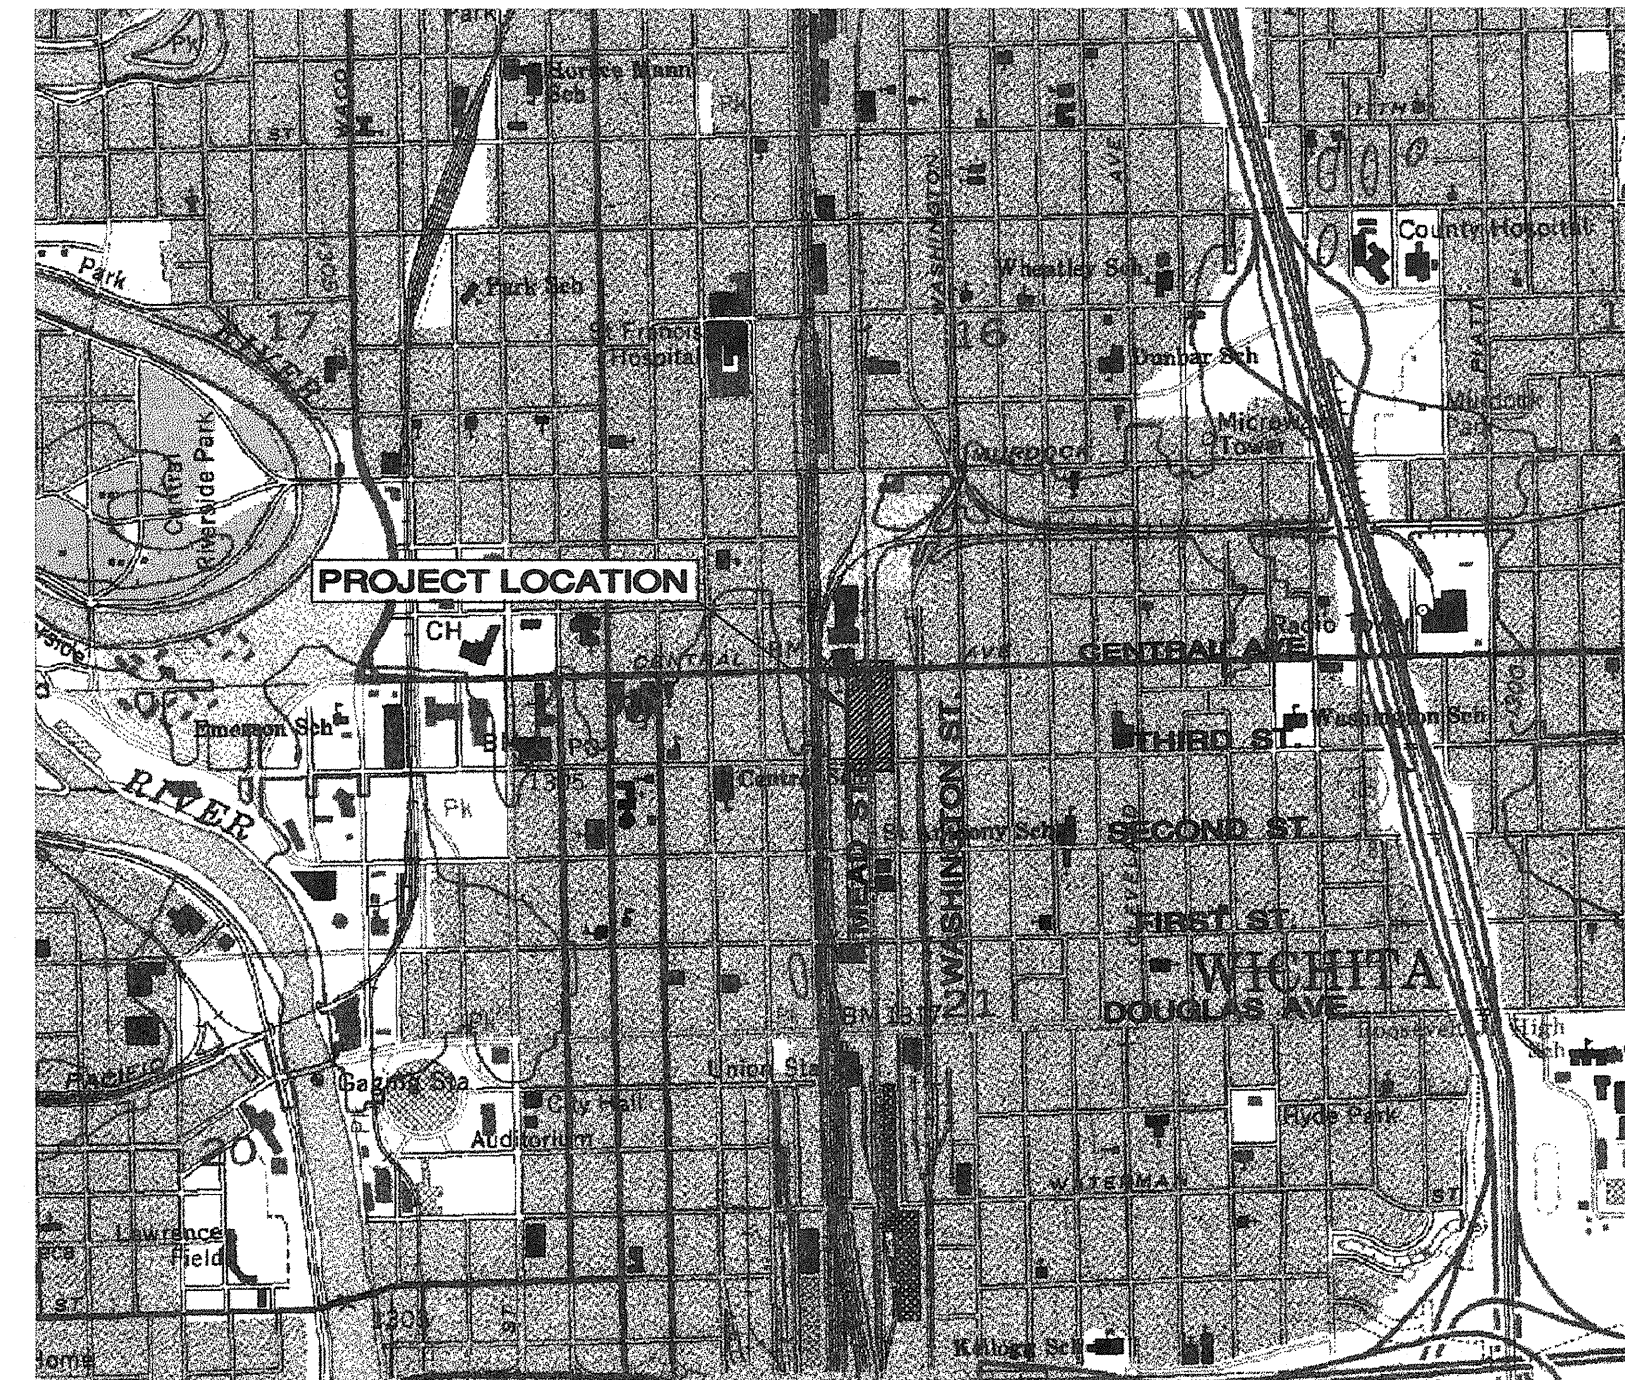

## INDEX OF SHEETS:

TITLE SHEET.....	1
KEY MAP AND GENERAL NOTES.....	2
TYPICAL PAVEMENT SECTION.....	3
MEAD STREET, PLAN & PROFILE (STA. 0+00 TO 3+00).....	4
MEAD STREET, PLAN & PROFILE (STA. 3+00 TO 5+86.88).....	5
PAVING JOINT AND GRADING PLAN.....	6
PAVEMENT MARKING AND LANDSCAPE LAYOUT PLAN.....	7
CONCRETE PAVEMENT DETAILS.....	8
VALLEY GUTTER DETAILS.....	9
SIDEWALK AND STEPS.....	10
AUXILIARY DETAILS FOR SIDEWALK & STEPS.....	11
STORM SEWER LINE NO. 1, PLAN & PROFILE.....	12
STORM SEWER LINE NO. 2, PLAN & PROFILE.....	13
STD. DOUBLE DRIVEWAY GRATED INLET.....	14
STD. SINGLE DRIVEWAY GRATED INLET.....	15
8" SANITARY SEWER LINE PLAN & PROFILE.....	16
STANDARD TYPE "P" MANHOLE.....	17
MANHOLE FRAME AND COVER.....	18
TEMPORARY EROSION CONTROL PLAN.....	19
TEMPORARY EROSION CONTROL DETAILS.....	20 - 22
STREET LIGHT PLAN & DETAILS.....	23 - 24
PAVEMENT CROSS SECTIONS.....	25 - 30

SEPTEMBER 2008

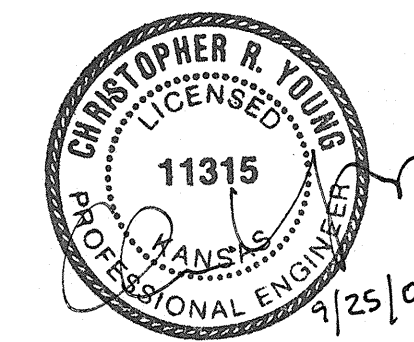

UTILITY NOTES:  
VISUAL INDICATIONS OF UTILITIES ARE AS SHOWN.  
UNDERGROUND LOCATIONS SHOWN, AS FURNISHED BY THEIR  
LESSERS, ARE APPROXIMATE AND SHOULD BE VERIFIED IN  
THE FIELD AT THE TIME OF CONSTRUCTION. FOR ACTUAL  
FIELD LOCATIONS OF UNDERGROUND UTILITIES, CALL  
1-800-344-7233.

PROJECT EARTHWORK TOTALS - FOR INFORMATION ONLY	
UNCLASSIFIED EXCAVATION (CUT)	2,653 CY
CALCULATED FILL	3 CY
NOTE: ABOVE QUANTITIES REPRESENT IN-PLACE VOLUMES. EARTHWORK FOR THE PROJECT WILL BE PAID FOR ON A LUMP SUM BASIS. PRIOR TO BIDDING THE WORK, THE CONTRACTOR SHALL SATISFY THEMSELVES OF THE ACCURACY OF THE ESTIMATED QUANTITIES BY EXAMINATION OF THE SITE, AND A THOROUGH REVIEW OF THE PLANS AND SPECIFICATIONS.	

PLANS PREPARED BY:

**YOUNG & ASSOCIATES, P.A.**  
Civil Engineering ■ Surveying ■ Land Development  
100 S. Georgie, Derby, KS 67037  
tele: (316)788-2552, fax: (316)788-4408, email: engineering@ynnga.com

**FINAL PLANS**  
Date Prepared: September 9, 2008