

Signed

JEFF PETERSON

Contractor

Cornejo /

WBCARTER (Subcontractor)

5-9-01

Date WEDNESDAY

Project CENTRAL / RIDGE Rd Intersection


Project Number 472 83057000 001 / Index Code 706805

SWS change:

REMOVED SWS MANHOLE IN TOTAL DRIVEWAY STA

REMOVED SWS PIPE 18" RCP


USED EXISTING FLOW LINE GRADE @ INLET LAID 18" PIPE SOUTHEASTERLY

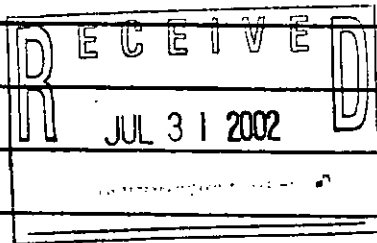

See Drawing ON BACK


Sketches, etc.

Removed 18" RCP South to MH
Removed MH @ STA

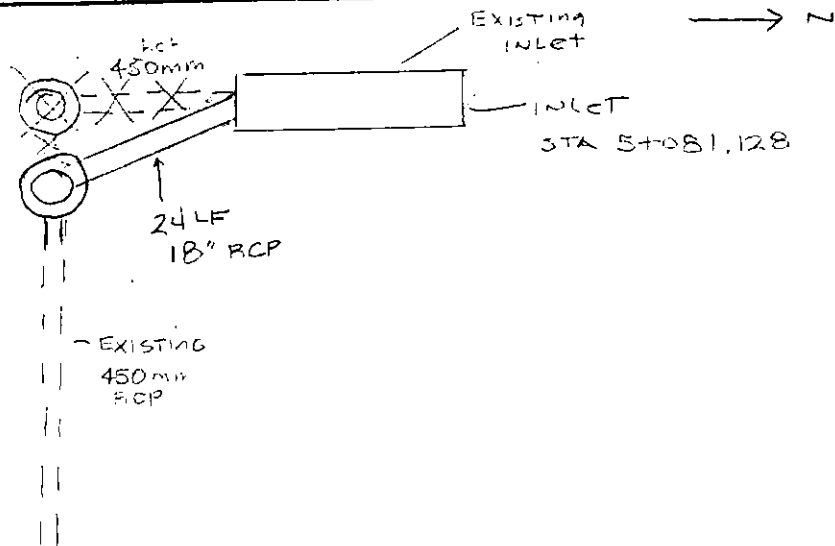

Signed JEFF PETERSONCorrejo /
Contractor WE Carters5/9/01
Date Wed.Project Central / Ridge Rd IntersectionProject Number 472 83057000 001 / Index Code 706805SWS change. Deleted Line from STA 9+963.200 Type C MH toMH STA 9+934.580 Type C MHDeleted MH STA 9+934.580 Type C and MH STA 9+910.0 Type D MH

10+379.000 Lt and 10+396.250 Lt. ⇒ Drop Inlet (600 mm x 600 mm)
constructed at each location, 375 mm RCP to existing RCP in
Central (as shown on plan - "Private Storm Sewer by Others").

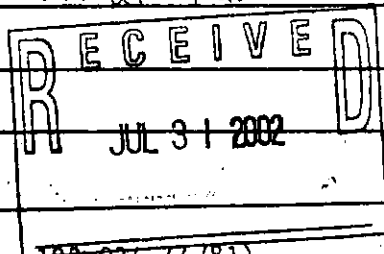

Sketches, etc.

