

HEARTLAND PREPAREDNESS CENTER

84675

LATERAL 127, SS #23

IN


THE CITY OF WICHITA, KANSAS

CITY OF WICHITA PROJECT NO. 468-84675

OCA NO. 792529

JAMES L. ARMOUR, P.E. - CITY ENGINEER

NOWAK CONSTRUCTION - CONTRACTOR
S. BREITENBACH - CITY OF WICHITA, SPECIAL PROJECTS ENGINEER
J. DECICCO - CITY OF WICHITA, INSPECTOR
AS-BUILT
RELEASE DATE:
PDF: APROSAS 10/25/2010

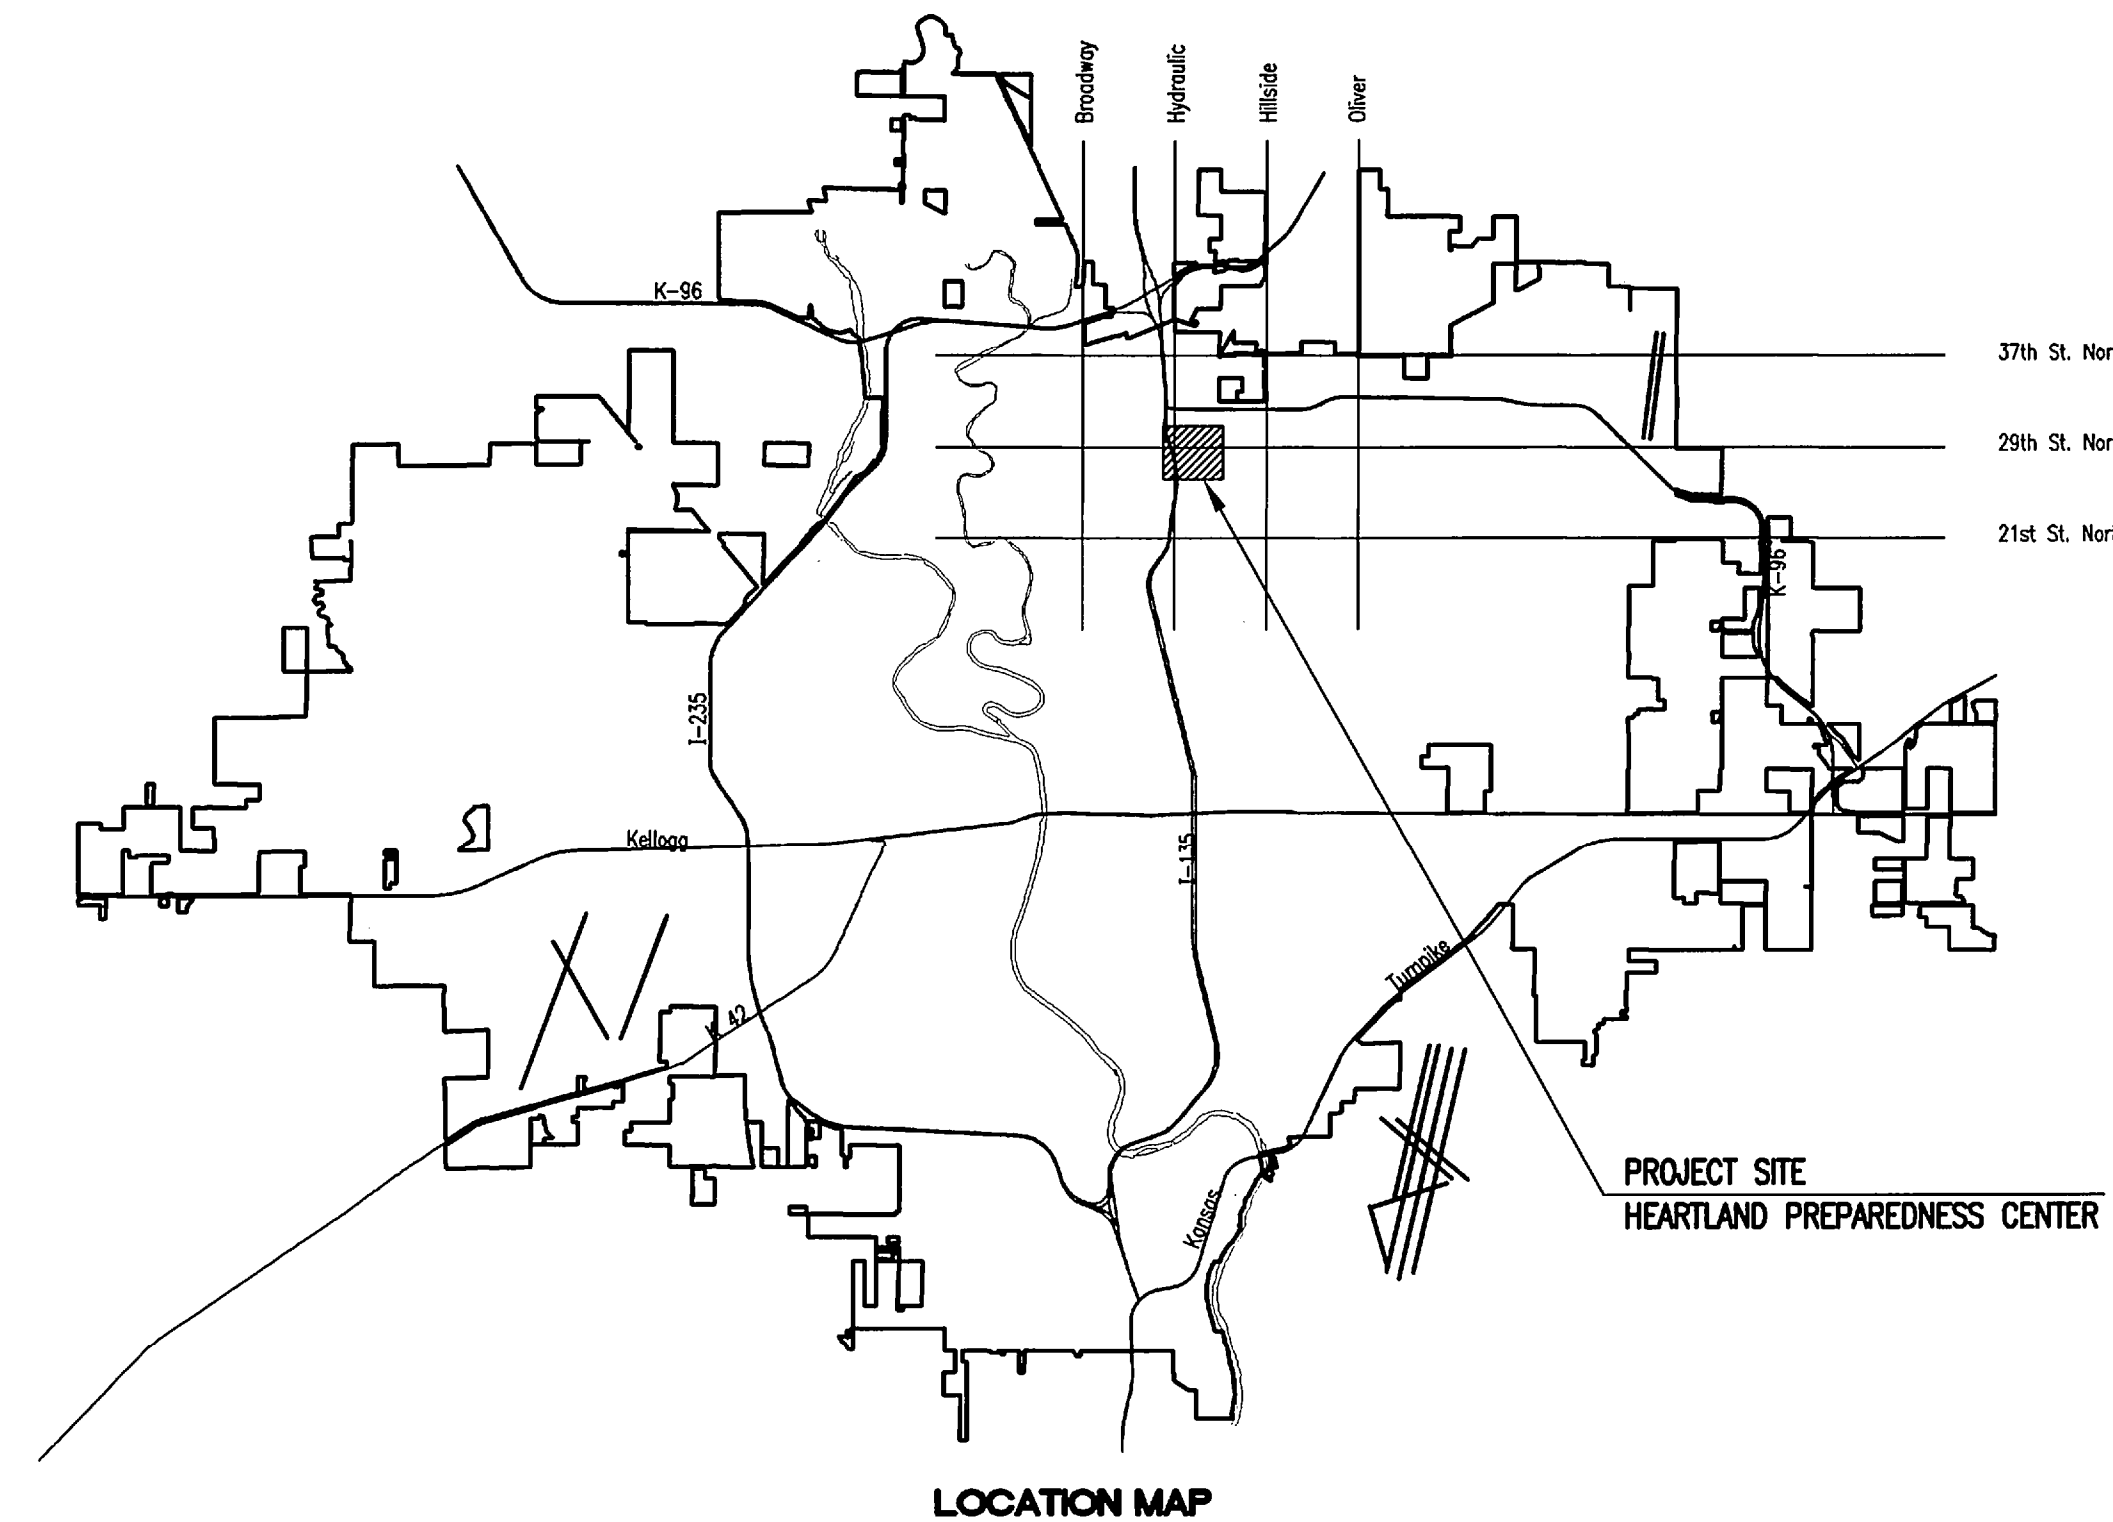

INDEX OF SHEETS

SHEET NO. 1	TITLE SHEET
SHEET NO. 2	KEY MAP AND GENERAL NOTES
SHEET NO. 3	HORIZONTAL AND VERTICAL CONTROL
SHEET NO. 4-5	PLAT
SHEET NO. 6	PLAN/PROFILE
SHEET NO. 7	TYPE "P" MANHOLE DETAILS
SHEET NO. 8	FRAME & COVER DETAILS
SHEET NO. 9	MANHOLE ADJUSTMENT DETAILS
SHEET NO. 10-12	SOIL EROSION BMP DETAILS

JULY 2010

PLANS PREPARED BY
PROFESSIONAL ENGINEERING CONSULTANTS, P.A.
ENGINEERS
WICHITA, KANSAS

