

STATE	PROJECT NO.	YEAR	SHEET NO.	TOTAL SHEETS
KANSAS	472-84702	2010	1	36

# CITY OF WICHITA BRIDGE REPLACEMENT

CITY OF WICHITA PROJECT NO. 472-84702


## 31ST STREET BRIDGE AT GLENN

WICHITA, SEDGWICK COUNTY

**BRIDGE REPLACEMENT  
SURFACING  
SANITARY SEWER  
STORM SEWER  
SEEDING  
PAVEMENT MARKING**

### INDEX OF SHEETS

1. Title Sheet
2. Typical Section
3. Plan Sheet
4. Curb and Gutter Details
5. Type I Curb Inlet
6. Standard/Special Shallow Manhole
7. Schedule of Inlets and Manholes
- 8.-9. Sidewalk and Steps
10. Contour Map
- 11.-17. R.F.B. Bridge Details
- 18.-20. Sewer Siphon Details
21. Bridge Excavation
22. Supports and Spacers for Reinforcing Steel
23. Summary of Quantities
- 24.-27. Soil Erosion Control and Water Pollution Control
28. Pavement Marking Plan
- 29.-31. Traffic Control Plan
- 32.-36. Cross Sections

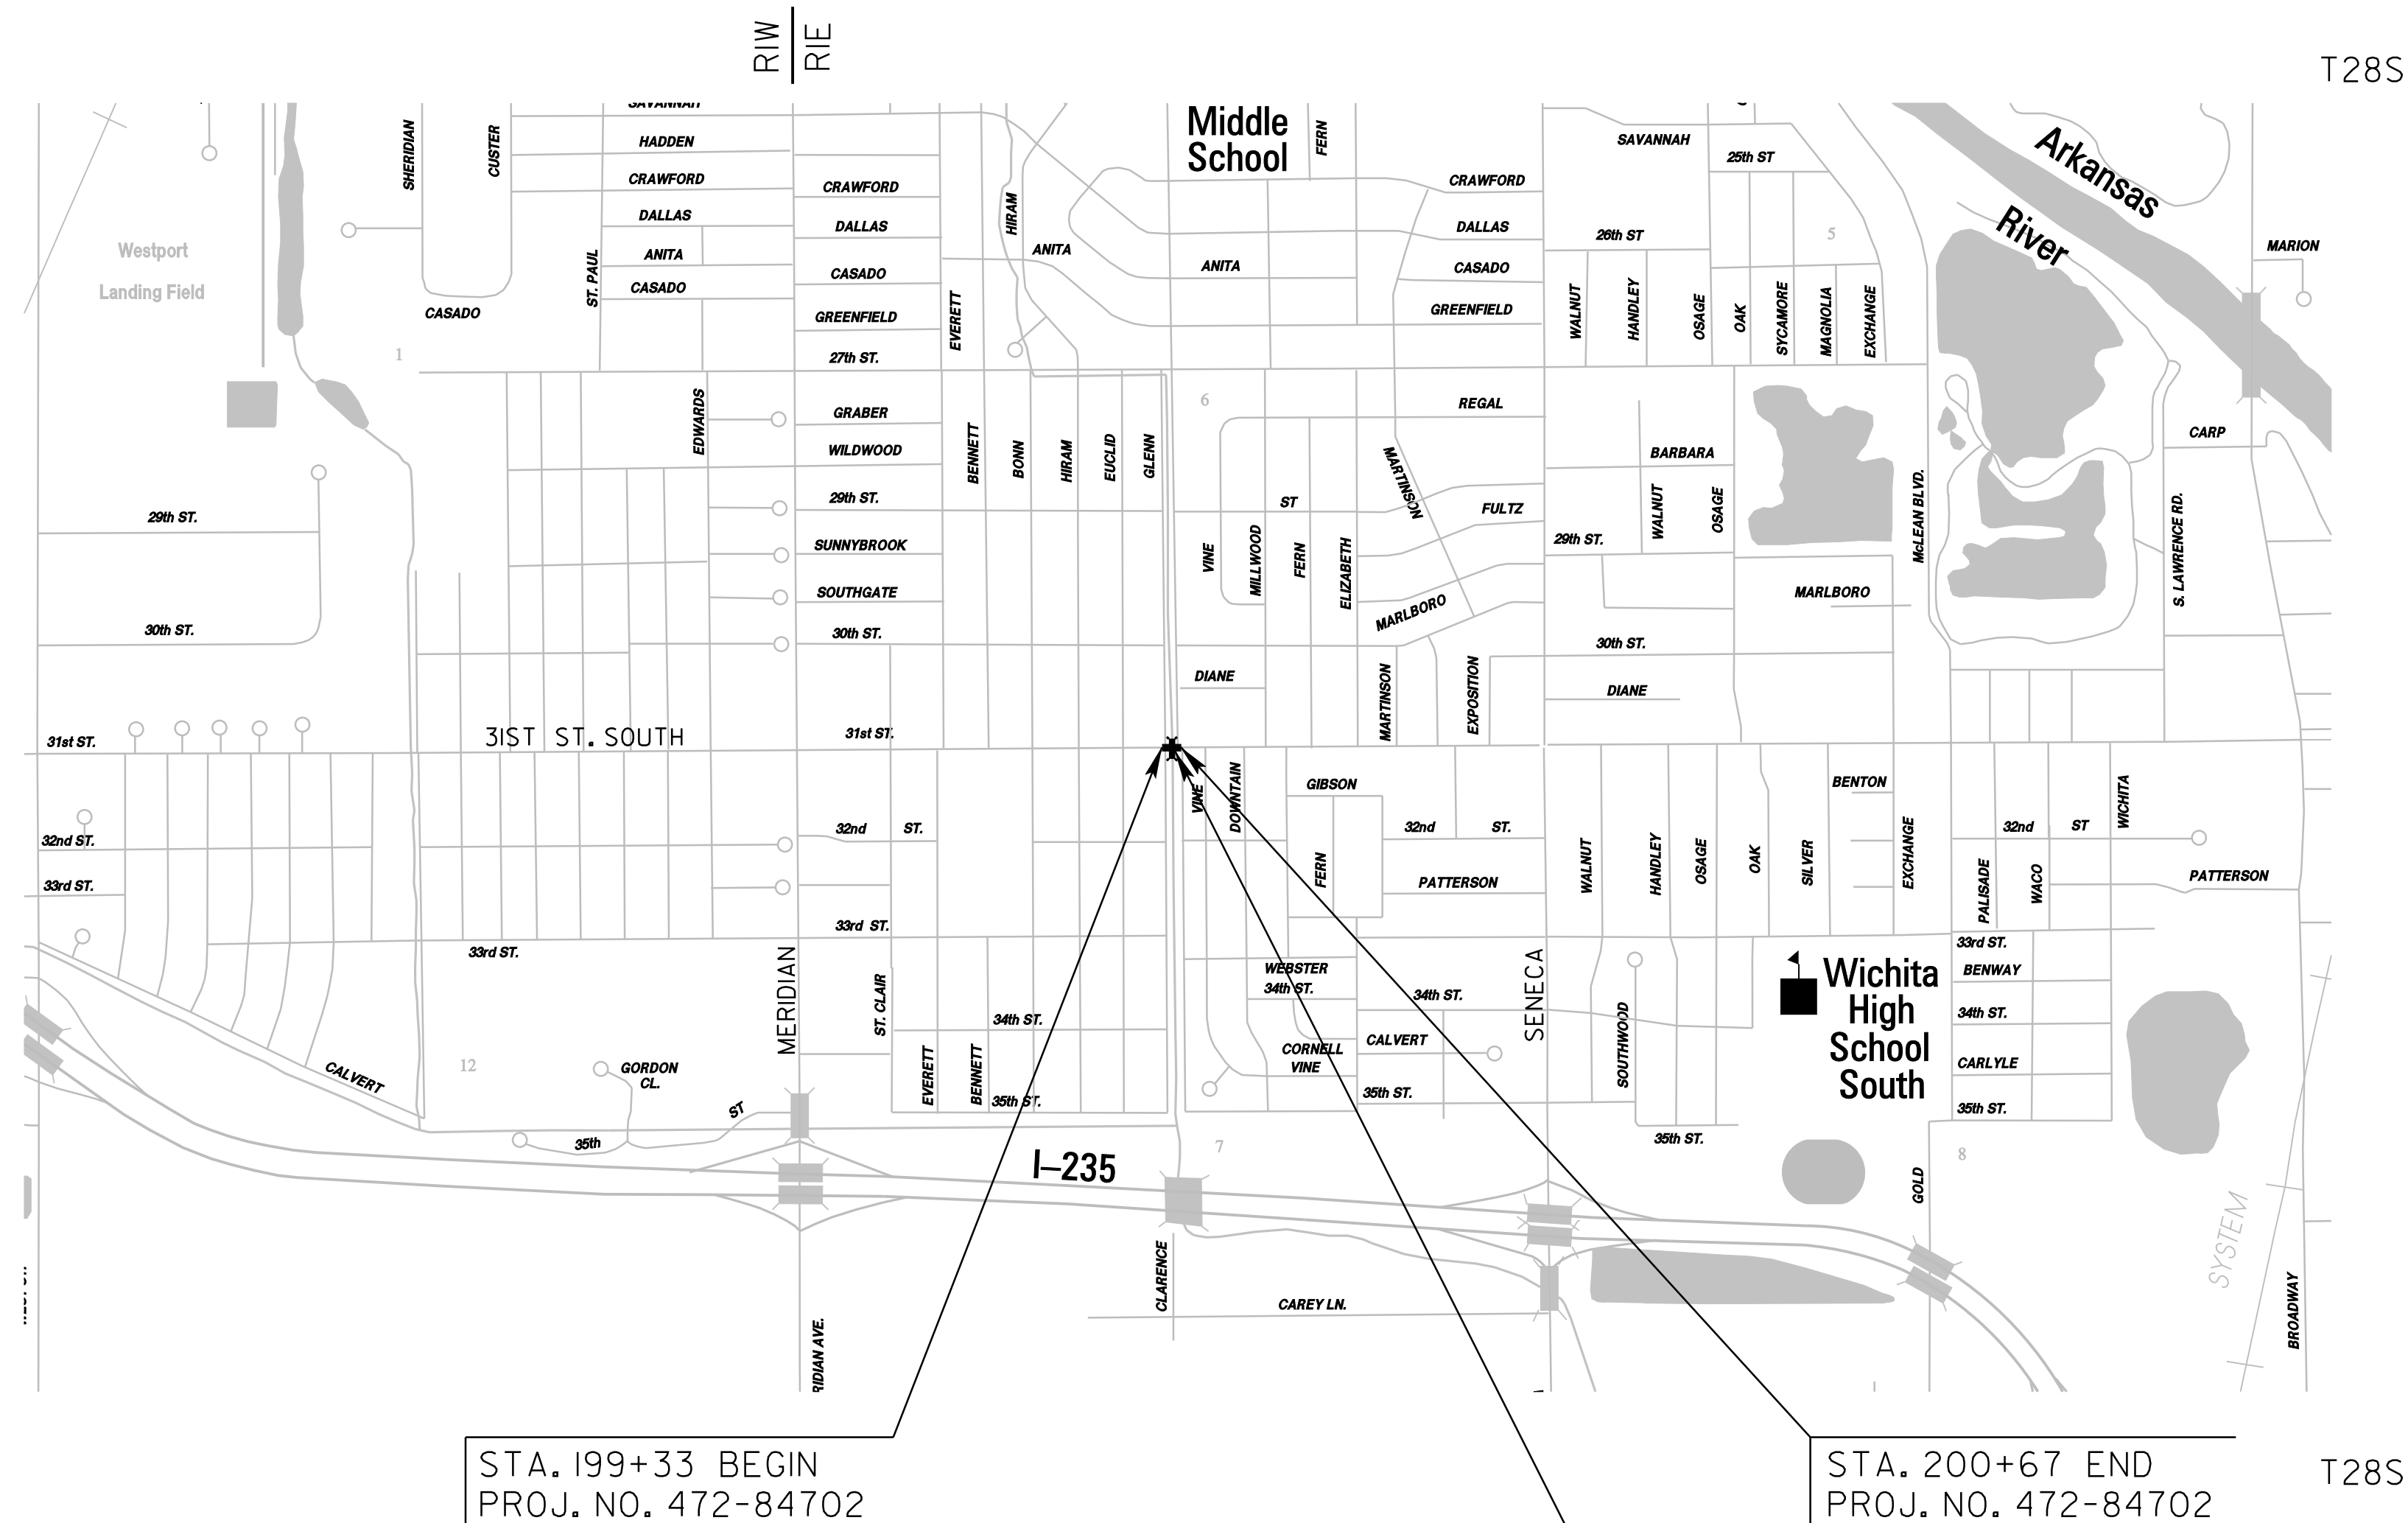

NOTE:  
31ST STREET SHALL BE CLOSED TO TRAFFIC DURING CONSTRUCTION.

Snodgrass & Sons - Contractor  
S. Degenhardt - City of Wichita, Area Engineer  
M. Thom - City of Wichita, Inspector  
As-built  
Release Date: 11/19/2010  
pdf: APRos 4/25/2011



CONVENTIONAL SIGNS	
COUNTY LINE	CENTER LINE OF PROJECT
CITY LIMITS	TERRACE
STATE OR NATIONAL LINE	CULVERTS
TOWNSHIP, SECTION or GRANT LINE	DROP INLET & STORM SEWER
PROPERTY LINE	ACCESS CONTROL
HIGHWAY FENCE	POWER POLE
EXISTING FENCE	TELEPHONE POLE
GUARD FENCE	MARSH
CONSTRUCTION LIMITS	HEDGE
RIGHT OF WAY LINE	TREES
TRAVELED WAY	PROFILE ELEVATION
RAILROADS	STREAM or CREEK

GROSS LENGTH OF PROJECT	134.00	FT.		
EXCEPTIONS	0	FT.		
ADDITIONS	0	FT.		
NET LENGTH OF PROJECT	134.00	FT.	0.019	MILES
NET LENGTH OF BRIDGES	33.34	FT.	0.006	MILES
NET LENGTH OF ROAD	100.66	FT.	0.013	MILES

STA. 199+90  
3'-10" x 4' x 102' - 0 1/2" R.F.B.  
WITH SOIL SAVER LT.  
SKEW 11°-30' LT.

PLANS PREPARED BY :  
**PARSONS BRINCKERHOFF**  
188. Wichita, Kansas

RECOM. FOR APPROVAL-DATE  
  
JAMES ARMOUR, P.E.  
CITY ENGINEER  
CITY OF WICHITA, SEDGWICK COUNTY, KANSAS