

# Paving Improvements

## Ellis from 43rd St S to 44th St South

### Carol Jean 2nd Addition

### 207PPP (607879)

## GENERAL NOTES

1. Contractor will be required to provide a minimum advance notice of seventy-two (72) hours to utility companies prior to starting any excavation as follows:

Kansas One-Call 687-2470

The Contractor must notify the following in case of an emergency:

Cox Communications 262-0661  
 Kansas Gas Service 888-482-4950  
 Westar 383-8600  
 Aquila 1-800-303-0357  
 SBC 1-800-286-8313  
 City of Wichita Water Department 262-6000  
 City of Wichita Sewer Maintenance 262-6000

2. Underground utility service lines and overhead utility pole lines are to be adjusted as necessary by others prior to construction unless the plans specifically call for their adjustment by the Contractor or unless the plans specifically identify a utility to be adjusted by its owner during construction. Existing utilities and their location, as shown on the plans, represent the best information obtainable for design. Location information has been obtained from the various utility companies and is either from company record drawings or company-provided field locations. The Contractor will be required to work around existing utilities within the right-of-way which do not conflict with proposed construction.

3. Rubble from the removal of miscellaneous structures and excess excavation which is to be wasted shall be disposed of on sites to be provided by the Contractor. These sites shall be approved by the Engineer as to suitability, appearance and site location. Locations that, in the opinion of the Engineer, will leave an unsightly appearance will not be approved.

4. All disposal sites must be approved by the Kansas Department of Health and Environment. Material either stockpiled or disposed of in a flood plain would require a Kansas State Board of Agriculture permit. Any material dumped in waters of the United States or wetlands is subject to U.S. Corps permitting regulations. Any material buried or stockpiled beyond approved of Engineers construction limits would require additional archeological investigations unless buried in a previously approved borrow location.

5. The Contractor shall give all property owners and/or tenants of developed property directly abutting the construction of this project a minimum of ten (10) days advance notice prior to start of construction.

6. This project is to be constructed in accordance with City of Wichita Standard Specifications for the Construction of City Projects, and Policy on Construction of Infrastructure by Private Contract.

7. No work shall begin on this project before permits or bonds required to construct this project are obtained or submitted to the City of Wichita and the project inspector has been notified.



AS BUILT PLANS  
 Contractor: Kansas Paving  
 Inspector: Anthony Young, Ruggles & Bohm  
 .pdf by: Eric Glover, 01 June 2011

IMPROVEMENT DISTRICT


**CITY OF WICHITA, KANSAS**  
**JAMES ARMOUR, P.E. - CITY ENGINEER**

## BENCH MARKS

BENCH MARK #1: CHISELED SQUARE AT THE WEST CURB  
 RETURN AT THE SOUTHWEST CORNER OF VICTORIA AND  
 44TH STREET SOUTH  
 ELEVATION = 1270.50 (NAVD88)

## INDEX OF SHEETS

1. TITLE SHEET
2. 31' TYPICAL SECTION
3. RCVG DETAIL
- 4-5. ELLIS PLAN/PROFILE
- 6-7. INTERSECTION DETAILS
8. STORM SEWER PLAN
9. TYPE 1A DETAIL
10. TYPE P MH DETAIL
11. SITE GRADING
12. 4 CORNER GRADING PLAN
13. KEY MAP/EROSION CONTROL DETAIL
- 14-18. EROSION CONTROL BMP DETAILS
- 19-20. CROSS SECTIONS
21. FINAL PLAT

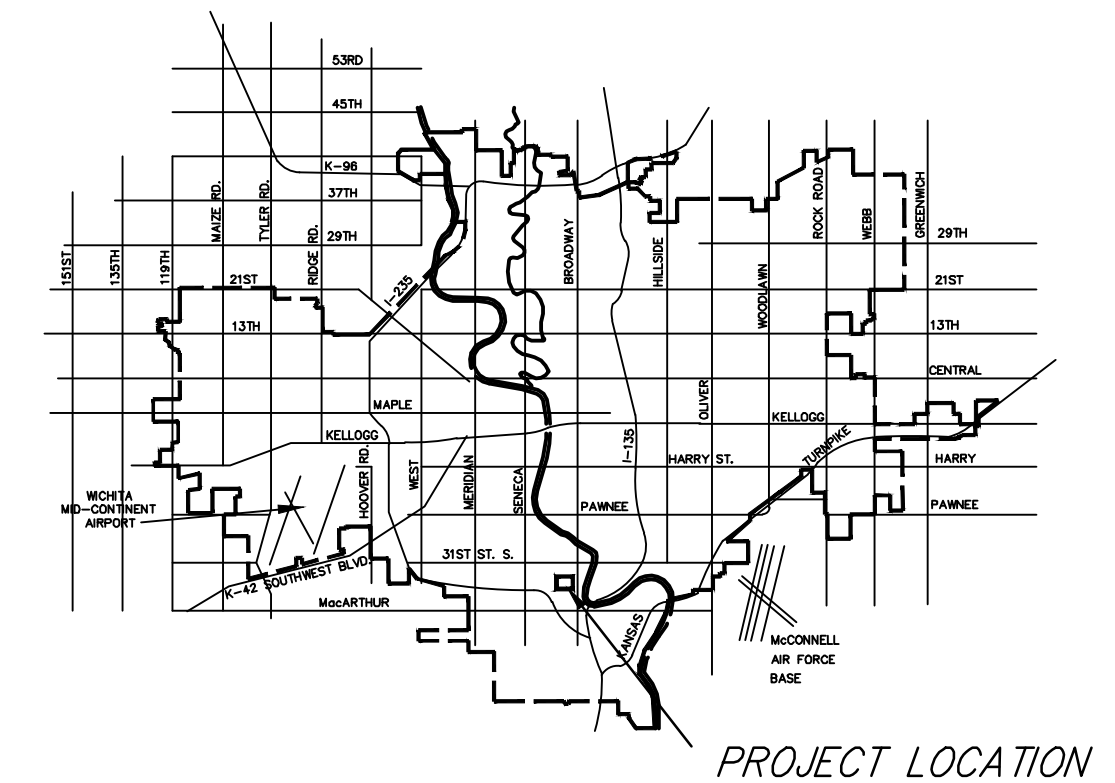



## VICINITY MAP

APPROVED AS NOTED  
 BY CITY ENGINEER OF WICHITA

Sanitary Sewers \_\_\_\_\_  
 Storm Sewers \_\_\_\_\_  
 Driveway Approaches \_\_\_\_\_  
 Water Mains \_\_\_\_\_  
 Paving \_\_\_\_\_

### NOTE TO CONTRACTORS

Inspection and testing for this project are to be provided by a Licensed Consulting Engineering Firm under contract with the Owner/Developer. Said inspection to be in accordance with the City of Wichita standard construction engineering practices and certified by a Licensed Professional Engineer. No work shall be performed in dedicated easements or public right-of-way by the Contractor without such inspection, nor shall any work be commenced without written authorization by the City Engineer.

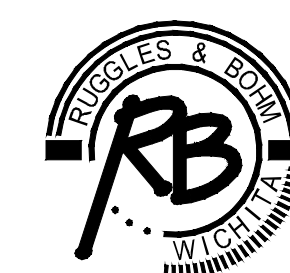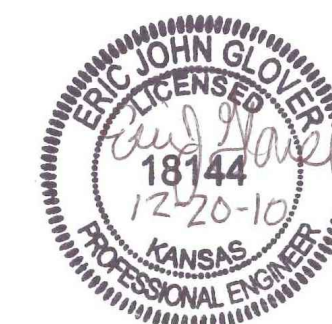

**Ruggles & Bohm, P.A.**  
 Engineering, Surveying, Land Planning  
 924 North Main (316) 264-8008  
 Wichita, Kansas 67203 (316) 264-4621 fax  
 www.rbkansas.com E-mail: info@rbkansas.com