


WATER DISTRIBUTION SYSTEM
BERKELEY SQUARE FIRST ADDITION
HOME BANK & TRUST ADDITION

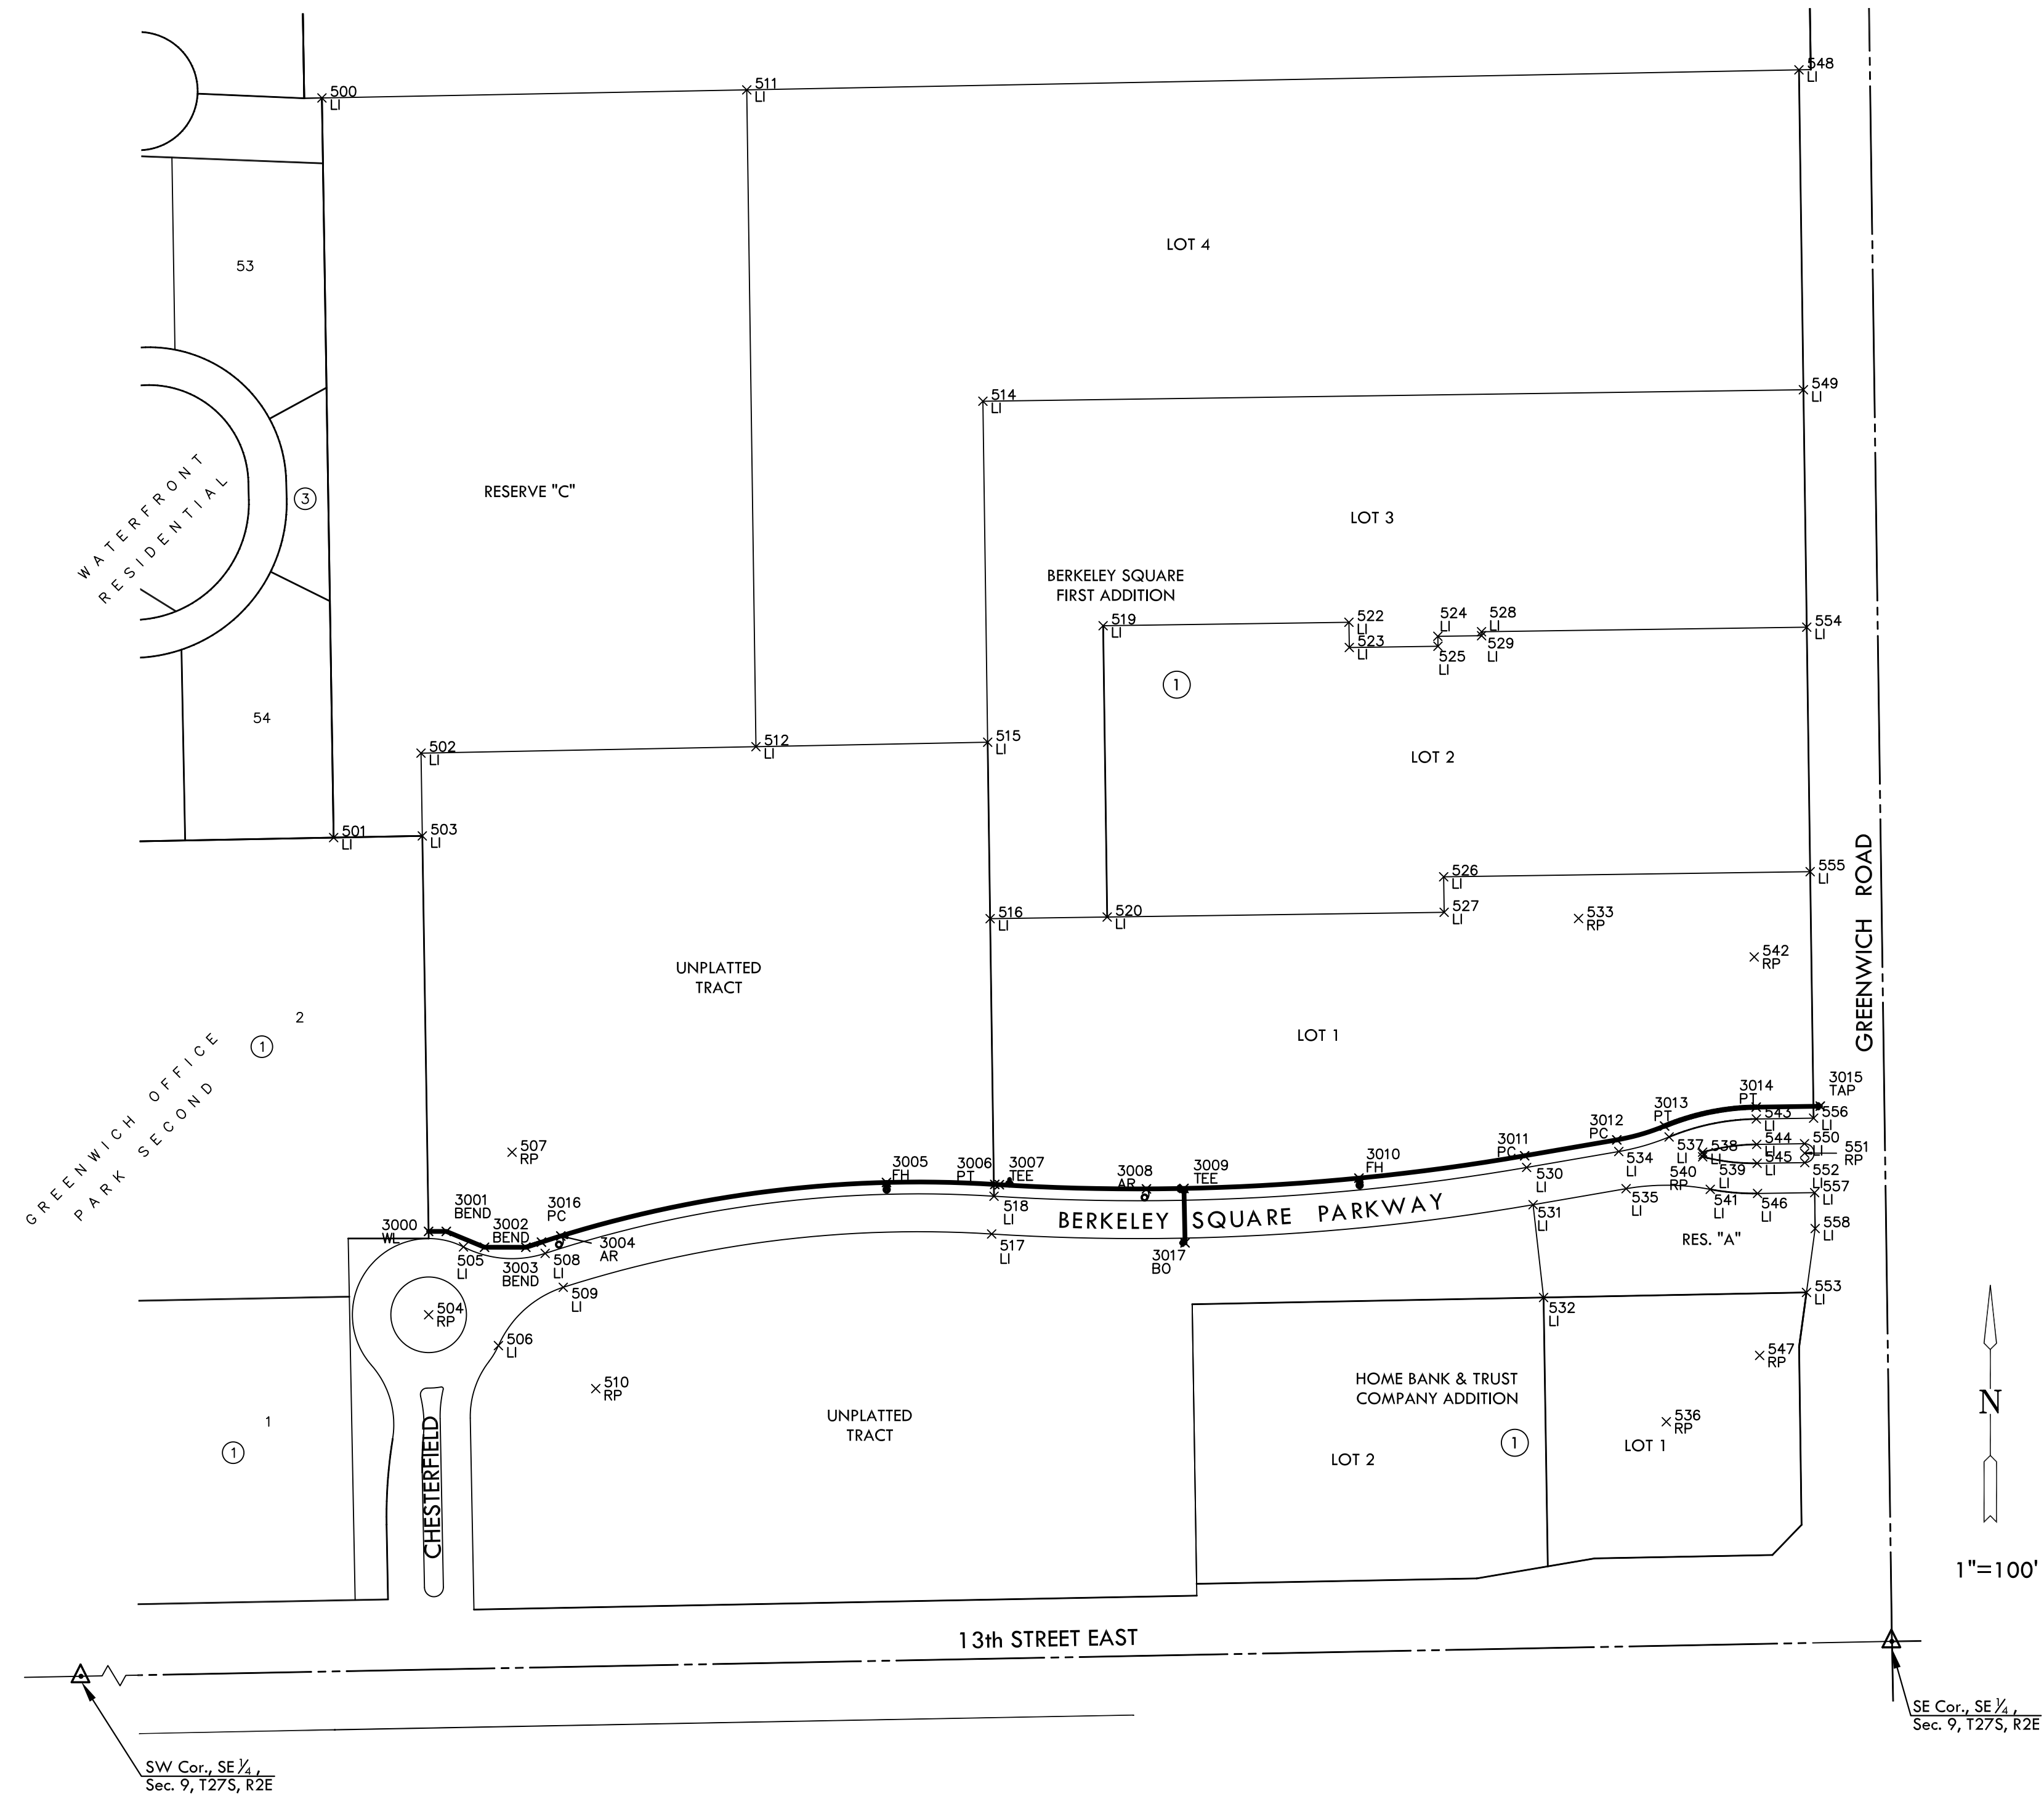

PLAT IRONS			
POINT #	NORTHING	EASTING	DEC.
500	1695784.92	1684965.54	LI
501	1695159.40	1684975.44	LI
502	1695230.84	1685049.31	LI
503	1695160.85	1685050.42	LI
504	1694755.88	1685055.80	RP
505	1694813.26	1685085.25	LI
506	1694729.80	1685114.79	LI
507	1694893.33	1685126.34	RP
508	1694807.79	1685154.31	LI
509	1694779.11	1685169.62	LI
510	1694693.41	1685197.11	RP
511	1695791.76	1685242.81	LI
512	1695236.30	1685332.58	LI
513	1693842.13	1685470.15	RP
514	1695528.45	1685524.51	LI
515	1695240.07	1685528.55	LI
516	1695090.86	1685530.64	LI
517	1694824.19	1685531.91	LI
518	1694856.13	1685533.92	LI
519	1695338.60	1685626.19	LI
520	1695092.25	1685629.64	LI
521	1696787.31	1685655.37	RP
522	1695241.51	1685834.08	LI
523	1695320.18	1685834.38	LI
524	1695329.64	1685909.26	LI
525	1695321.23	1685909.38	LI
526	1695126.26	1685914.19	LI
527	1695096.24	1685914.61	LI
528	1695333.51	1685946.23	LI
529	1695330.16	1685946.28	LI
530	1694880.49	1685984.37	LI
531	1694848.95	1685989.81	LI
532	1694770.48	1685998.69	LI
533	1695091.02	1686028.29	RP
534	1694893.93	1686062.30	LI
535	1694862.52	1686068.47	LI
536	1694665.44	1686102.48	RP
537	1694906.26	1686104.86	LI
538	1694893.36	1686133.21	LI
539	1694889.50	1686133.25	LI
540	1694891.43	1686133.75	RP
541	1694861.95	1686139.66	LI
542	1695058.46	1686176.85	RP
543	1694921.47	1686178.63	LI
544	1694899.98	1686178.93	LI
545	1694893.98	1686179.29	LI
546	1694858.48	1686179.65	LI
547	1694721.49	1686181.43	RP
548	1695808.71	1686214.66	LI
549	1695538.16	1686218.44	LI
550	1694900.54	1686219.37	LI
551	1694892.54	1686219.48	RP
552	1694884.54	1686219.59	LI
553	1694774.77	1686221.04	LI
554	1695337.36	1686221.25	LI
555	1695130.60	1686224.15	LI
556	1694922.15	1686227.07	LI
557	1694859.16	1686227.95	LI
558	1694828.80	1686228.37	LI

WATER POINTS			
POINT #	NORTHING	EASTING	DESC.
3000	1694826.38	1685055.72	WL
3001	1694826.37	1685070.72	BEND
3002	1694812.97	1685103.05	BEND
3003	1694812.97	1685137.97	BEND
3004	1694822.49	1685167.53	AR
3005	1694867.77	1685442.97	FH
3006	1694866.11	1685534.55	PT
3007	1694865.87	1685538.41	TEE
3008	1694862.33	1685662.84	AR
3009	1694862.71	1685694.54	TEE
3010	1694871.43	1685842.55	FH
3011	1694890.34	1685982.67	PC
3012	1694903.79	1686060.60	PC
3013	1694915.49	1686101.03	PT
3014	1694931.47	1686178.49	PT
3015	1694932.34	1686232.68	TAP
3016	1694817.30	1685151.21	PC
3017	1694816.72	1685695.48	BO

BUBBLE MAP
SHEET TITLE
448-90513
PROJECT NUMBER

DFL / KKL / GJA
DESIGNED / DRAWN / CHECKED

ISSUED
July 2011

REVISED

SHEET NO.
5 of 11