
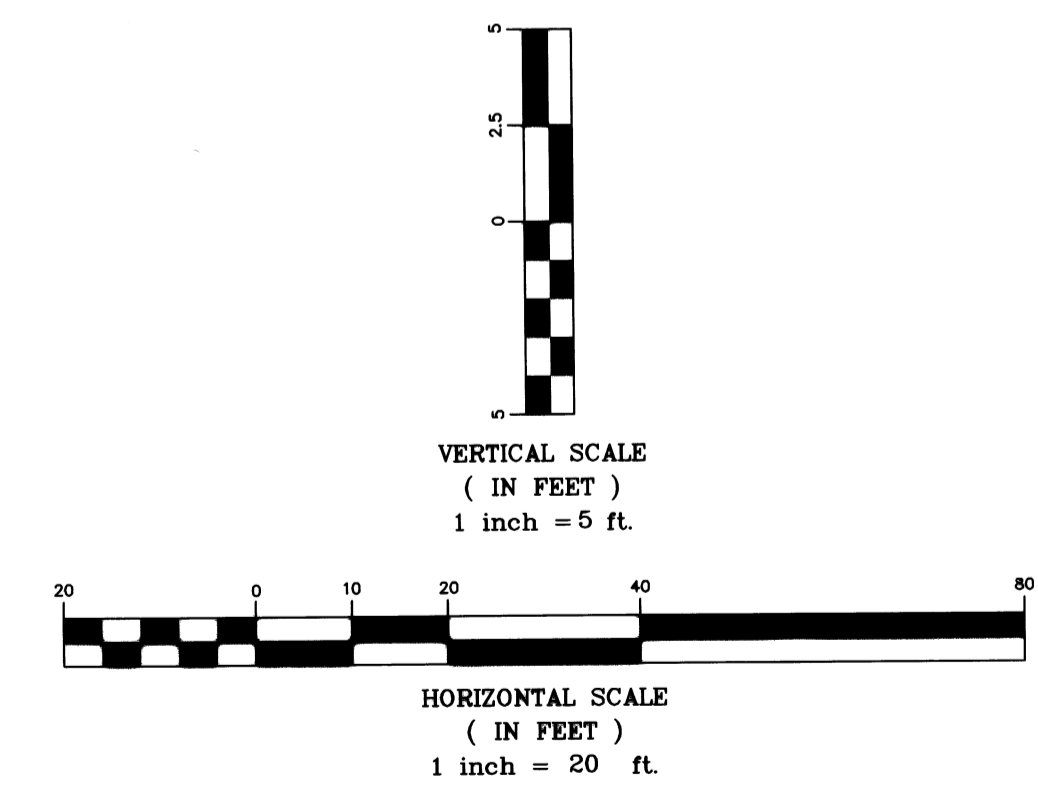


AS BUILTS

Contractor: Fire Protection Services	Project Inspector: Larry Gann
516 S. Market, Wichita, KS 67202 (316)264-0242	

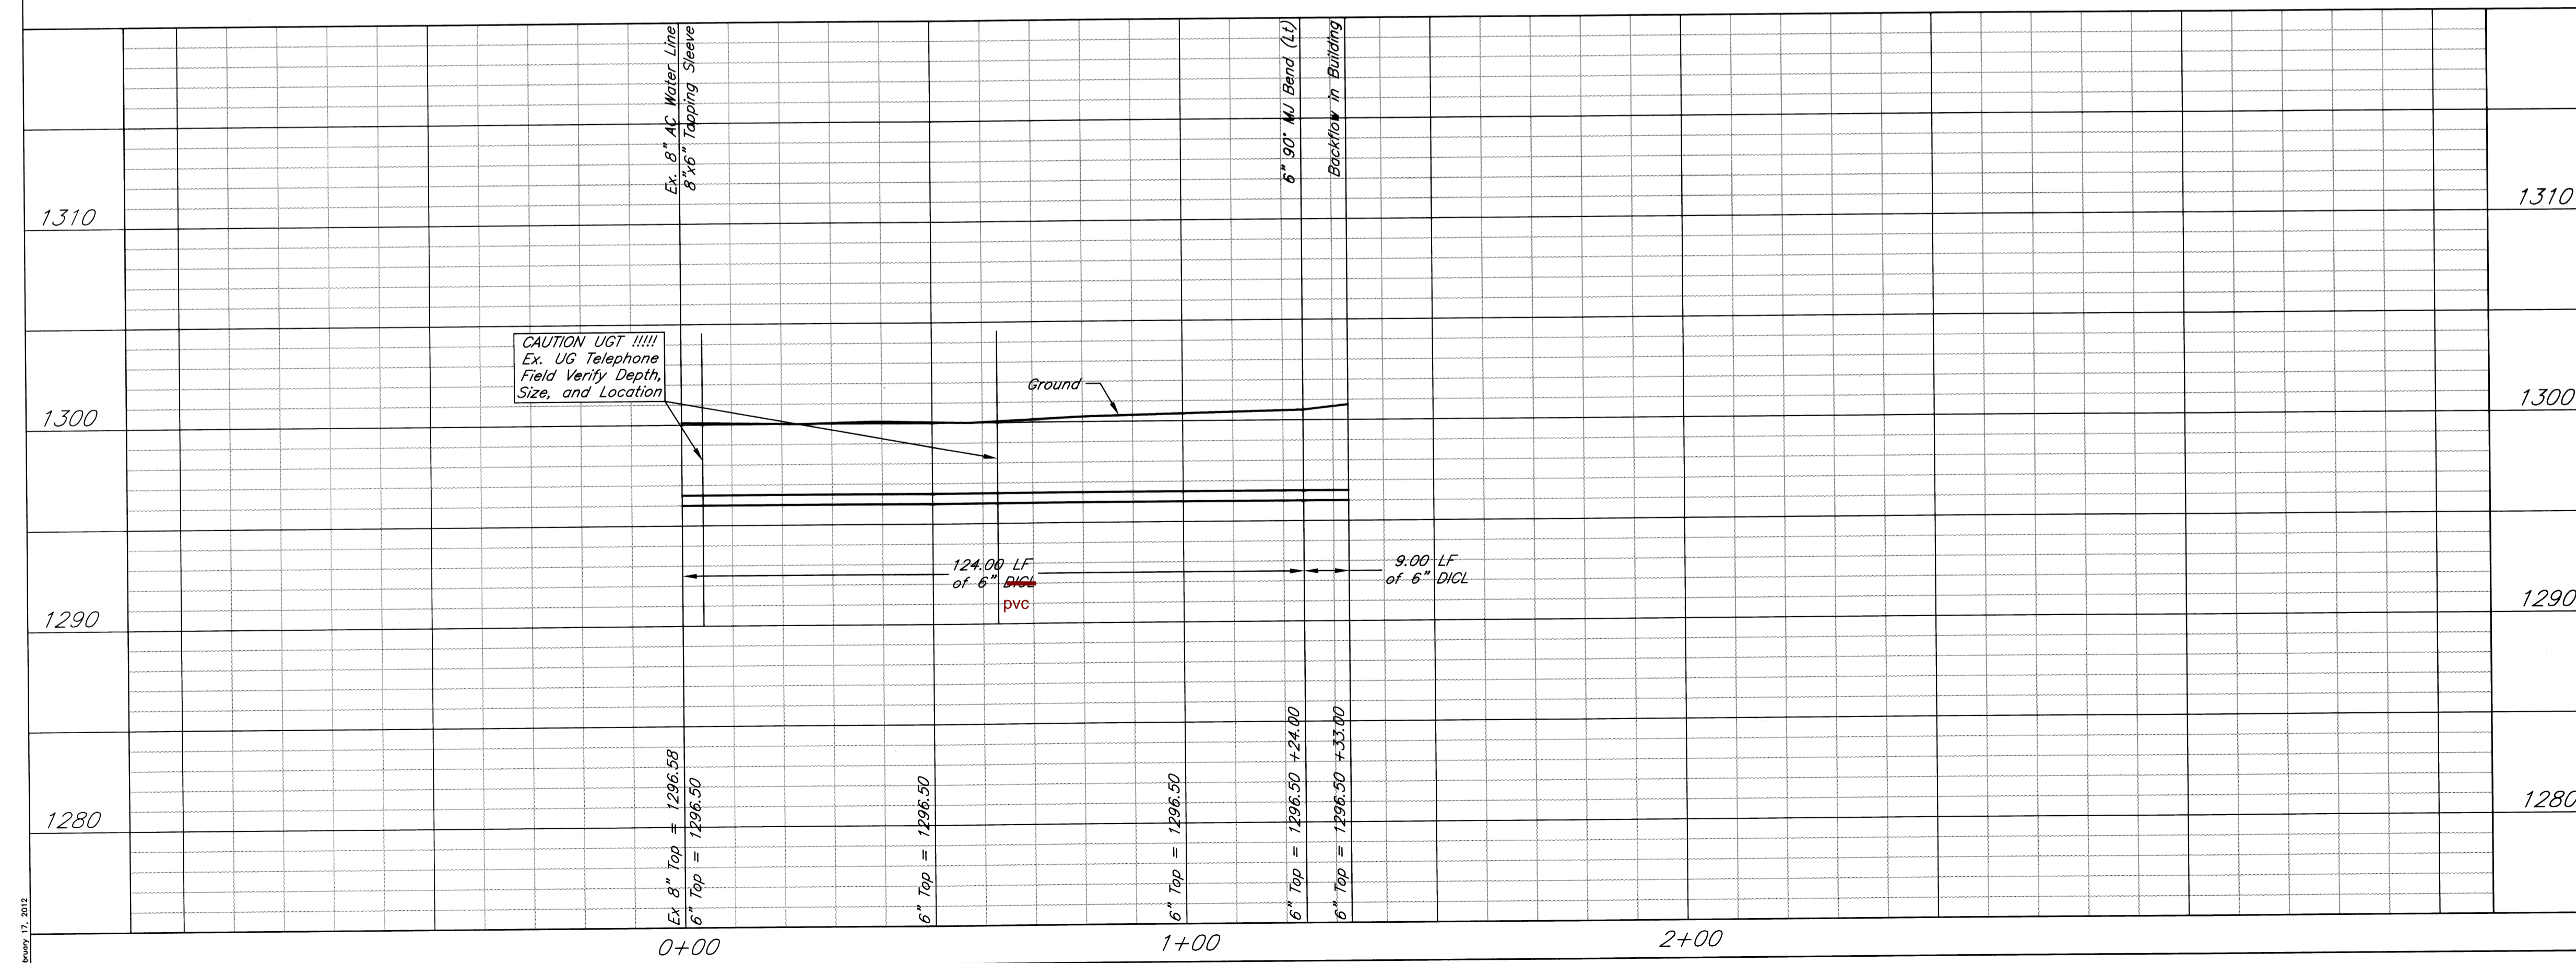

S.B.K. Supply & Millwork Company
Plan & Profile
 Wichita, Kansas

PROJECT NUMBER			
KEM NO. 12021	FILE	DATE 02/16/12	SHEET 2.0
DESIGN KM	DRAWN NS	REVISED	

kemiller engineering logo

516 S. Market, Wichita, KS 67202 (316)264-0242

February 17, 2012