



STORM SEWER 1 PROFILE

STA -0+25 to STA 3+00
SCALE: 1" = 20' H, 1" = 5' V

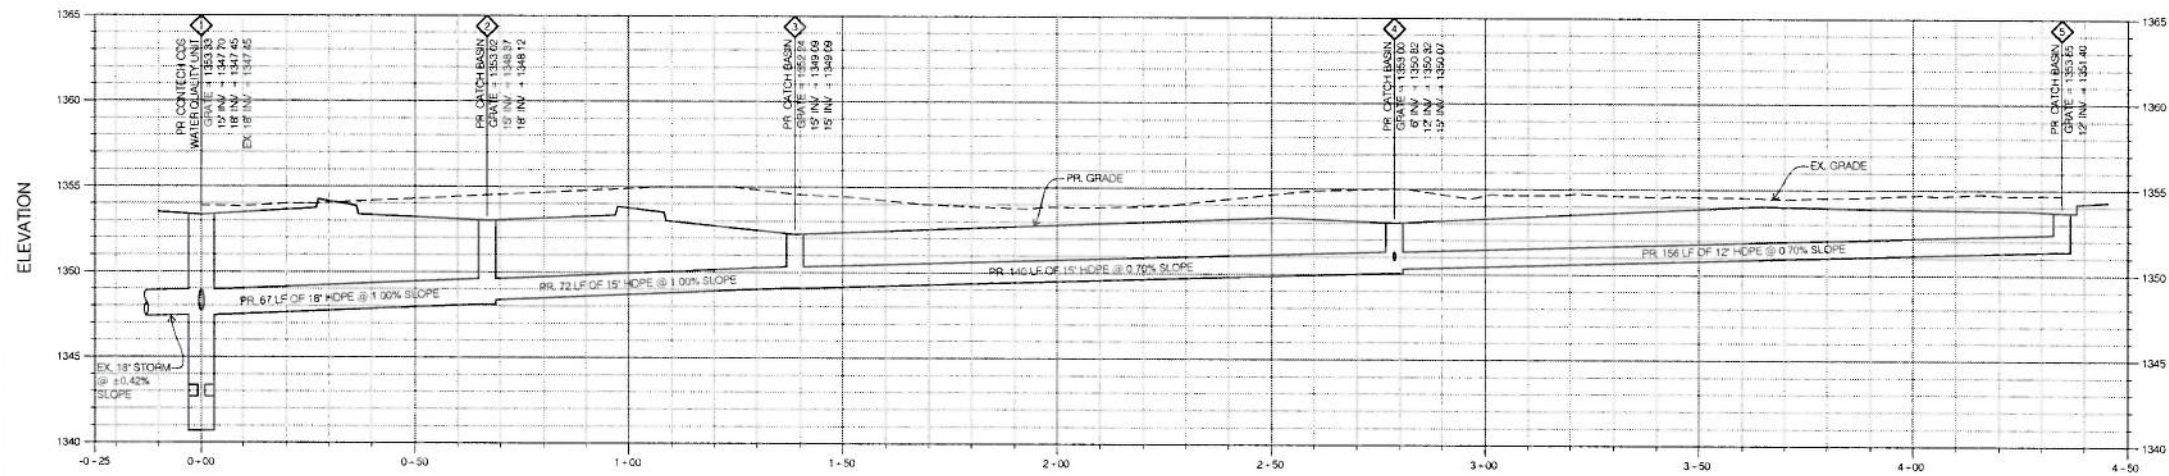

STORM SEWER 2 PROFILE

STA -0+25 to STA 4+50
SCALE: 1" = 20' H, 1" = 5' V

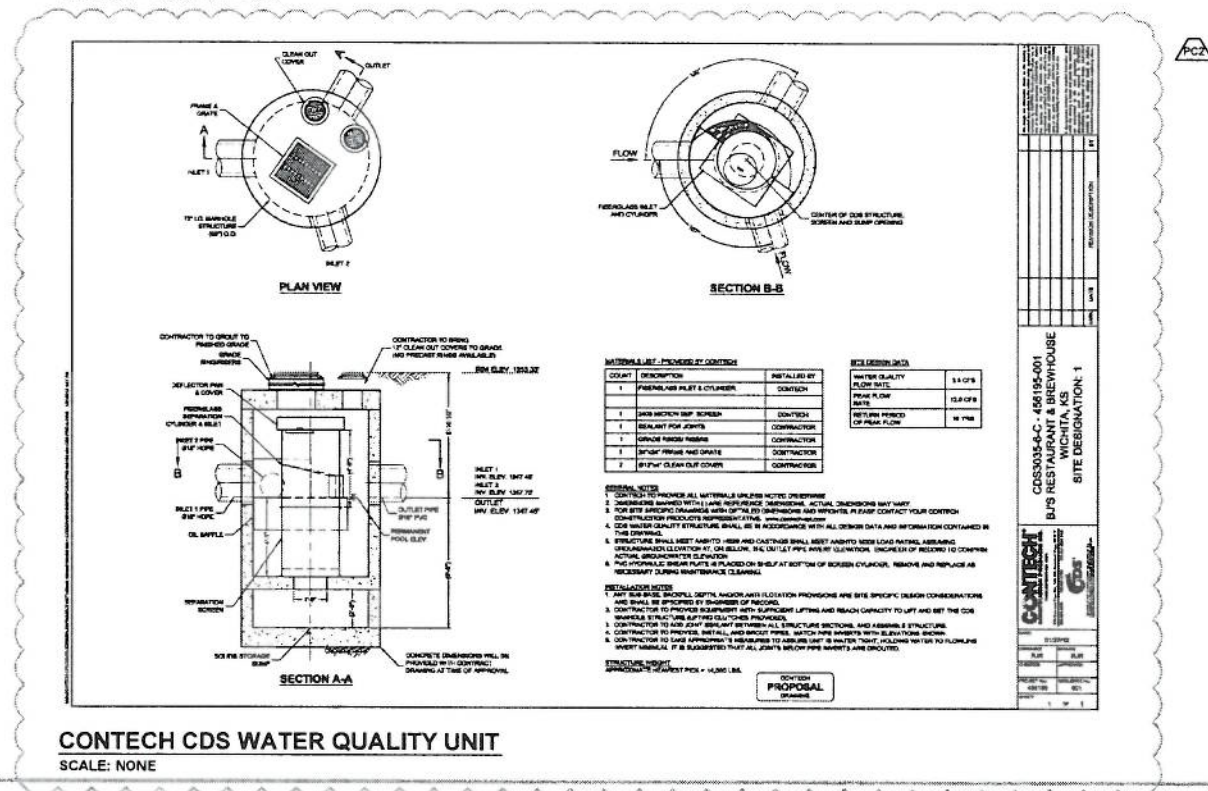

CONTECH CDS WATER QUALITY UNIT
SCALE: NONE

AS BUILT


kemiller
engineering

516 S. Market,
Wichita, KS 67202

(316)264-0242

CALL BEFORE YOU DIG!
KANSAS LAW REQUIRES NOTIFICATION OF THE UNDERGROUND FACILITY OWNER AT LEAST TWO (2) WORKING DAYS BUT NO MORE THAN FIFTEEN (15) CALENDAR DAYS PRIOR TO EXCAVATION OR DEMOLITION

Kansas One-Call
www.kansasonecall.com
1-800-DIG-SAFE

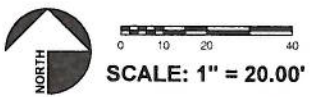

brand : operations : build

7007 DISCOVERY BLVD
DUBLIN, OH 43017
614.634.7000 T
WDPARTNERS.COM

4D PROTOTYPE

BJ'S RESTAURANT & BREWHOUSE
 7960 EAST KELLOGG
 WICHITA, KANSAS 67207



01/30/2012

REVISIONS

NO.	DATE	DESCRIPTION
PC1	12/29/11	
PC2	01/30/12	

WD PROJECT: BJSB0167
PERMIT ISSUE DATE: 11/17/11
HEALTH SUBMITTAL:
BID ISSUE DATE: 12/18/11
CONSTRUCTION SET:

C2.3 STORM SEWER PROFILES