

LATERAL 10, MAIN 14 FOUR MILE CREEK SEWER Sanitary Sewer Extension to serve Lots 1-5, Blk 1, REEDS COVE MEDICAL CAMPUS Proj. 468-84764 O.C.A. 744326

McCullough Excavation - Contractor
J. Westhoff - City Of Wichita, Field Project Engineer
J. Patton - City of Wichita, Inspector
As- built
Release Date: 11/19/2011
pdf: APRos 1/22/2013

GENERAL NOTES

1. Contractor will be required to provide a minimum advance notice of seventy-two (72) hours to utility companies prior to starting any excavation as follows:

Kansas One-Call 687-2470

The Contractor must notify the following in case of an emergency:


| | |
|-----------------------------------|----------------|
| Cox Communications | 260-7204 |
| Kansas Gas Service | 888-482-4950 |
| Westar | 383-8600 |
| AT&T | 1-800-286-8313 |
| City of Wichita Water Department | 262-6000 |
| City of Wichita Sewer Maintenance | 262-6000 |

2. Underground utility service lines and overhead utility pole lines are to be adjusted as necessary by others prior to construction unless the plans specifically call for their adjustment by the Contractor or unless the plans specifically identify a utility to be adjusted by its owner during construction. Existing utilities and their location, as shown on the plans, represent the best information obtainable for design. Location information has been obtained from the various utility companies and is either from company record drawings or company-provided field locations. The Contractor will be required to work around existing utilities within the right-of-way which do not conflict with proposed construction.

3. Rubble from the removal of miscellaneous structures and excess excavation which is to be wasted shall be disposed of on sites to be provided by the Contractor. These sites shall be approved by the Engineer as to suitability, appearance and site location. Locations that, in the opinion of the Engineer, will leave an unsightly appearance will not be approved.

4. All disposal sites must be approved by the Kansas Department of Health and Environment. Material either stockpiled or disposed of in a flood plain would require a Kansas State Board of Agriculture permit. Any material dumped in waters of the United States or wetlands is subject to U.S. Corps permitting regulations. Any material buried or stockpiled beyond approved of Engineers construction limits would require additional archeological investigations unless buried in a previously approved borrow location.

5. The Contractor shall give all property owners and/or tenants of developed property directly abutting the construction of this project a minimum of ten (10) days advance notice prior to start of construction.

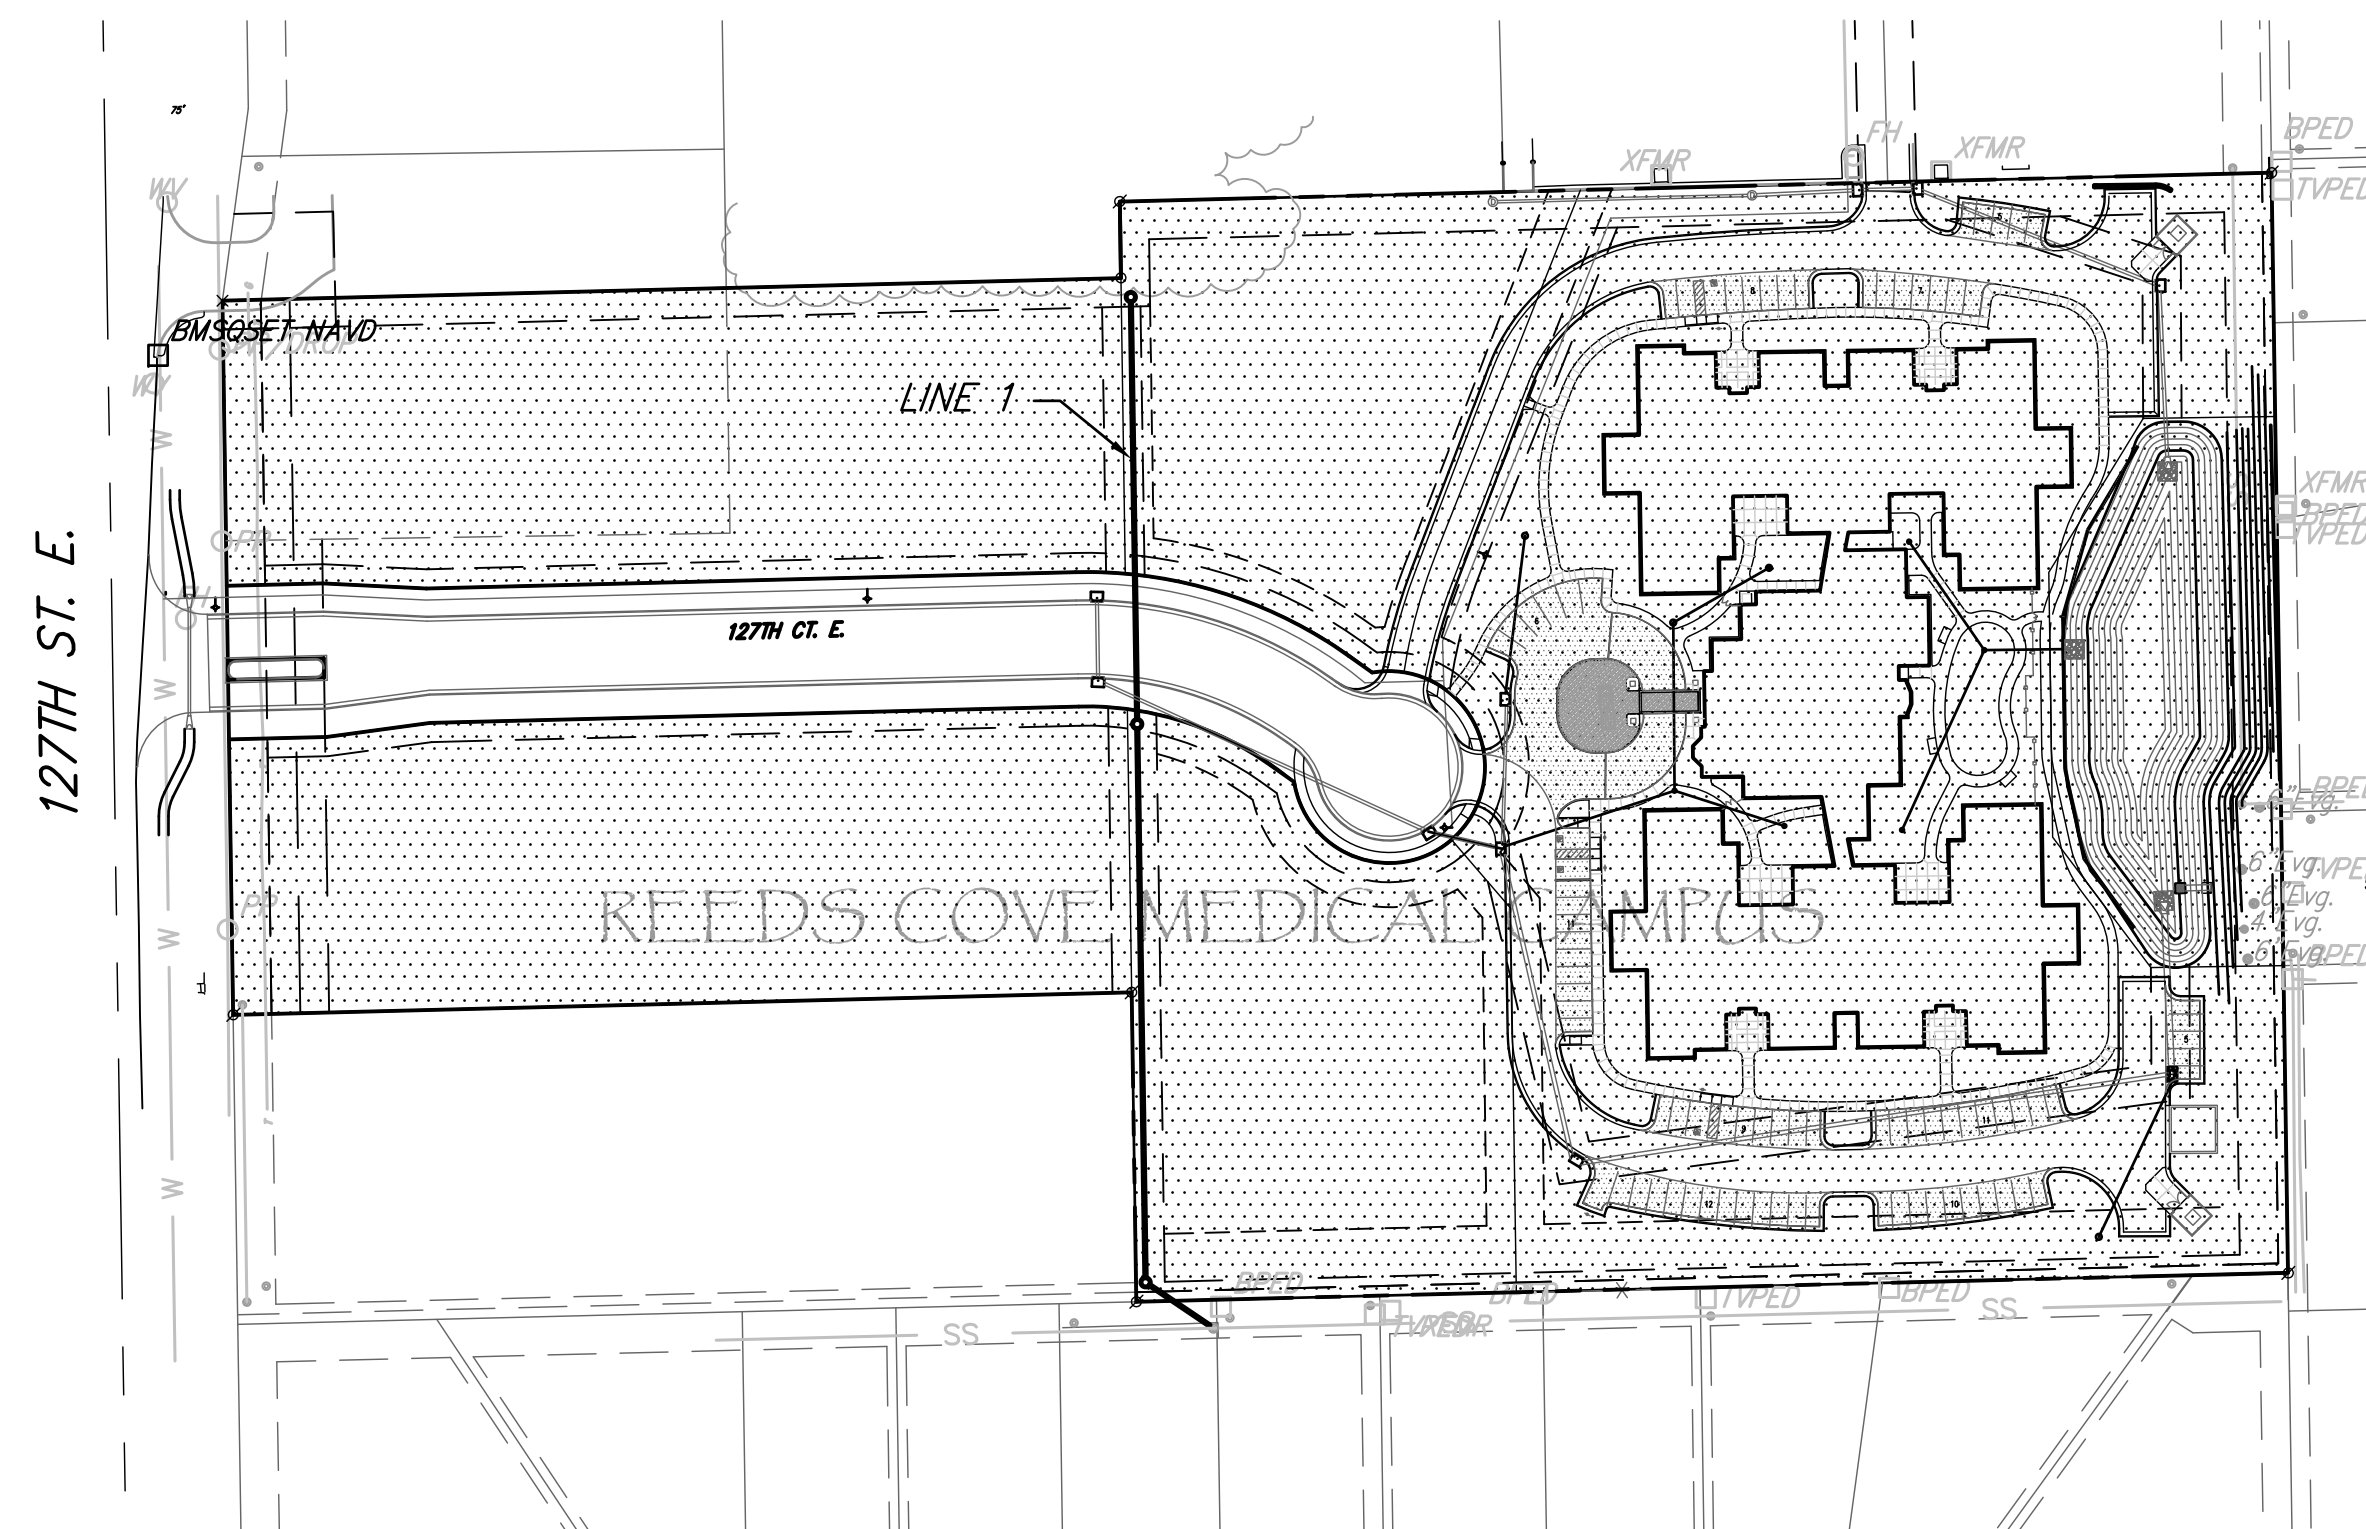

1" = 100'

BENCH MARKS

BENCH MARK #1: SQ. CUT TC concrete drive E side of 127th, 375' S & 25' E of NW Cor Sec 11, 27S, R2E Elev. 1381.07

INDEX OF SHEETS

1. TITLE SHEET
2. LINE 1 PLAN/PROFILE
3. RING AND COVER DETAILS
4. MANHOLE DETAILS
- 5-9. BMP DETAILS
11. COORDINATE MAP
11. REEDS COVE MEDICAL CAMPUS PLAT

