


**SANITARY SEWER PLANS**  
**BERKELEY SQUARE FIRST ADDITION**  
**HOME BANK & TRUST ADDITION**

**LINES 2 & 3**  
SHEET TITLE  
468-84731  
PROJECT NUMBER

DFL / KKL / GJA  
DESIGNED / DRAWN / CHECKED




ISSUED  
July 2011  
REVISED

SHEET NO.  
5 of 12

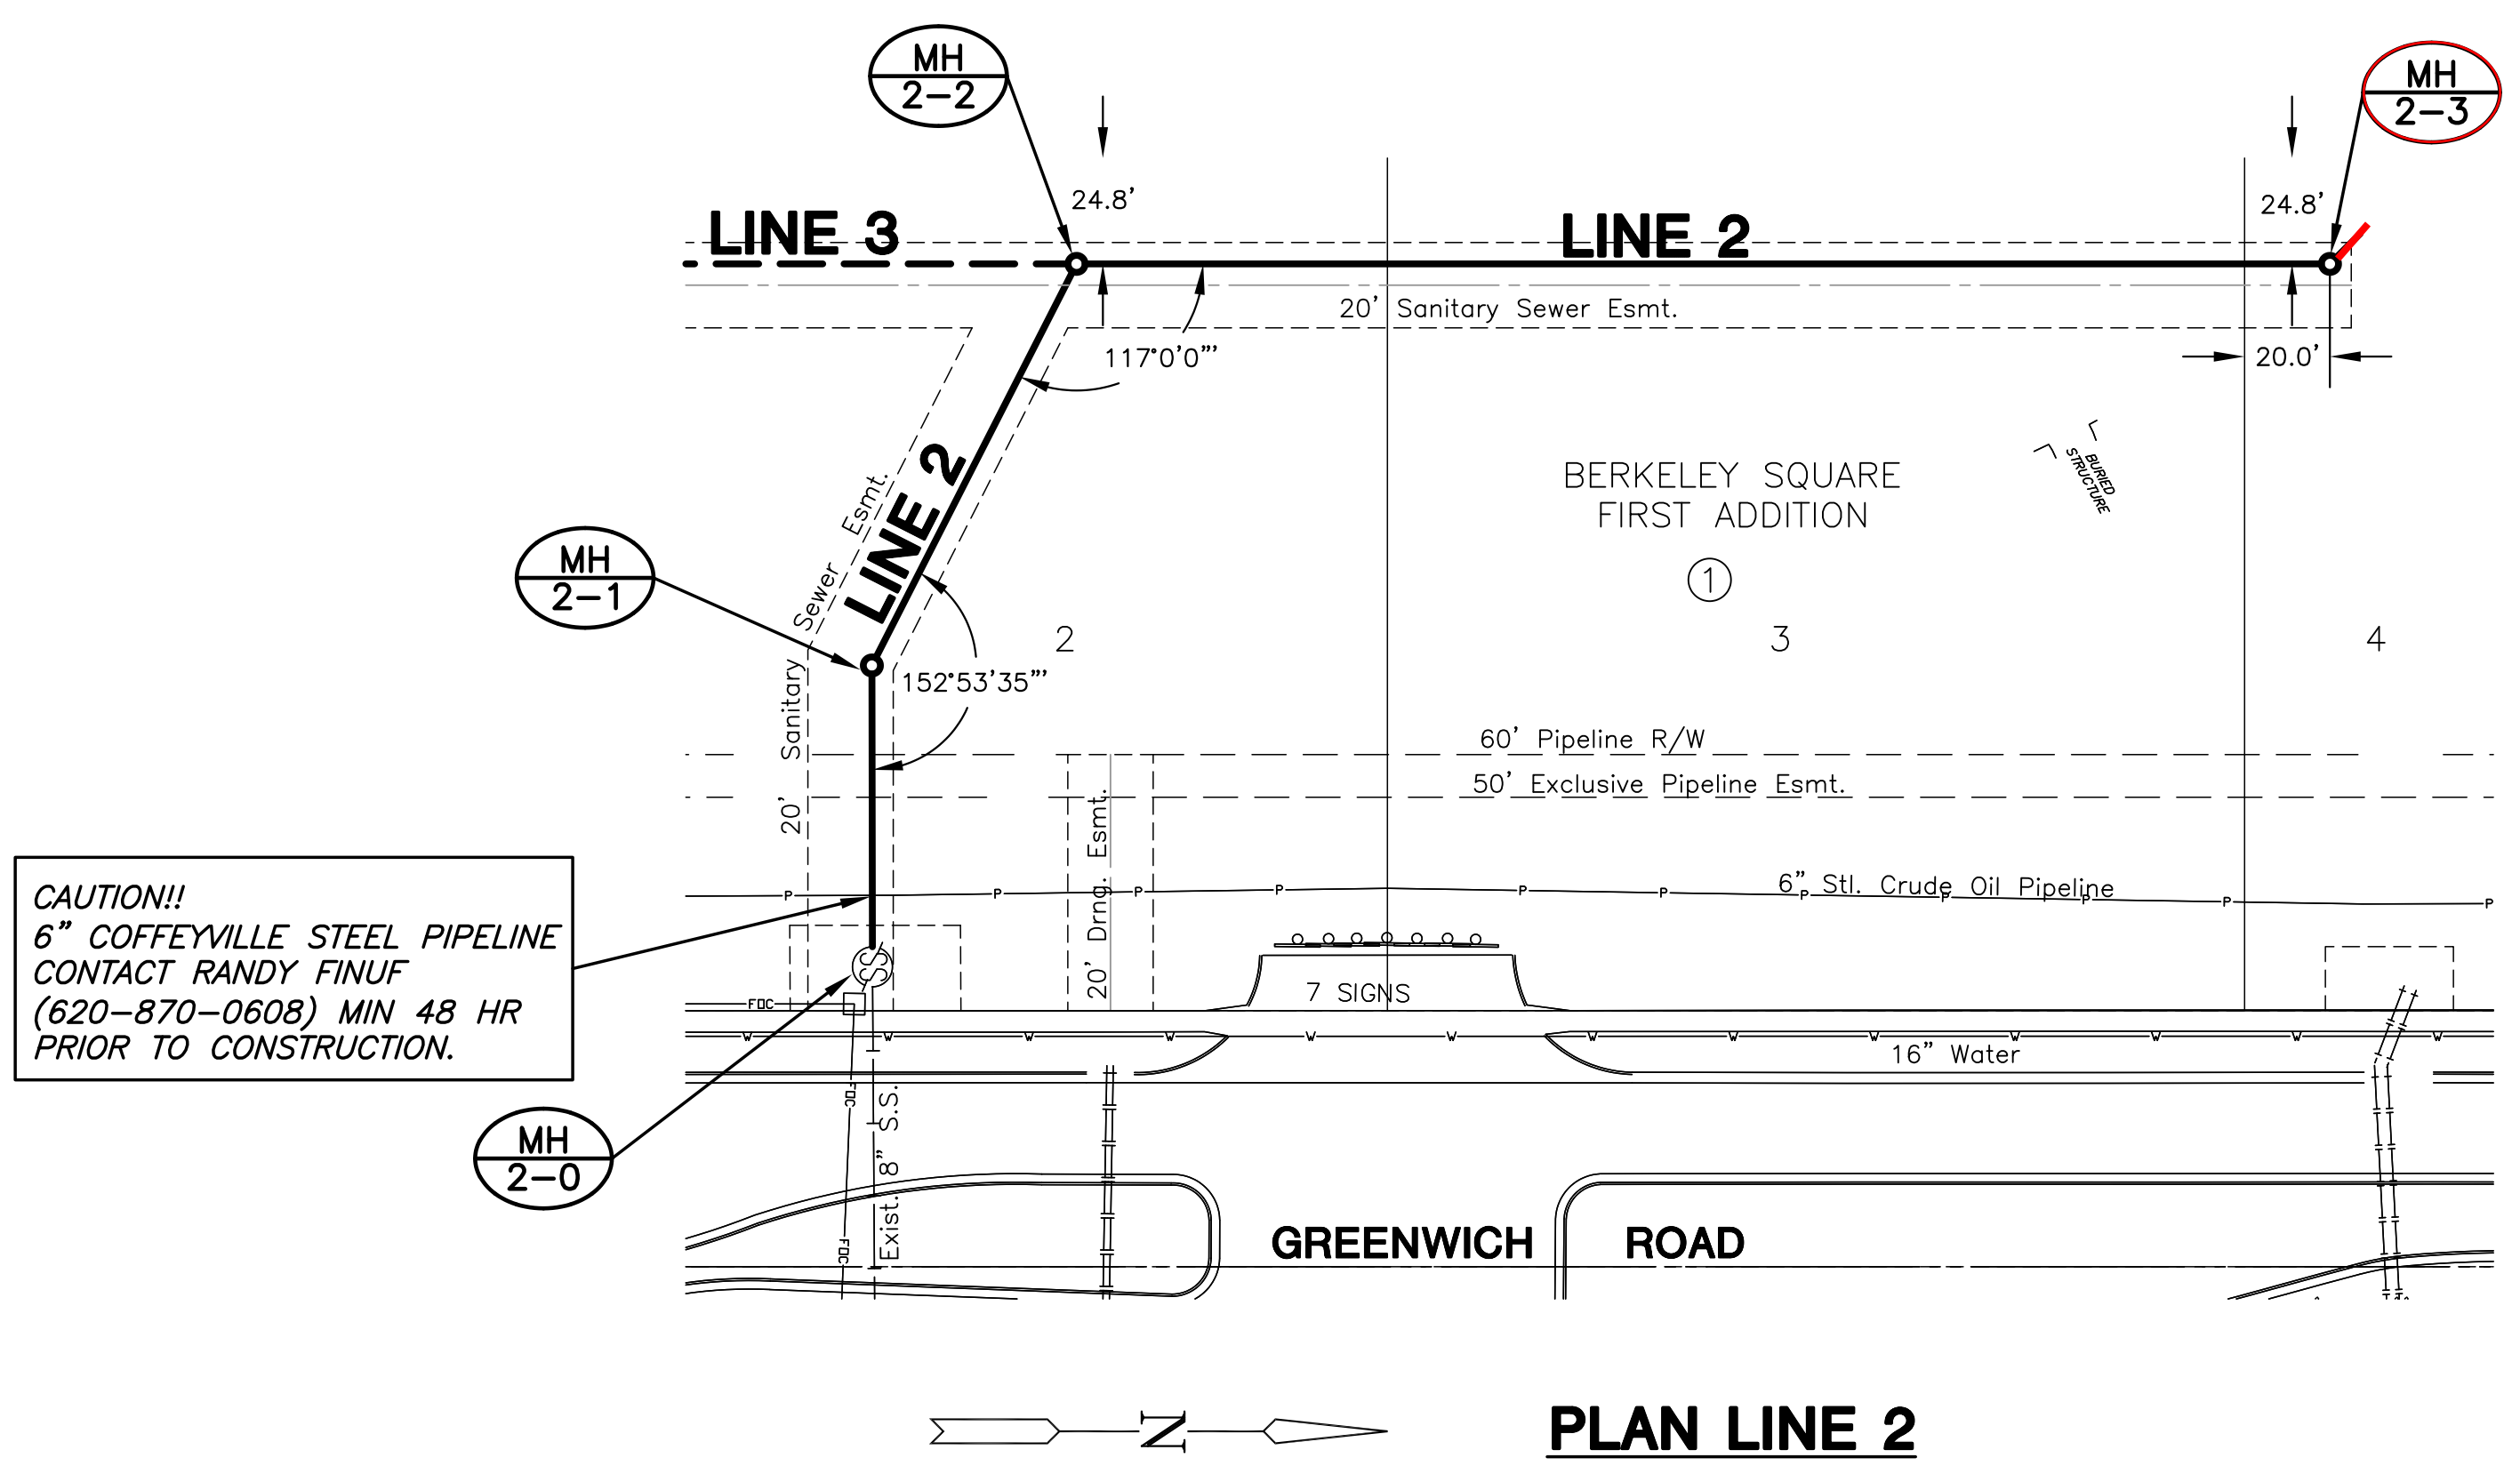

**CAUTION!!**  
6" COFFEYVILLE STEEL PIPELINE  
CONTACT RANDY FINUF  
(620-870-0608) MIN 48 HR  
PRIOR TO CONSTRUCTION.

- NOTES:**
1. LINES 2 & 3 SHALL BE BACKFILLED WITH SAND AND FLUSHED.
  2. CONTRACTOR TO VERIFY LOCATION & DEPTH OF EXISTING UTILITIES PRIOR TO CONSTRUCTION.

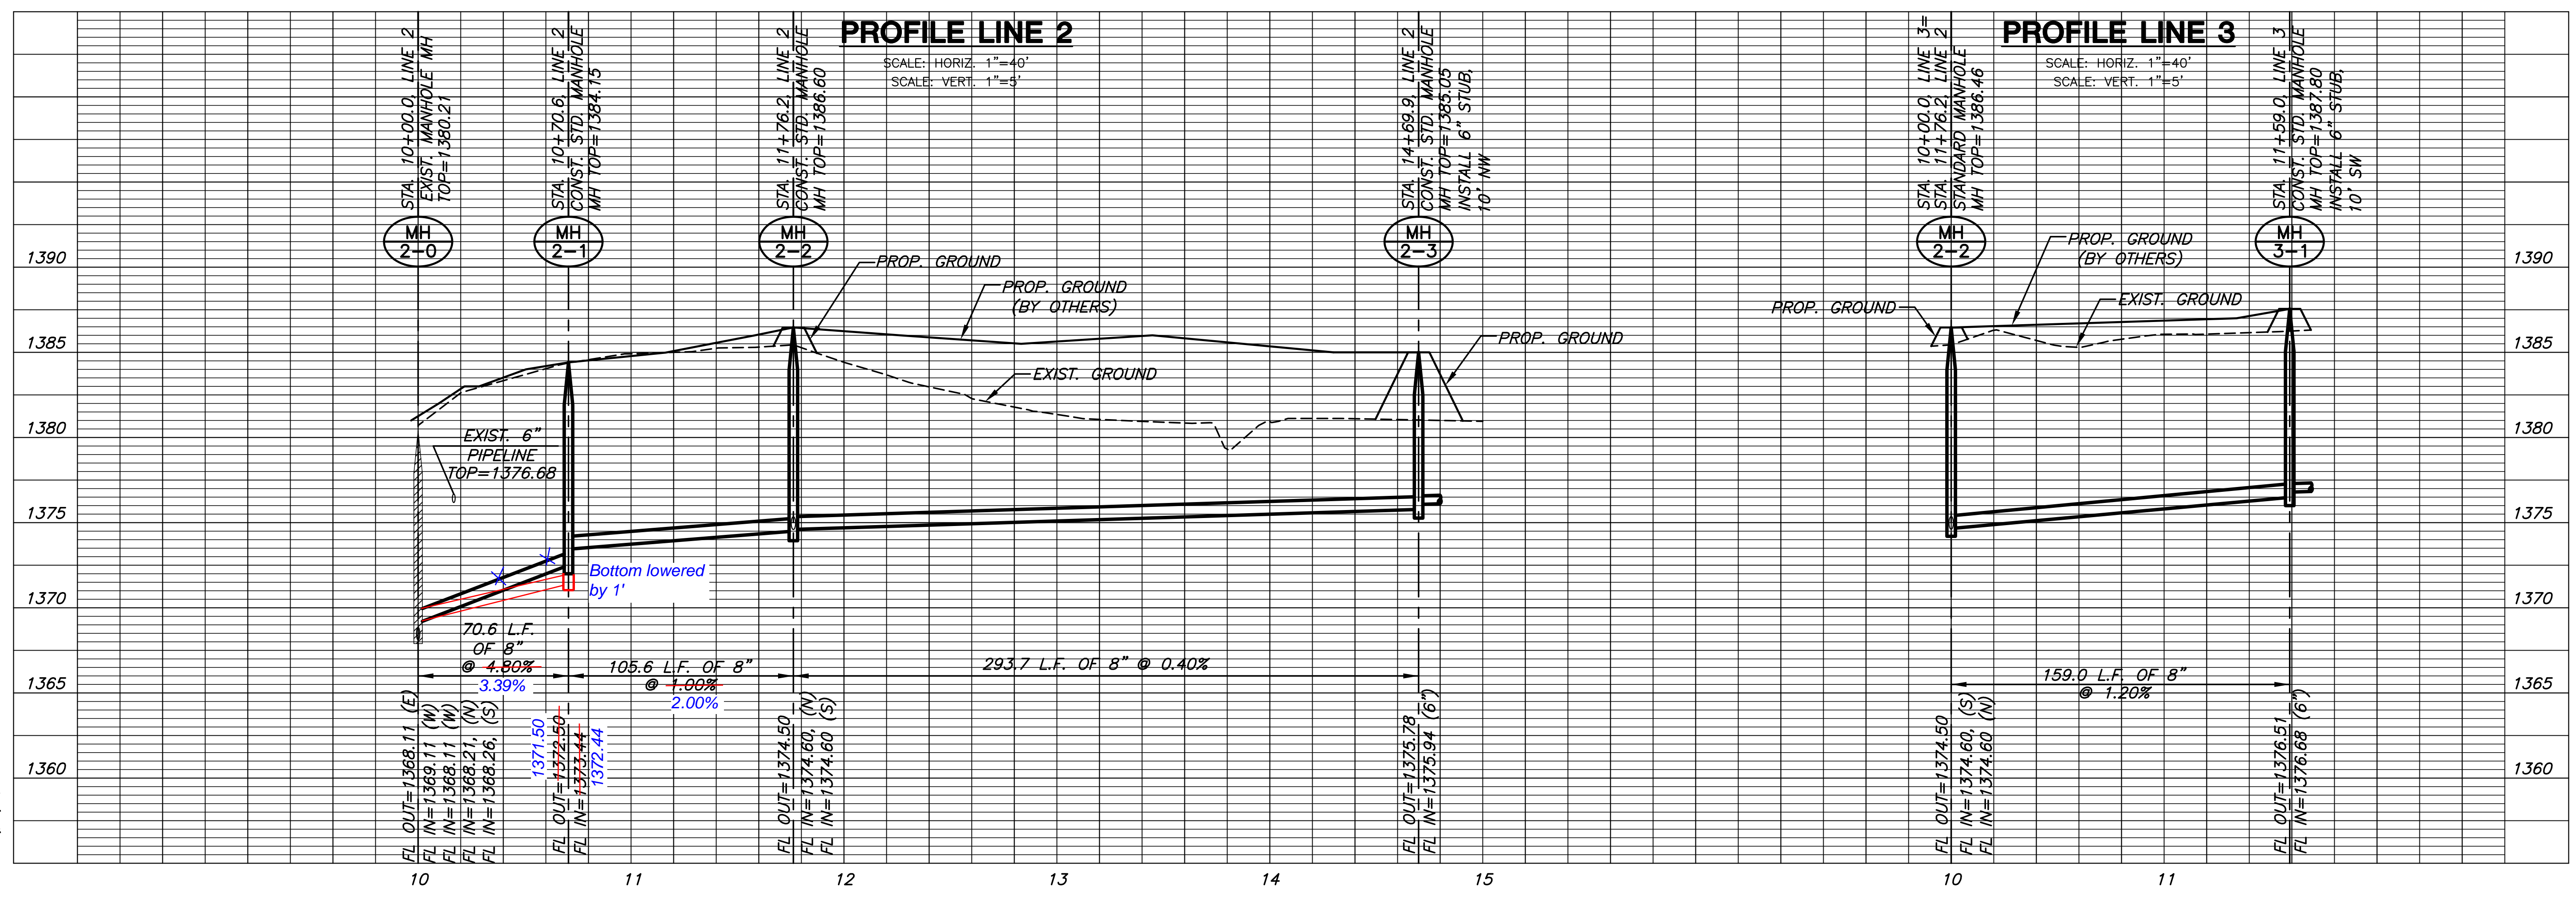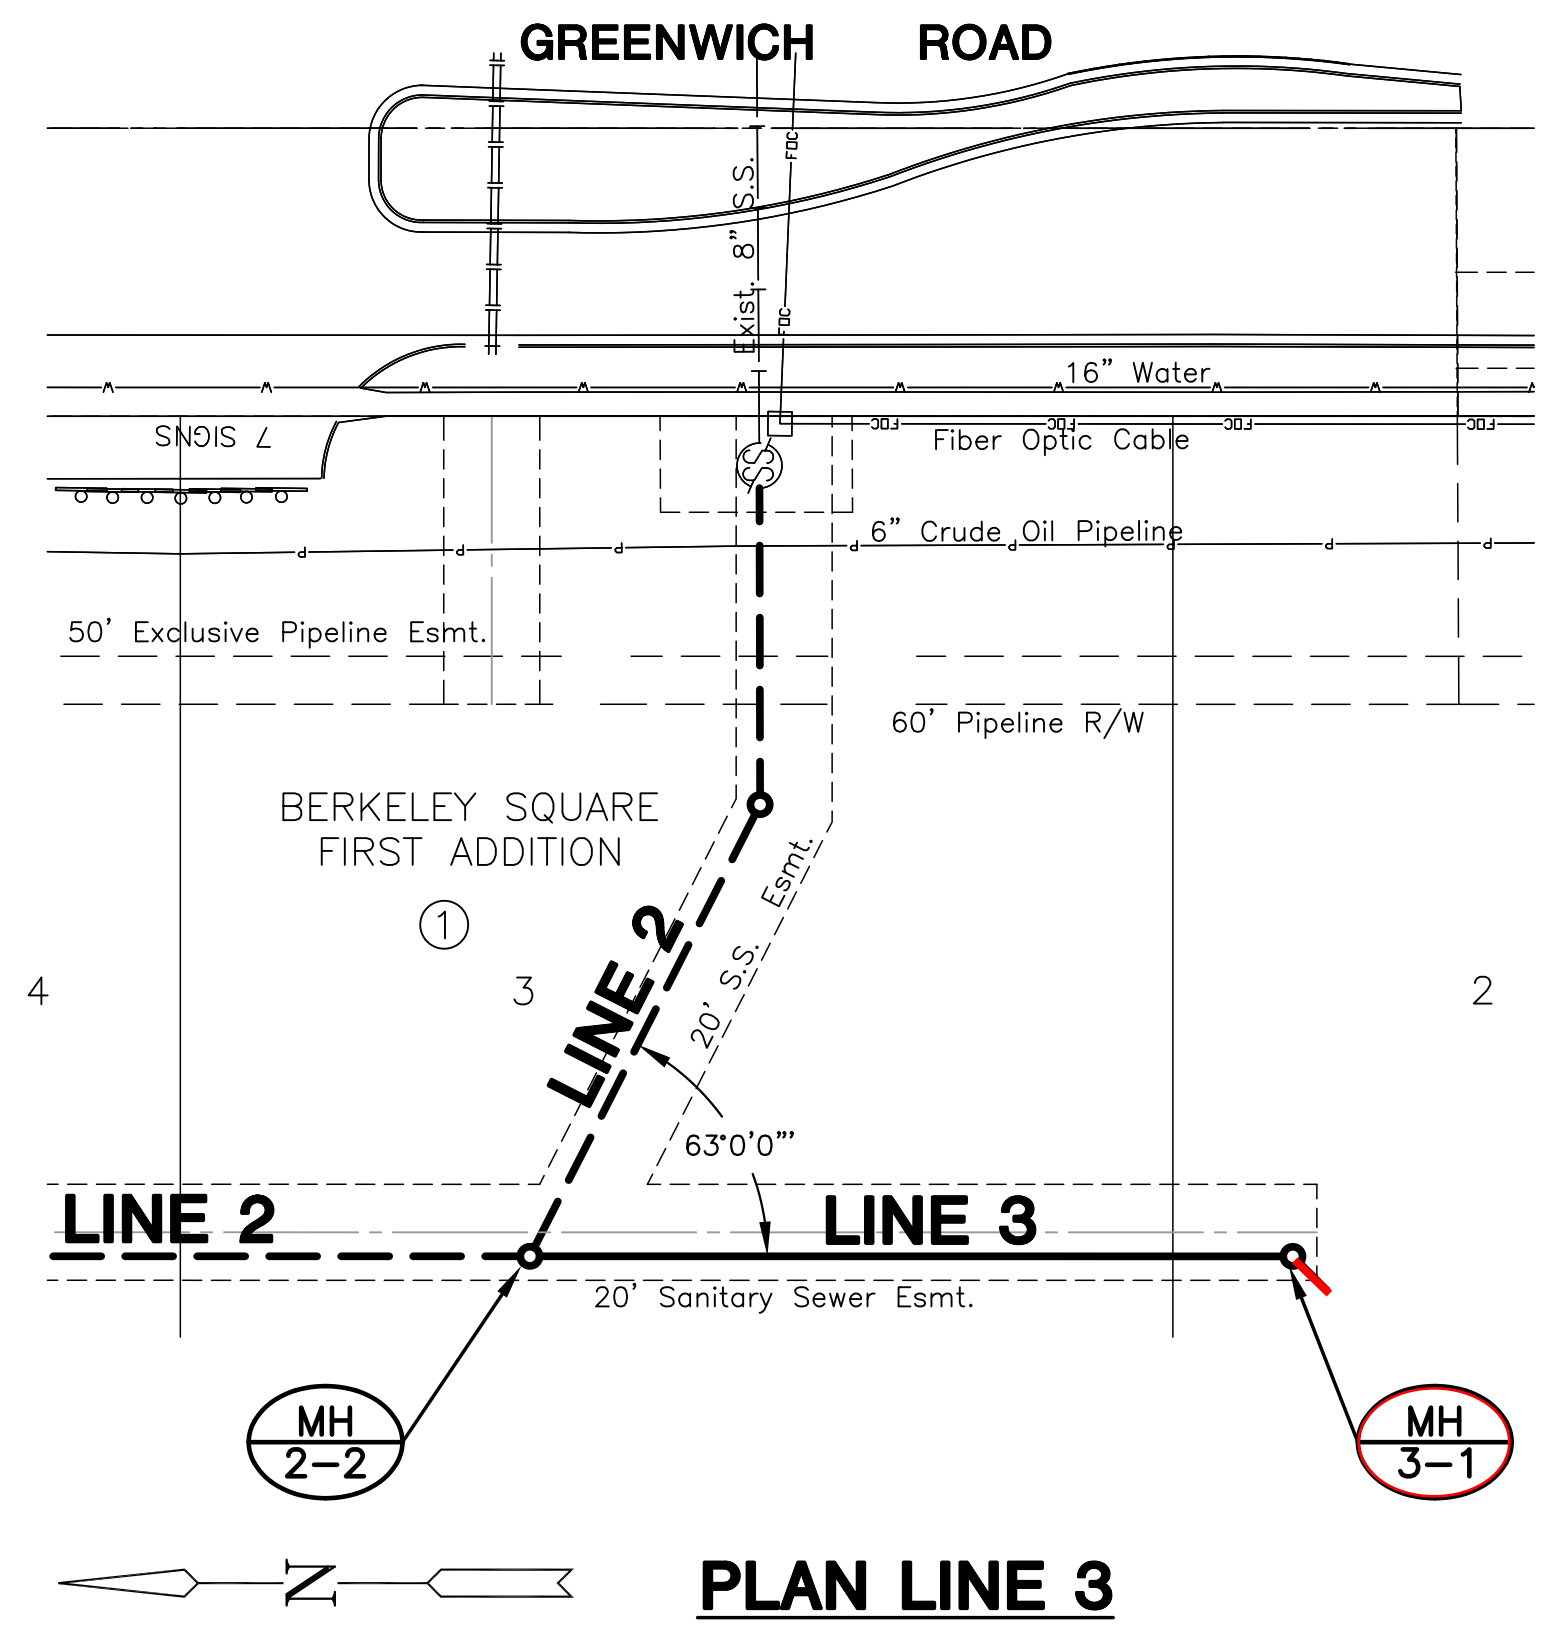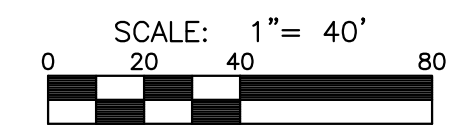

PLOT DATE: Thursday, July 05, 2011 @ 11:24AM

J:\CIVIL\10572 - BERKELEY SQUARE.DWG\SAN\10572\_B2.DWG