

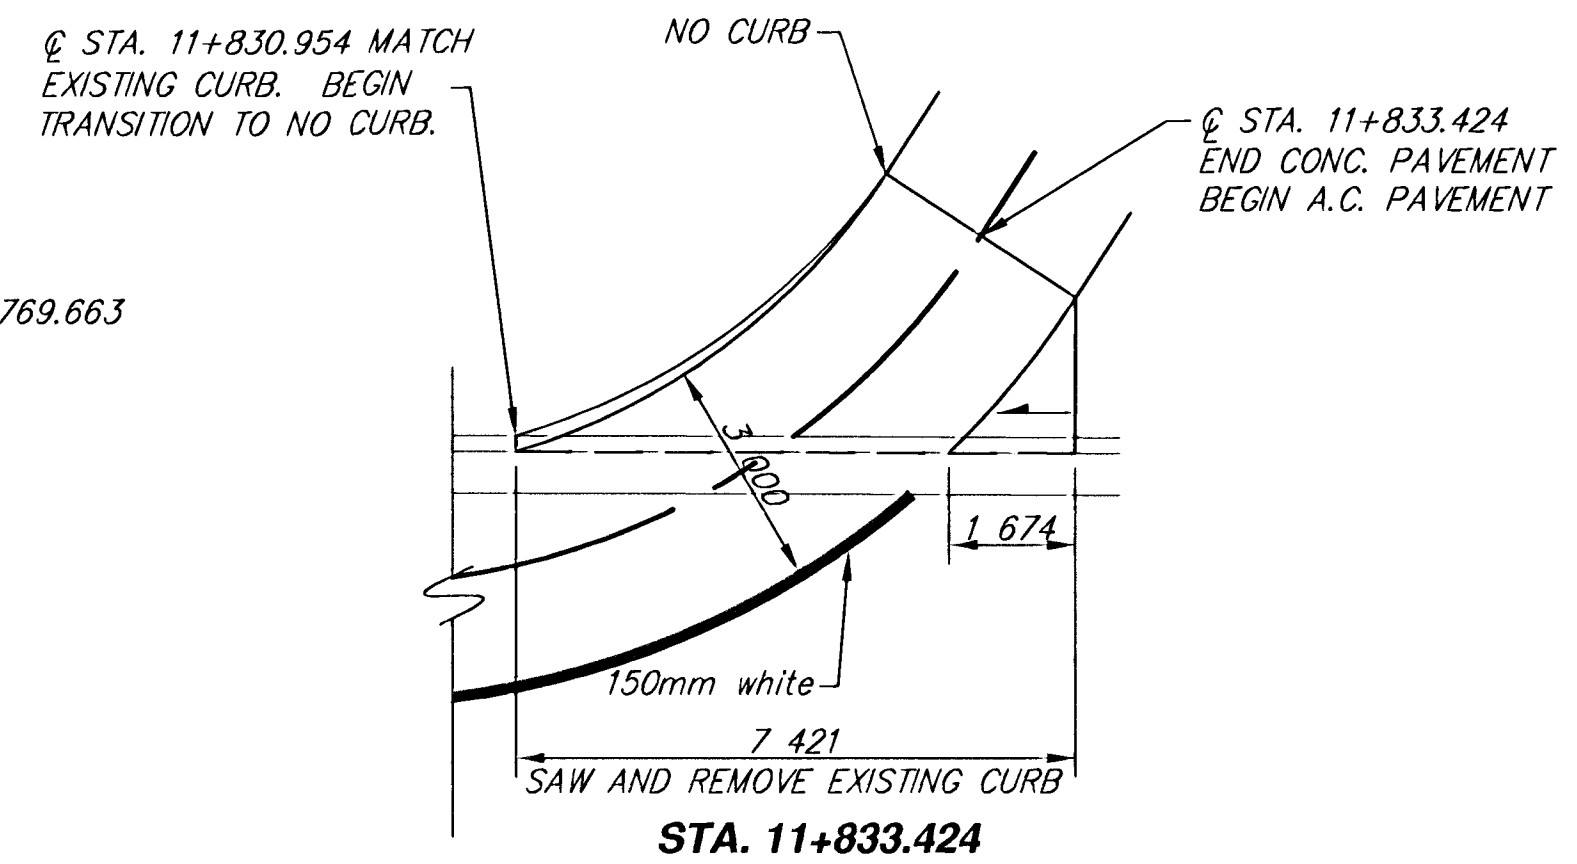


FHWA REGION NO.	STATE	PROJECT NUMBER	FISCAL YEAR	SHEET NUMBER	TOTAL SHEETS
7	KANSAS	871E-0115-01	1997	34	49

DATE	BY	REFERENCES NOTED	REFERENCES CHECKED

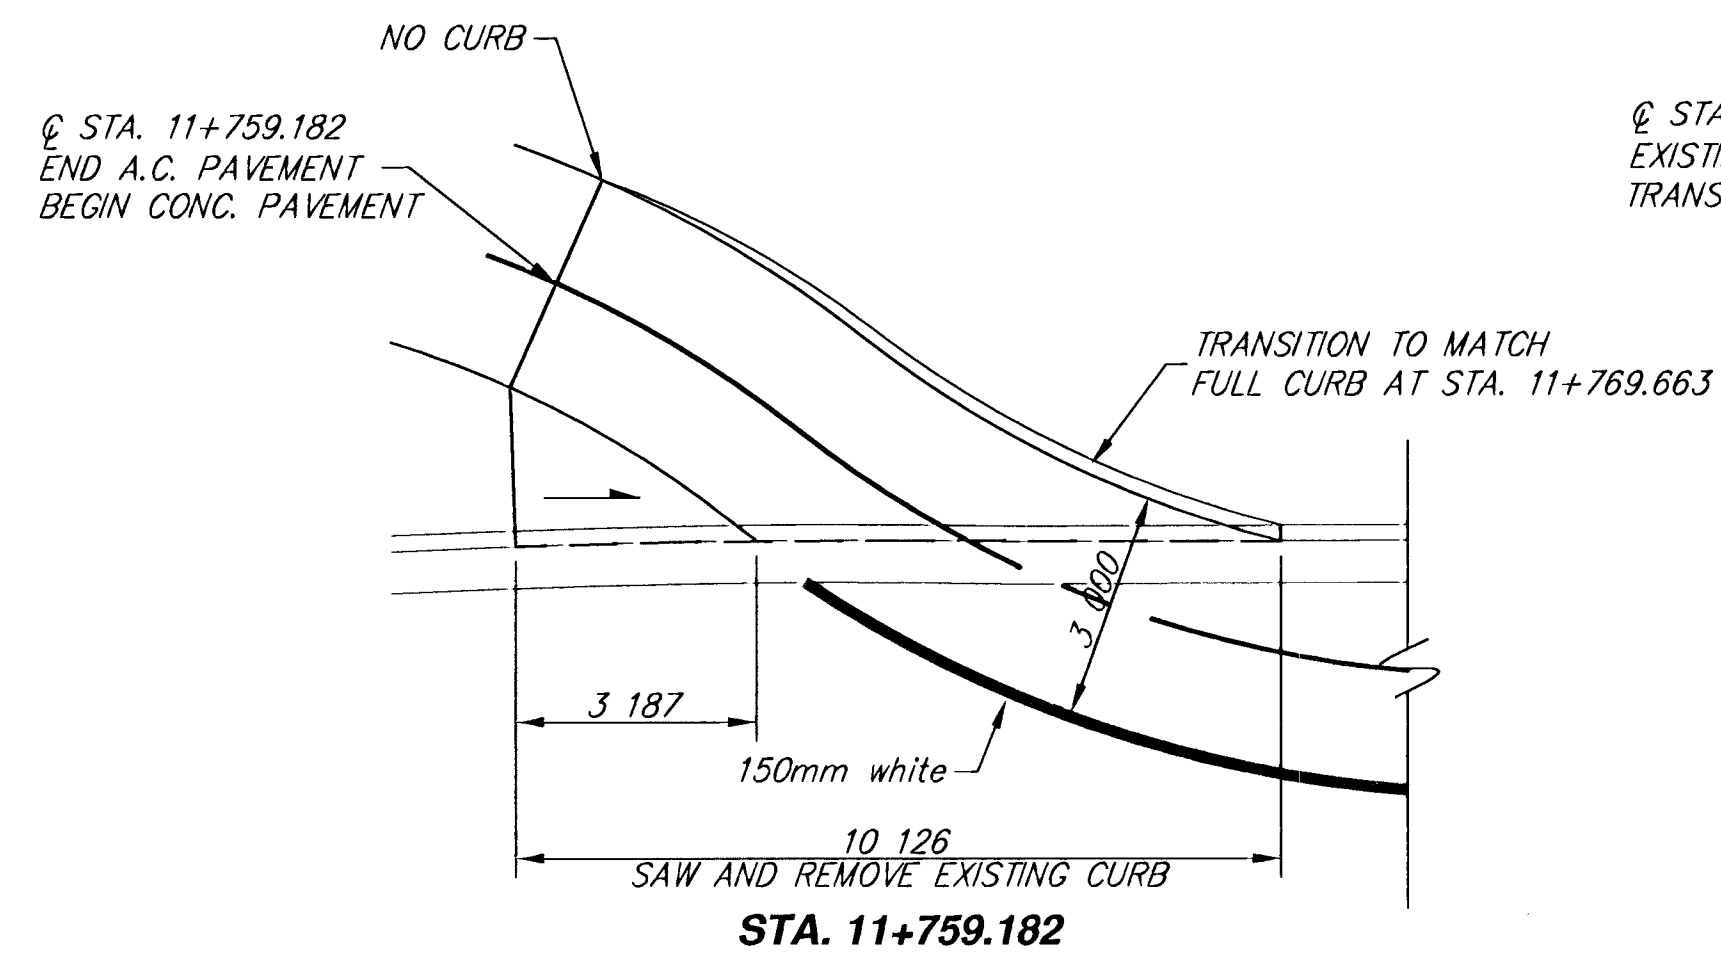

SPECIAL RAMPS

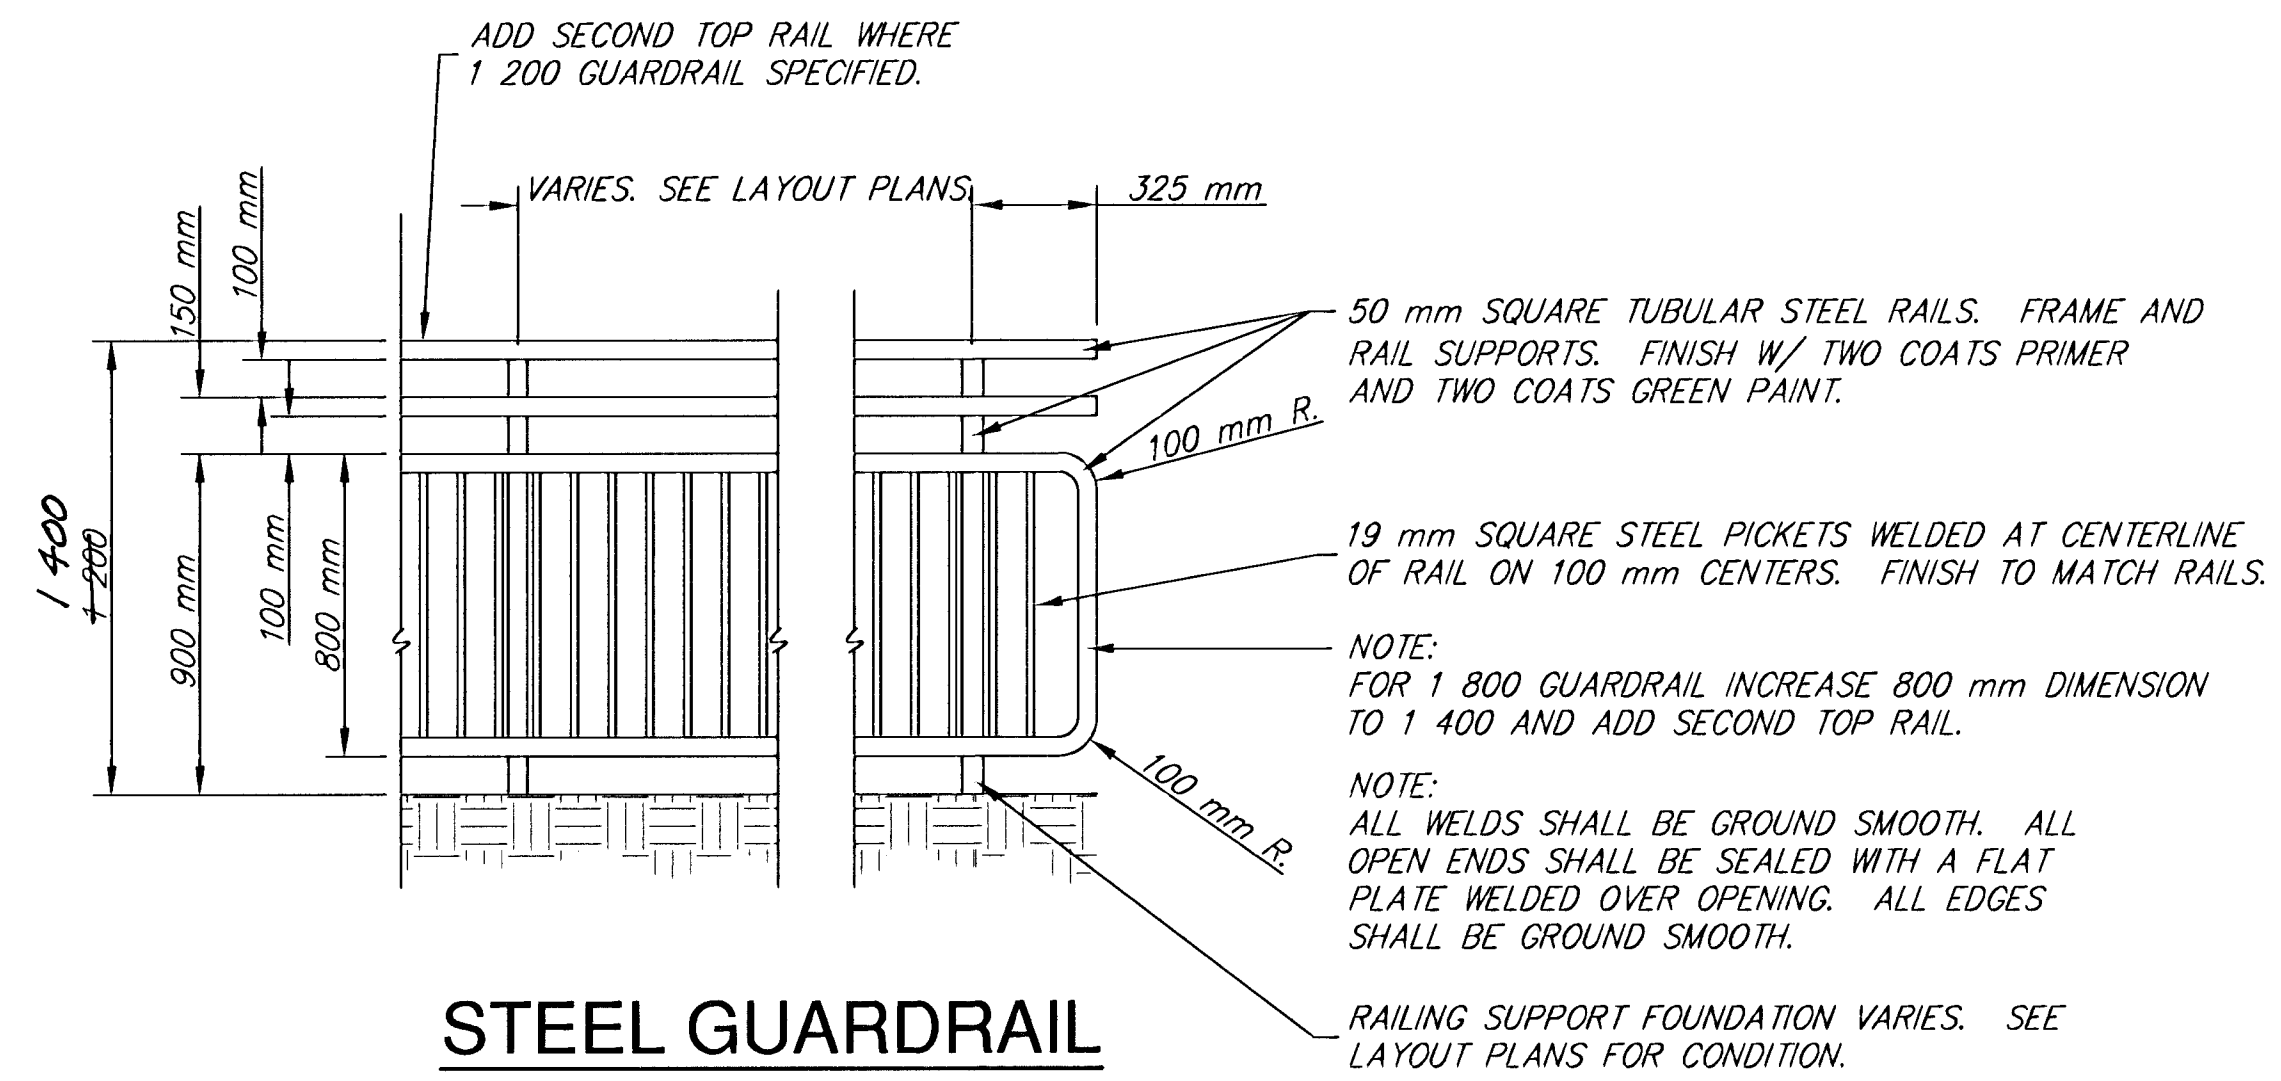

K96 BIKEPATH MISCELLANEOUS DETAILS					
	924 NORTH MAIN WICHITA, KANSAS 67203 www.srb1.com		316-264-8008 FAX 264-4621 E-MAIL: wj@srb1.com		REVISED
	SAVOY, RUGGLES & BOHM, P. A. ENGINEERING & SURVEYING				Misc Details 34 49
	PROJECT NUMBER .				
DRAWN	DESIGN	REVIEW	DATE	UTILITY	SRB JOB
JTS	T.C.R.		June 27, 2001		1554T