


WATER VALVE BOX ELEVATIONS			
STREET	STATION	OFFSET	PROPOSED ELEVATION
BRONCO	79+88.80	23.00' RL	210.7
BRONCO	81+94.80	21.70' RL	211.5
BRONCO	83+91.62	23.00' RL	209.0
BRONCO	84+00.55	23.00' RL	209.1
BRONCO	85+40.09	23.00' RL	208.9

SCALE: 1" = 20'

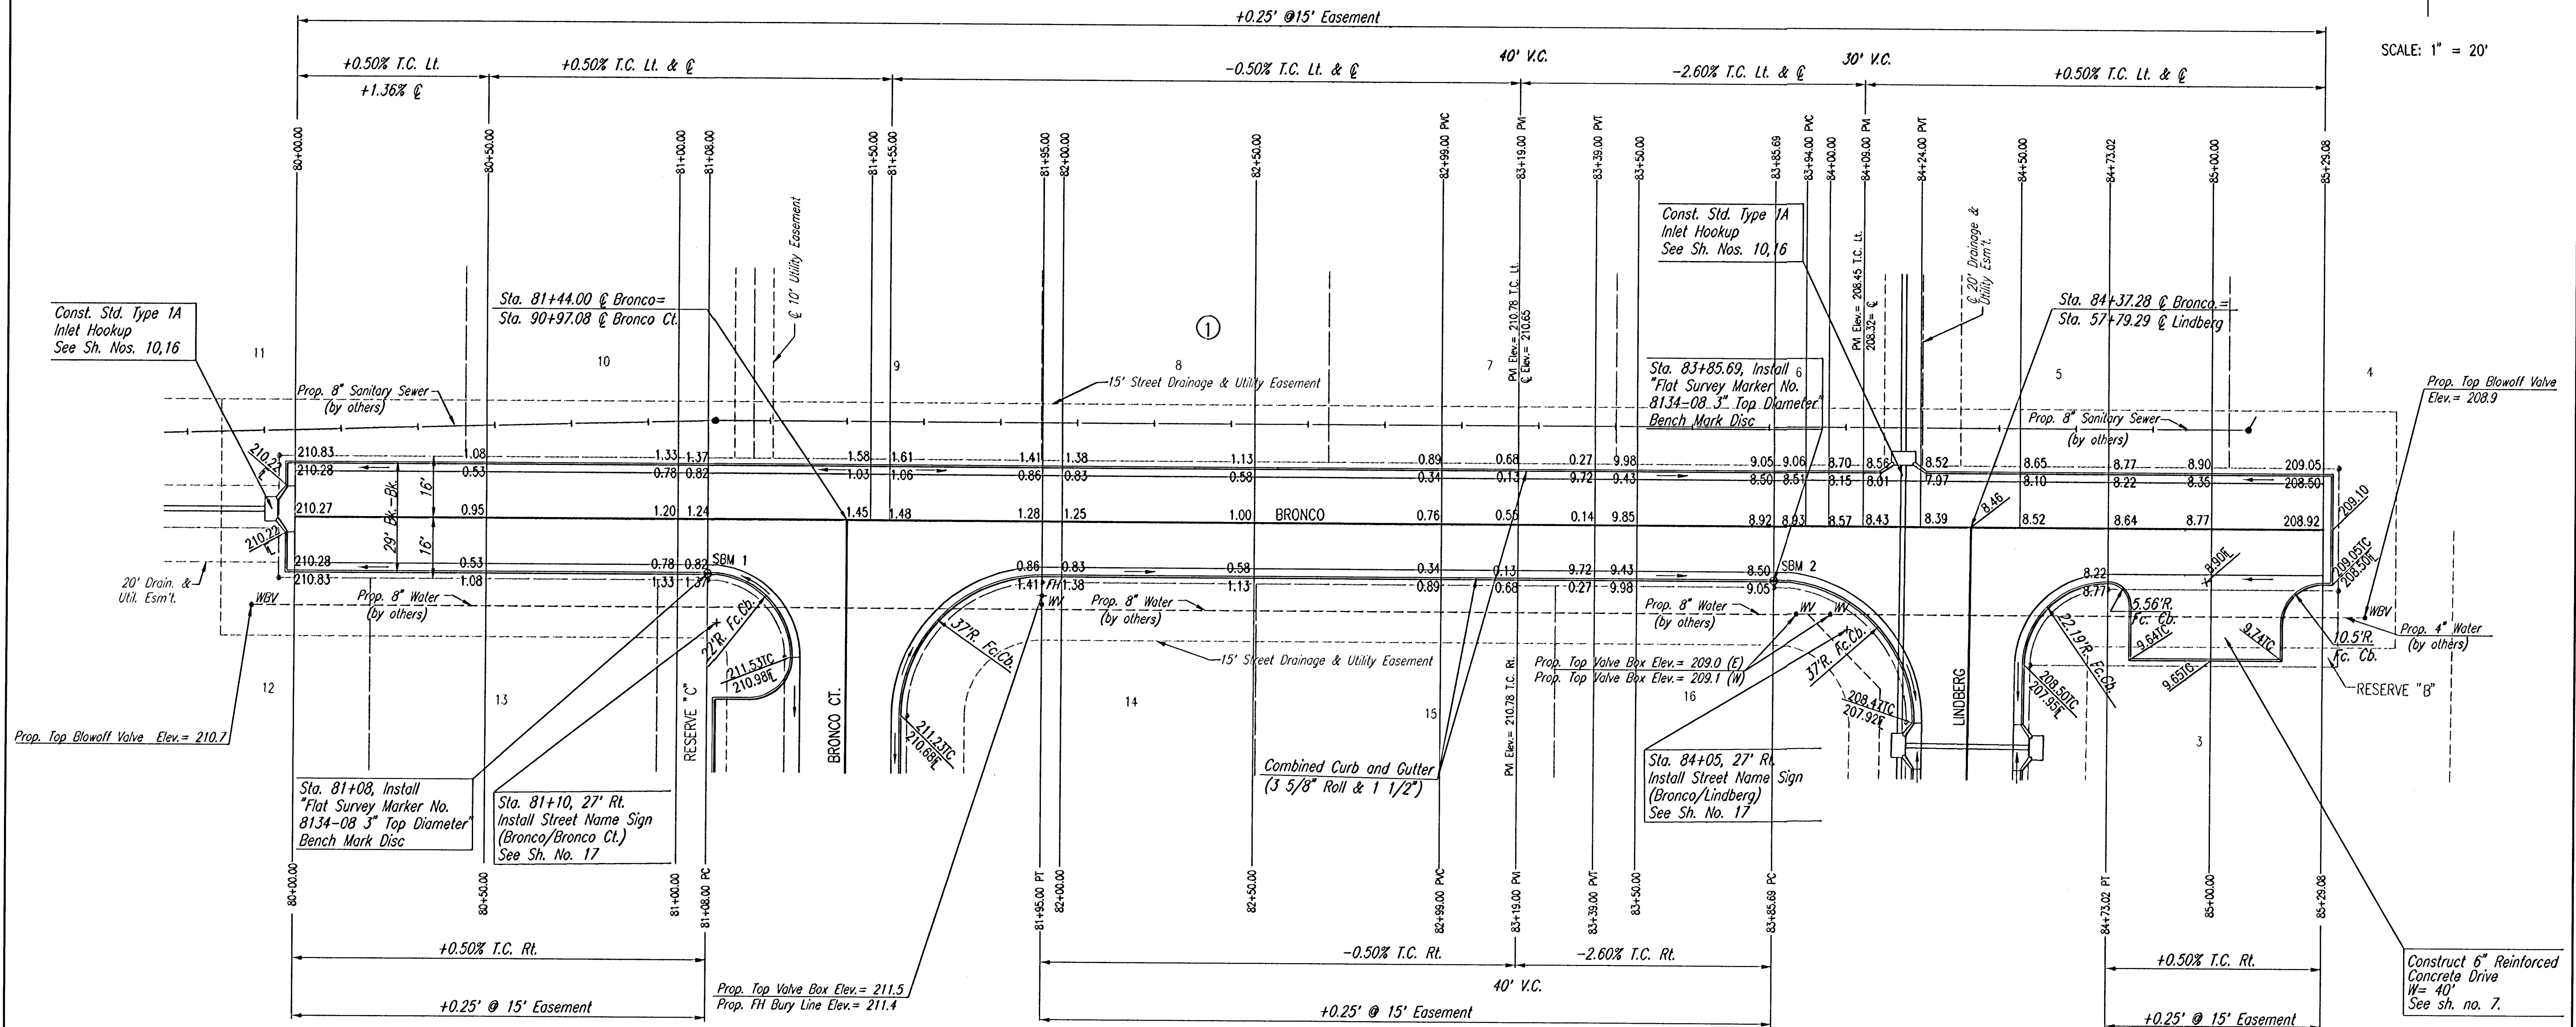

NOTE: THIS STREET TO BE CONSTRUCTED WITH ROLL-TYPE CURB. TOP OF CURB ELEVATIONS GIVEN ARE FOR FULL HEIGHT CURB.

RECORD DRAWING

24 NOV 03

No.	Revision	By	Date
	REVISION PLACE 2ND ADDITION NEIL D. CABLE P.E. - CITY ENGINEER		
BRONCO STA. 80+00.00 TO STA. 85+29.08 CITY OF WICHITA PROJECT NO. 472-83678			
Professional Engineering Consultants, P.A. 303 S. TOPEKA • WICHITA, KANSAS 67202 316-262-2691 • FAX 316-262-3003			
Designed by	BER, JUD	Job No.	35-02662
Drawn by	TLS	Date	January 2003
			Sht. 5 of 17