



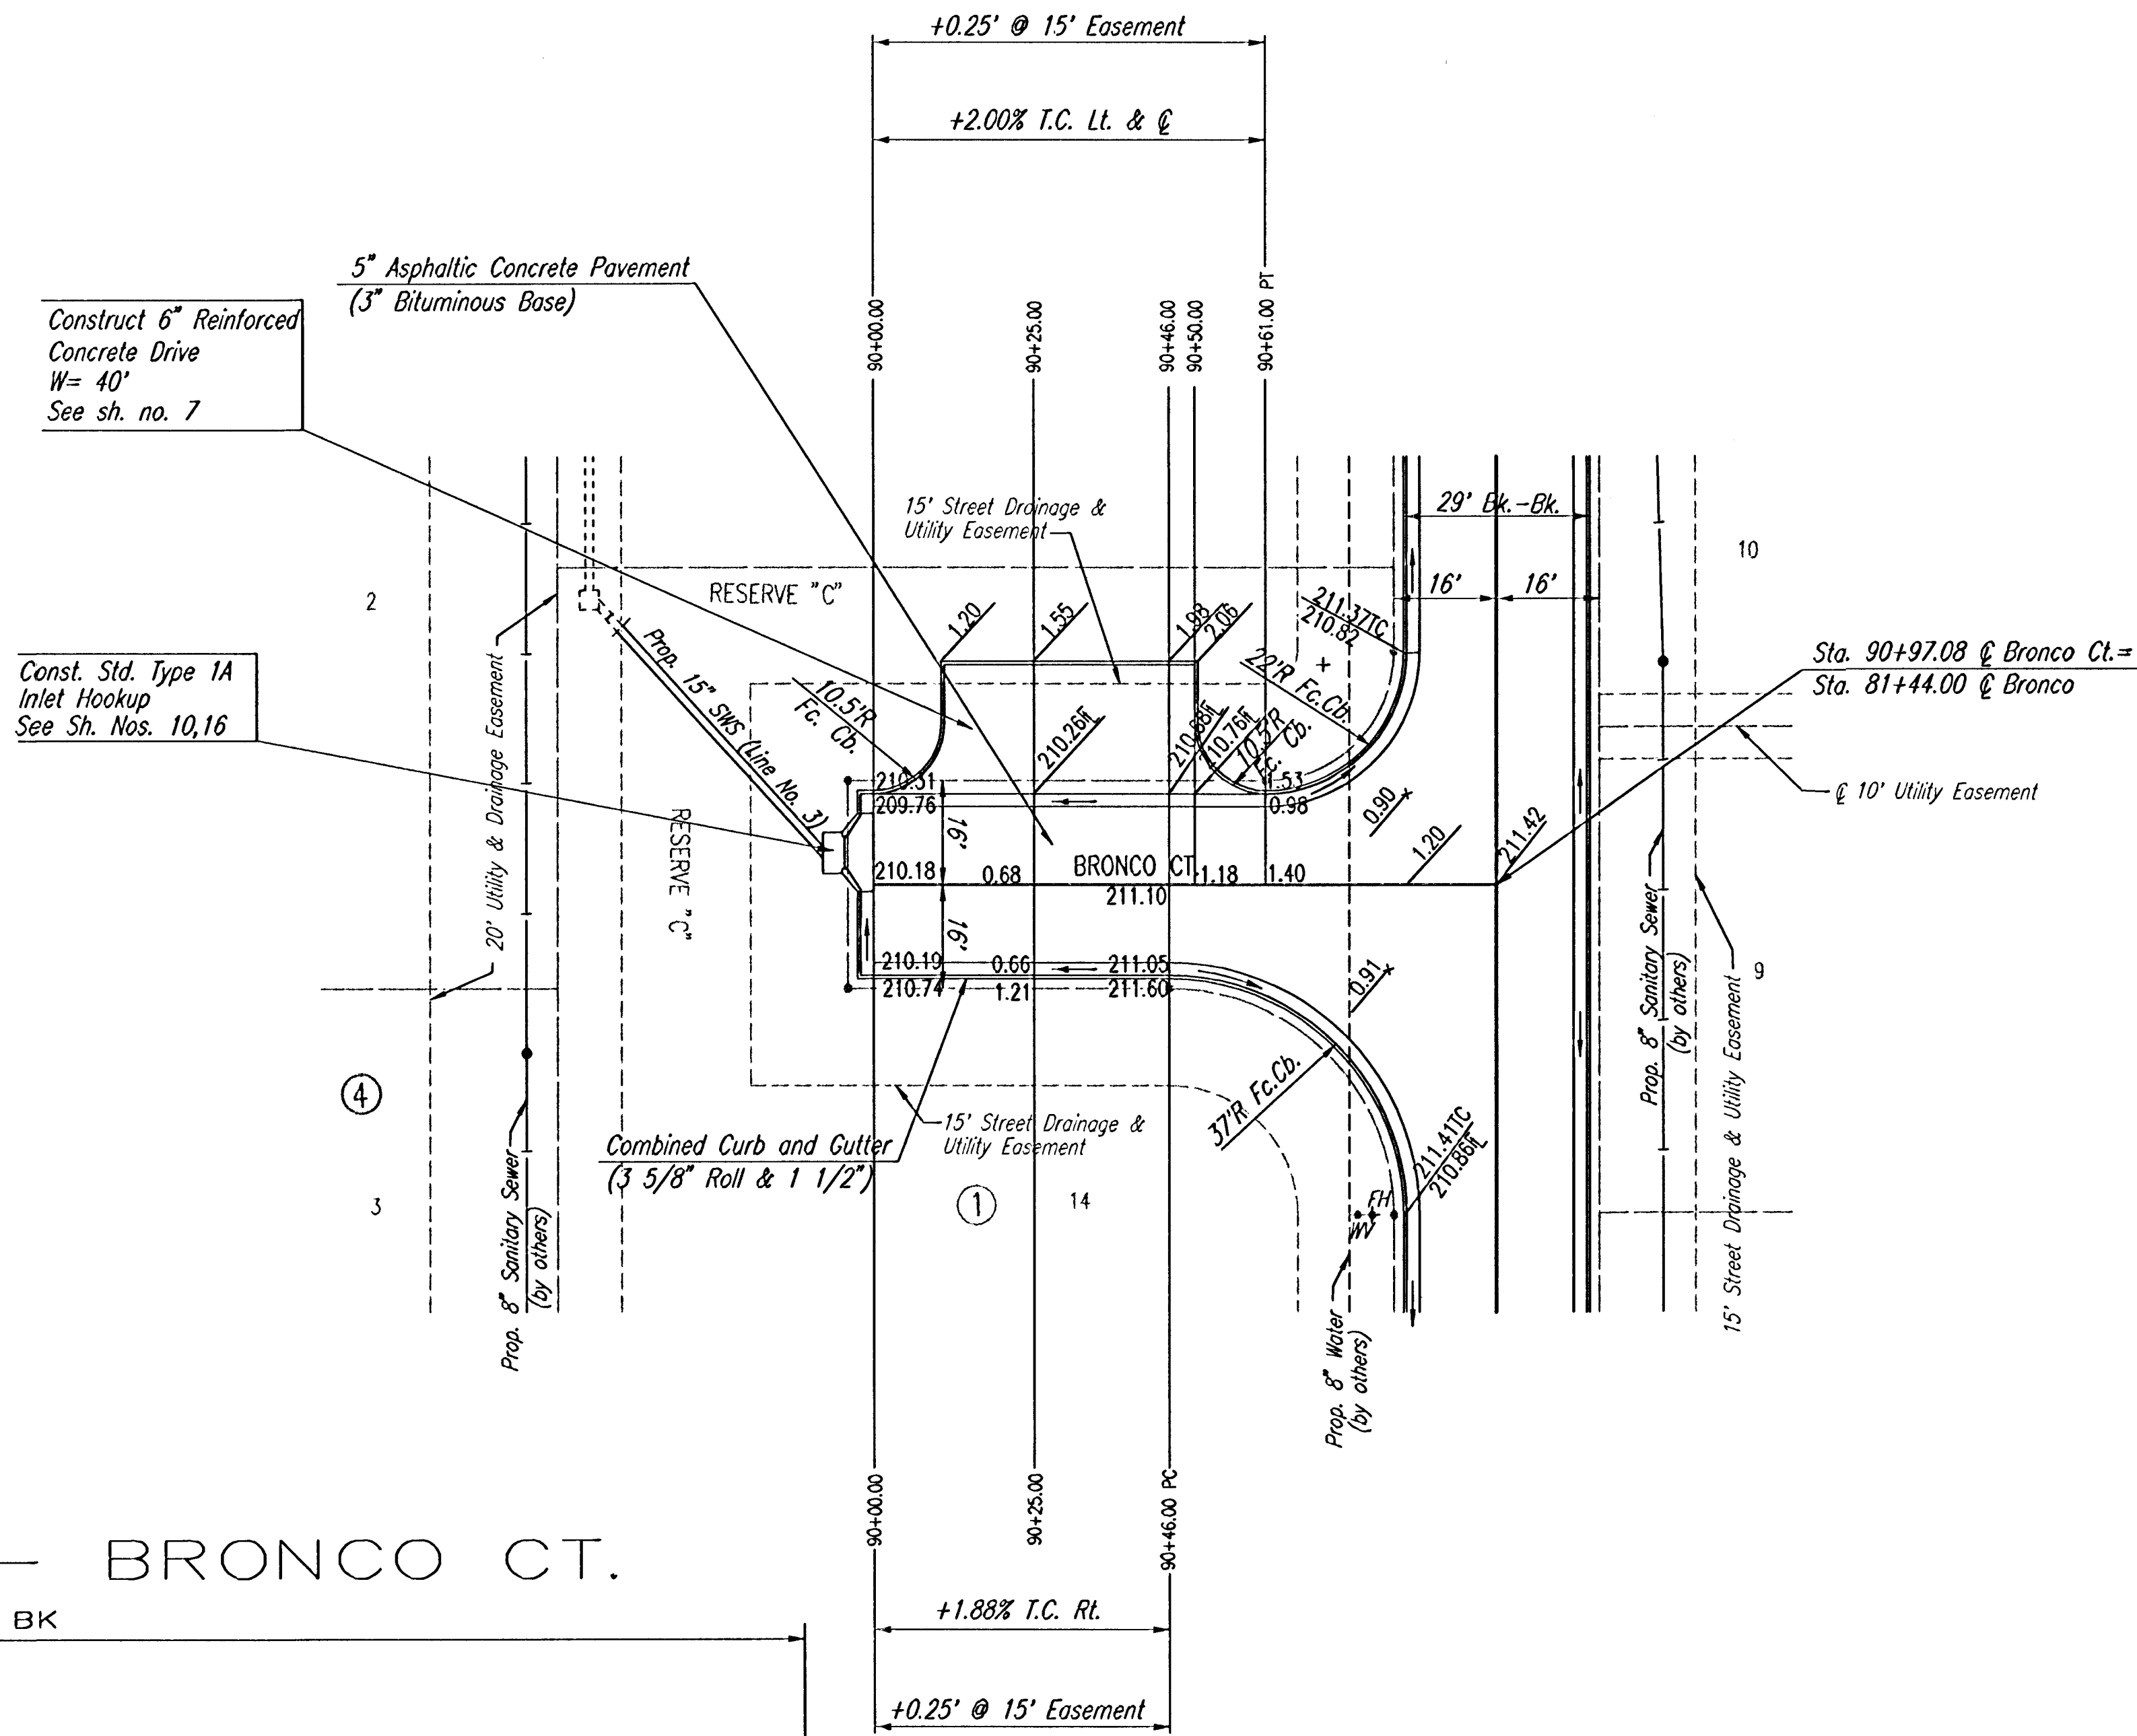

SCALE: 1" = 20'

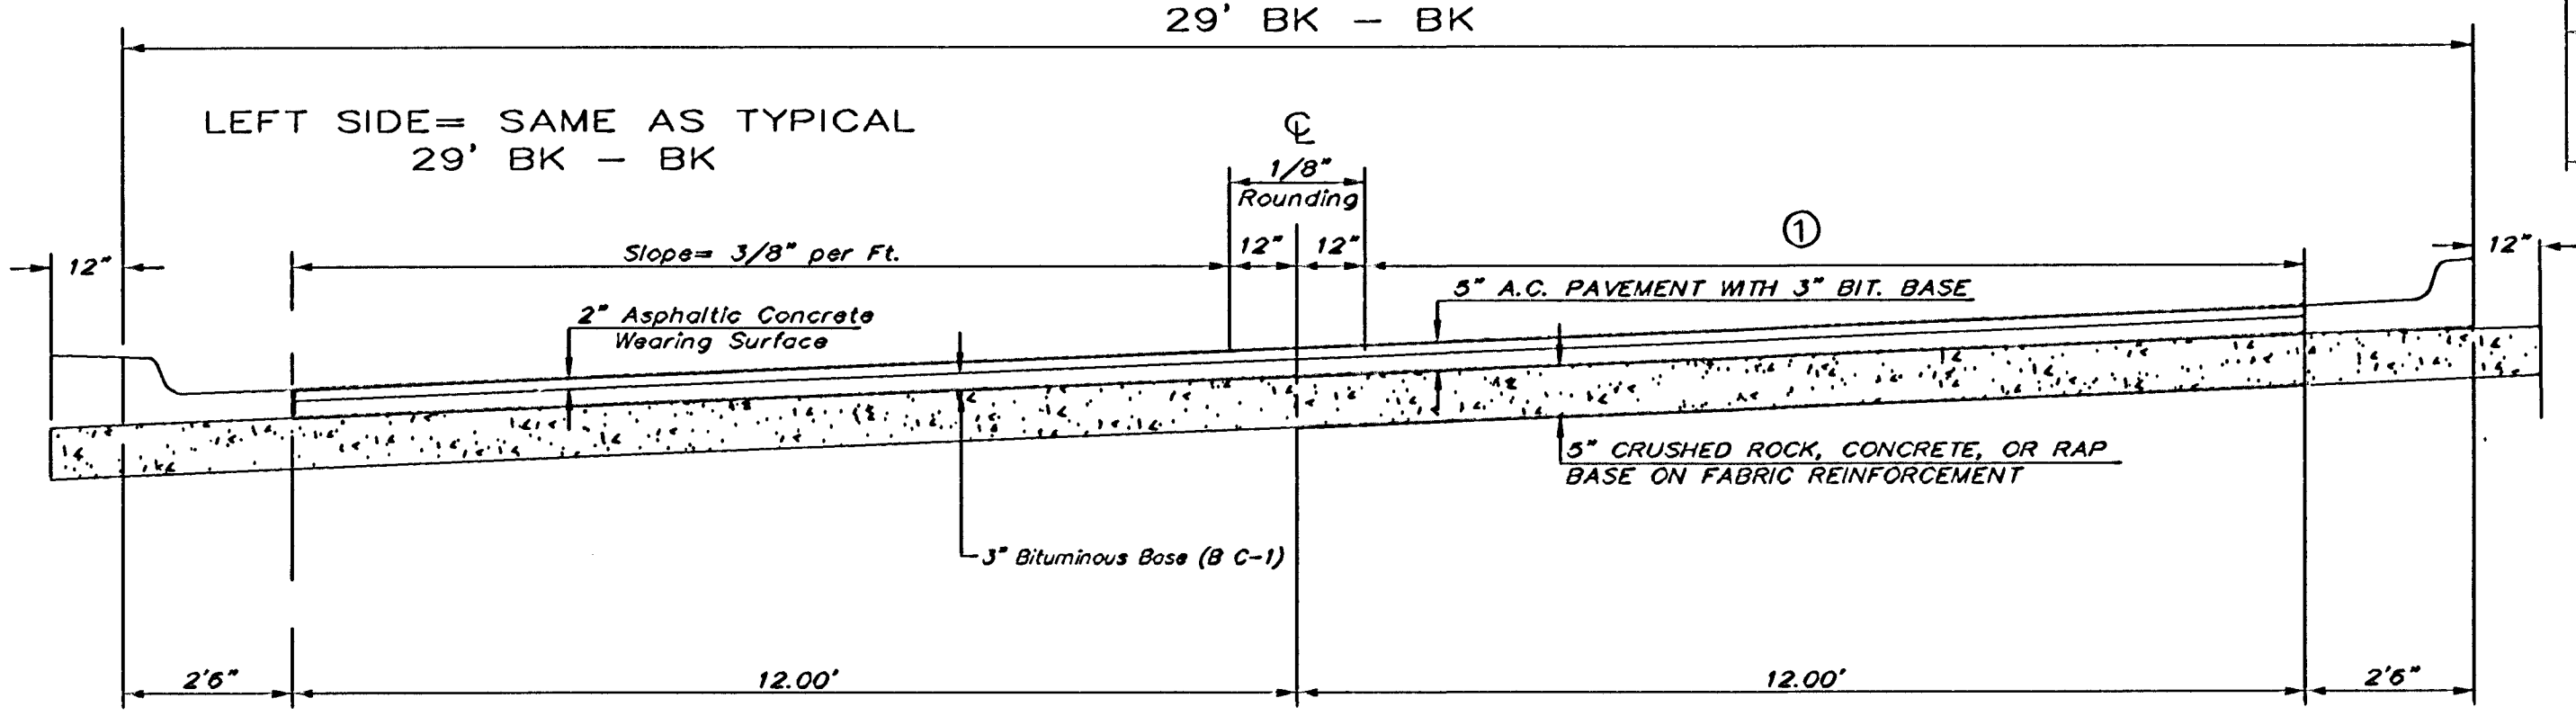

TYPICAL SECTION — BRONCO CT.



① CROSS SLOPE VARIES FROM 0% AT STA. 90+46 TO 0.5% AT STA. 90+00
SEE PLAN

NOTE: THIS STREET TO BE CONSTRUCTED WITH ROLL-TYPE CURB. TOP OF CURB ELEVATIONS GIVEN ARE FOR FULL HEIGHT CURB.

RECORD DRAWING

24 Nov 03

No.	Revision	By	Date
	REMINGTON PLACE 2ND ADDITION NEIL D. CABLE P.E. - CITY ENGINEER BRONCO CT. STA. 90+00.00 TO STA. 90+97.08 CITY OF WICHITA PROJECT NO. 472-83878		
Professional Engineering Consultants, P.A. 303 S. TOPEKA • WICHITA, KANSAS 67202 316-262-2691 • FAX 316-262-3003			
Designed by	BER, JUD	Job No.	35-02662
Drawn by	TLS	Date	January 2003
			Sht. 6 of 17

