

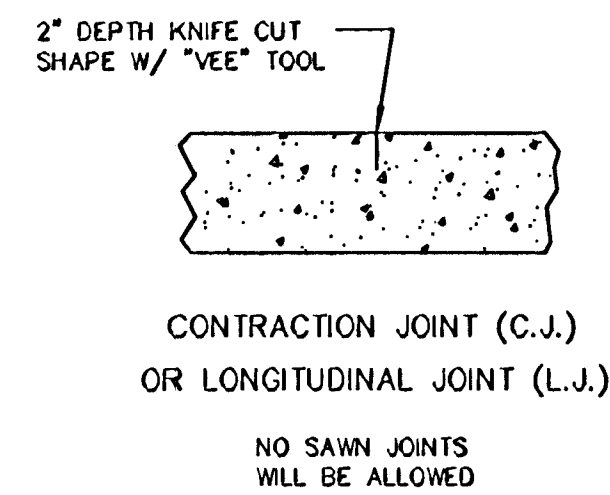


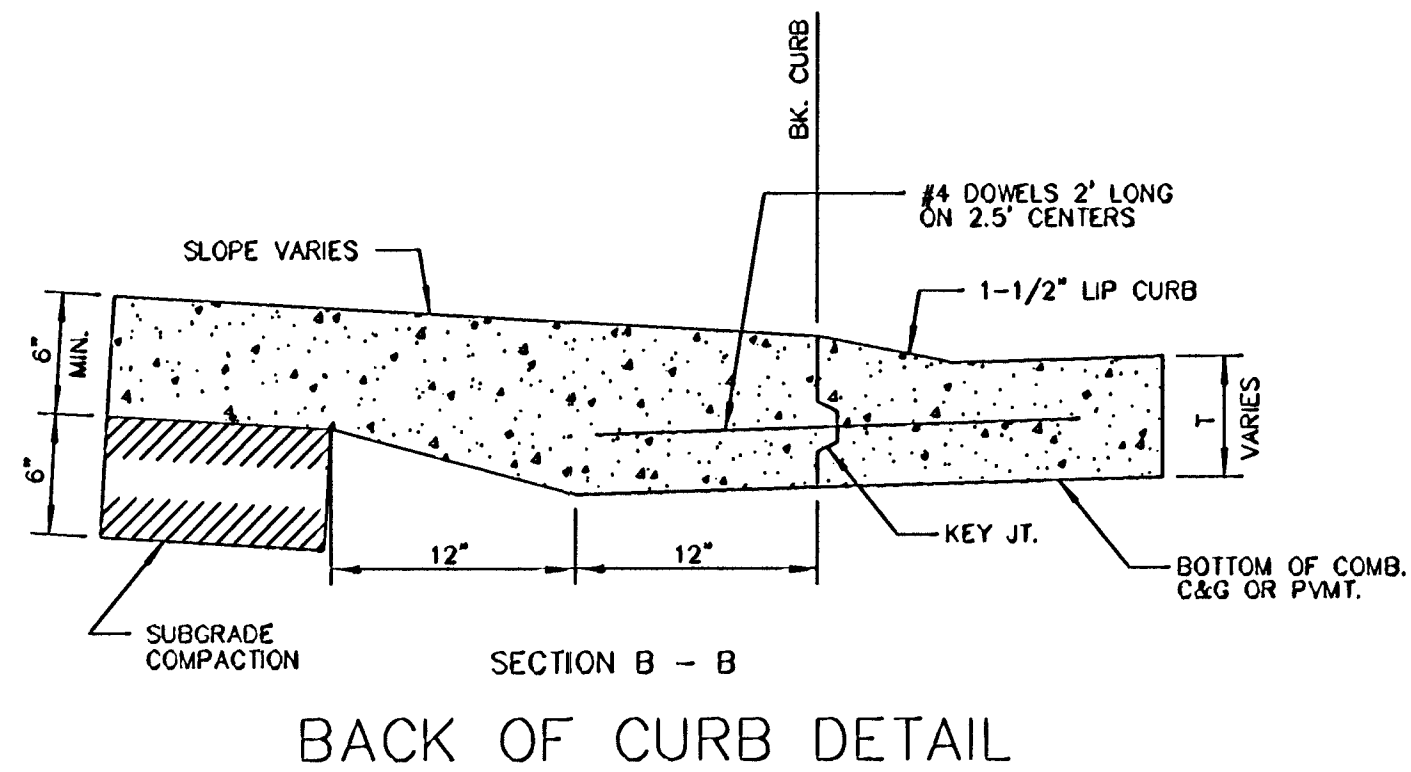


6"x12" W4xW4 WIRE FABRIC REINFORCING
SHALL BE PLACED SUCH THAT THE WIRES
WITH THE 6" SPACING WILL RUN PARALLEL
WITH THE LONGITUDINAL JOINT.

SEE JOINT DETAILS
THIS SHEET

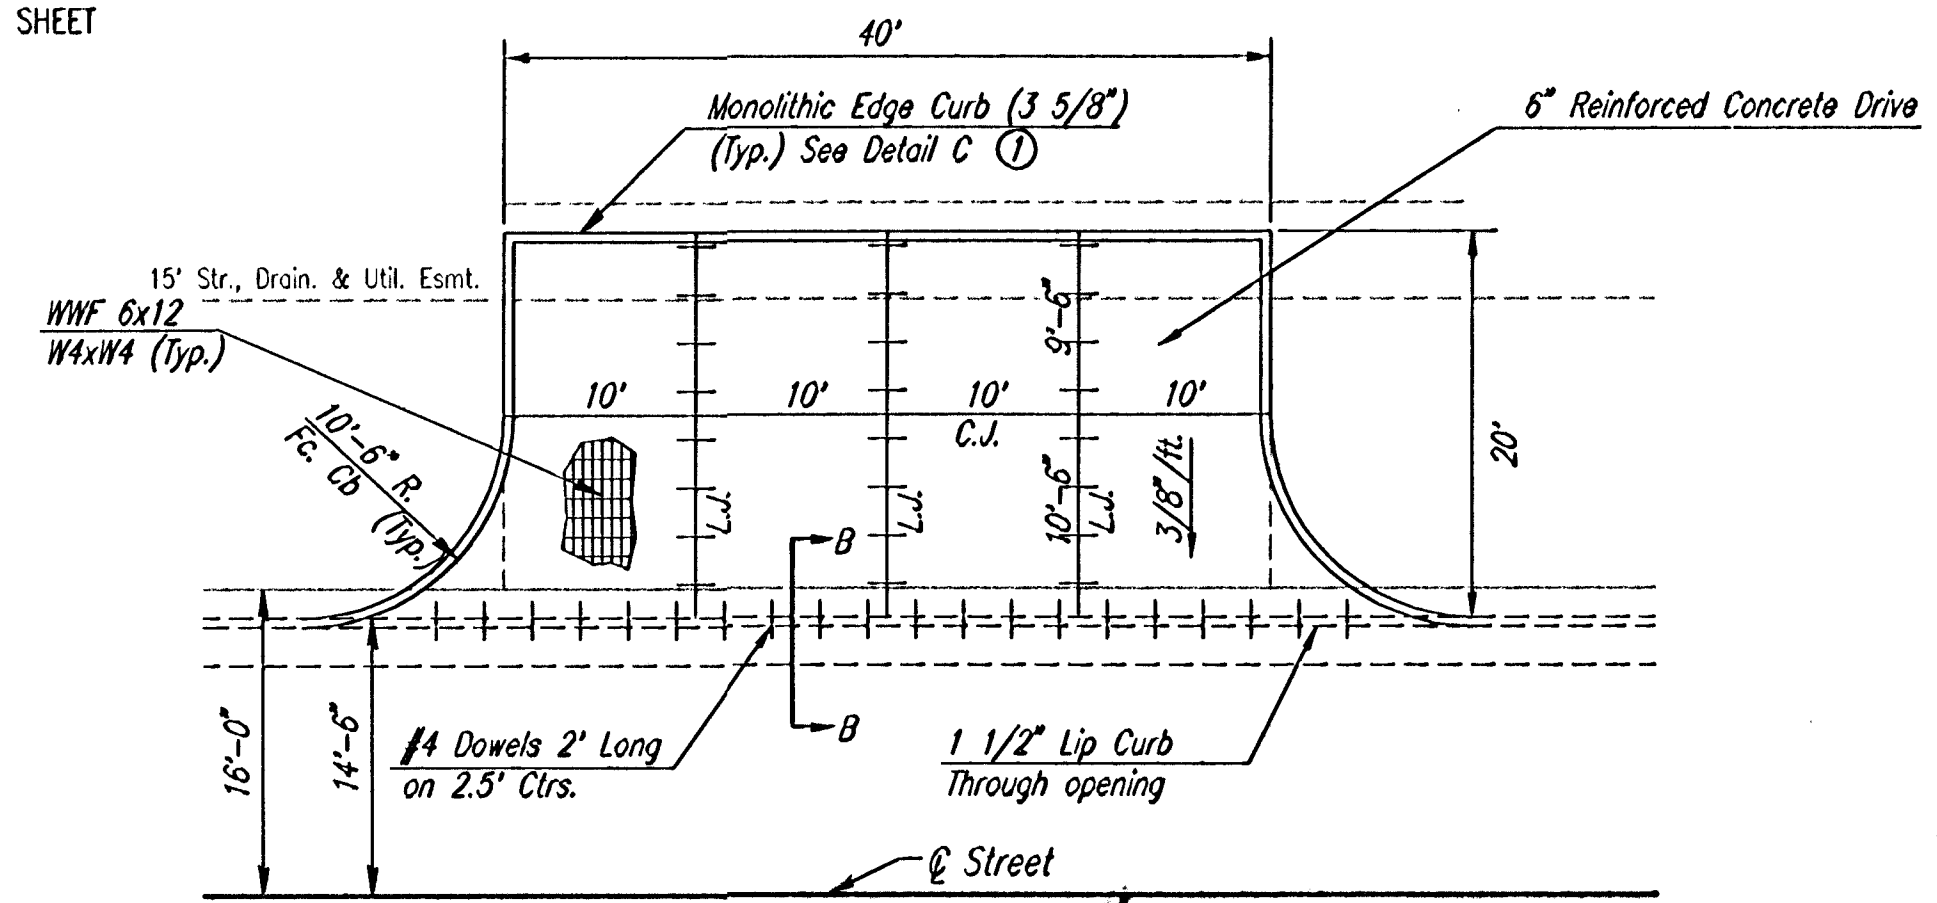


① MONOLITHIC EDGE CURB SHALL
BE SUBSIDIARY TO "6" REINFORCED
CONCRETE DRIVE

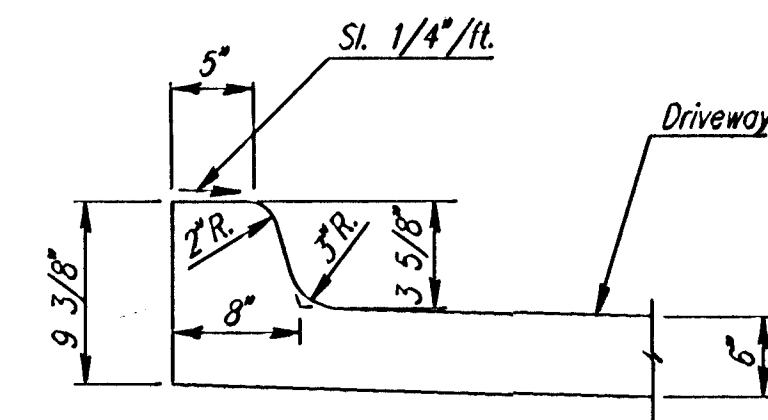

RECORD DRAWING

Neil D. Cable 24 Nov 03

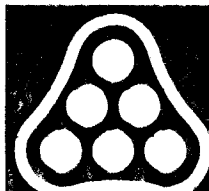	No.	Revision	By	Date
	CITY OF WICHITA, KANSAS NEIL D. CABLE P.E. - CITY ENGINEER			
	MISCELLANEOUS PAVING DETAILS			
	CITY OF WICHITA PROJECT NO. 472-83678			
	Professional Engineering Consultants, P.A. 303 S. TOPEKA • WICHITA, KANSAS 67202 316-262-2691 • FAX 316-262-3003			
Designed by	BER, JUD	Job No.	35-02662	Sht. 7 of 17
Drawn by	TLS	Date	January 2003	