
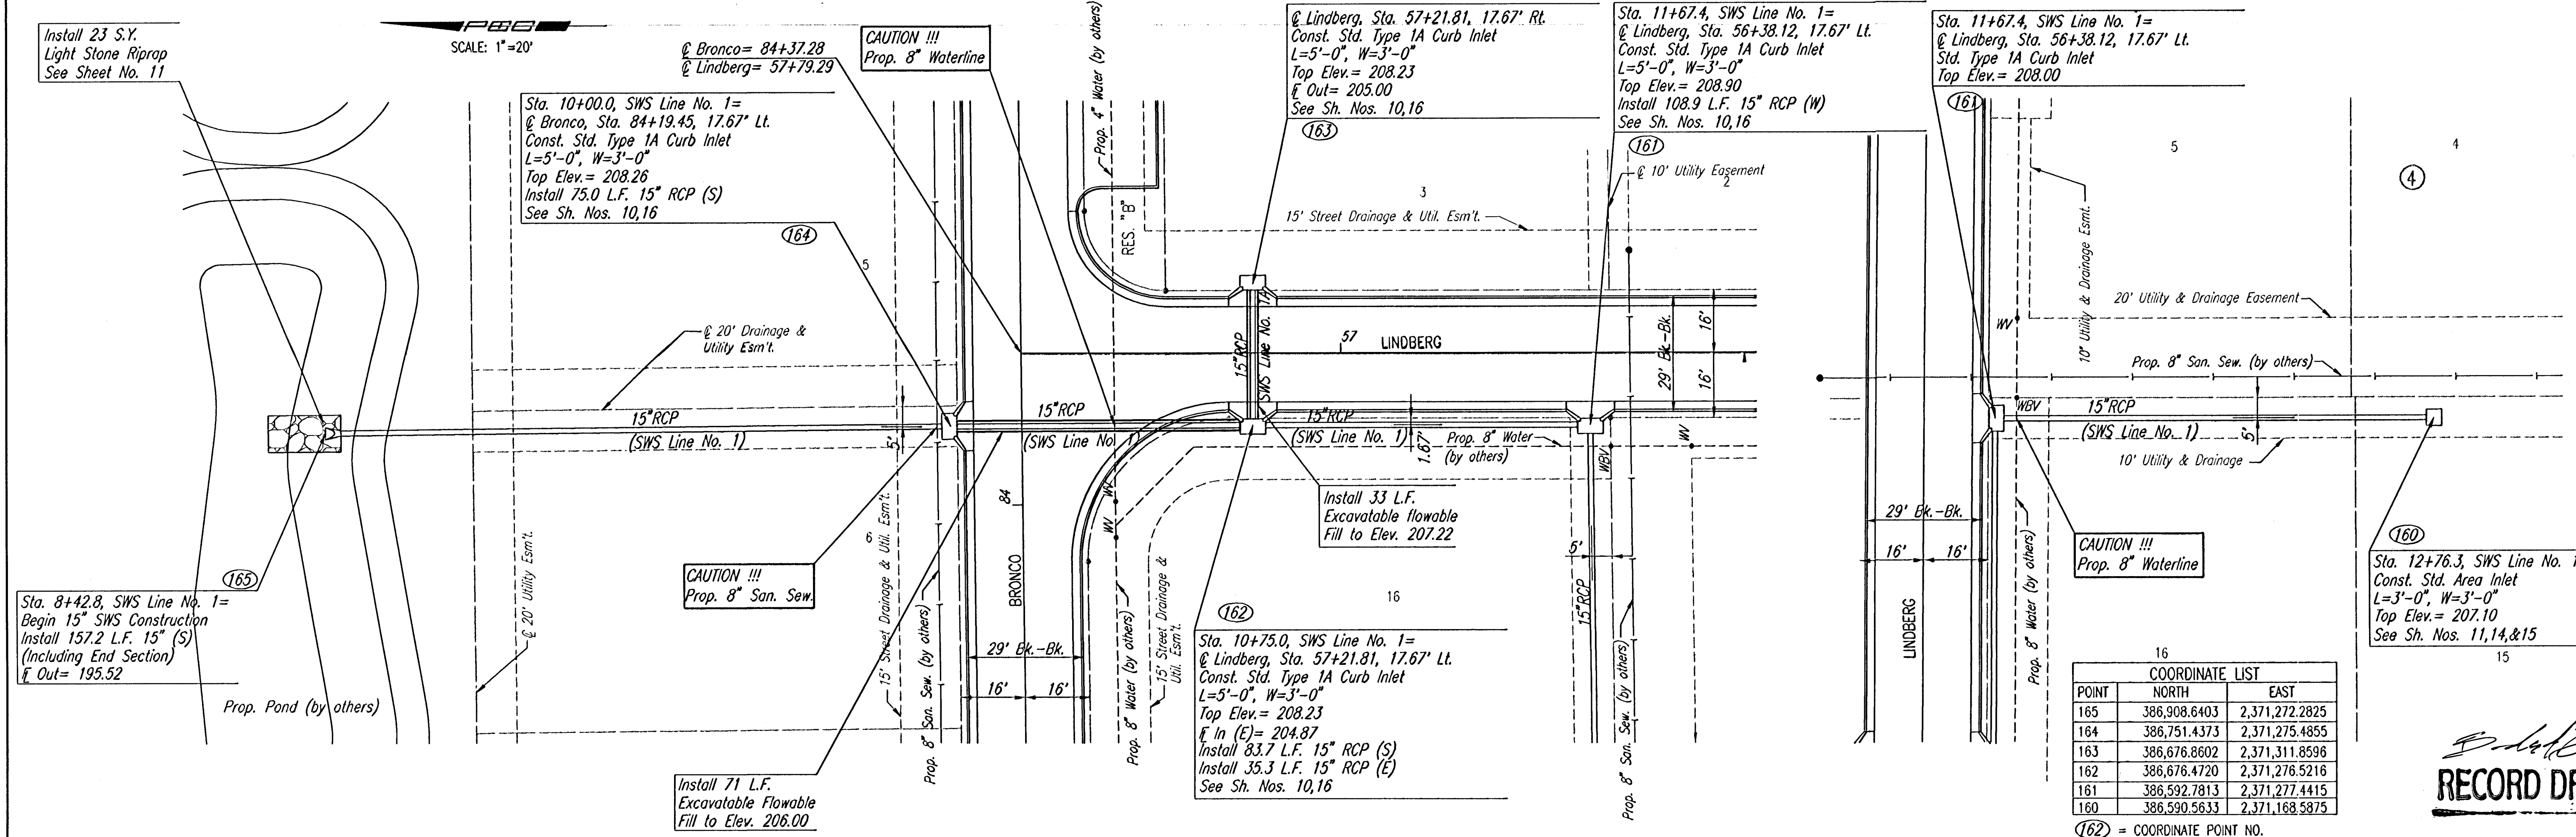


PLAN	CHECKED	DATE

PROFILE	CHECKED	DATE

DSNR: BER OFR: ILS SCALE: 1"=20.00
Q:\2002\02662\000\SWS\LINE 1 03-04-2003 11:27:03 am

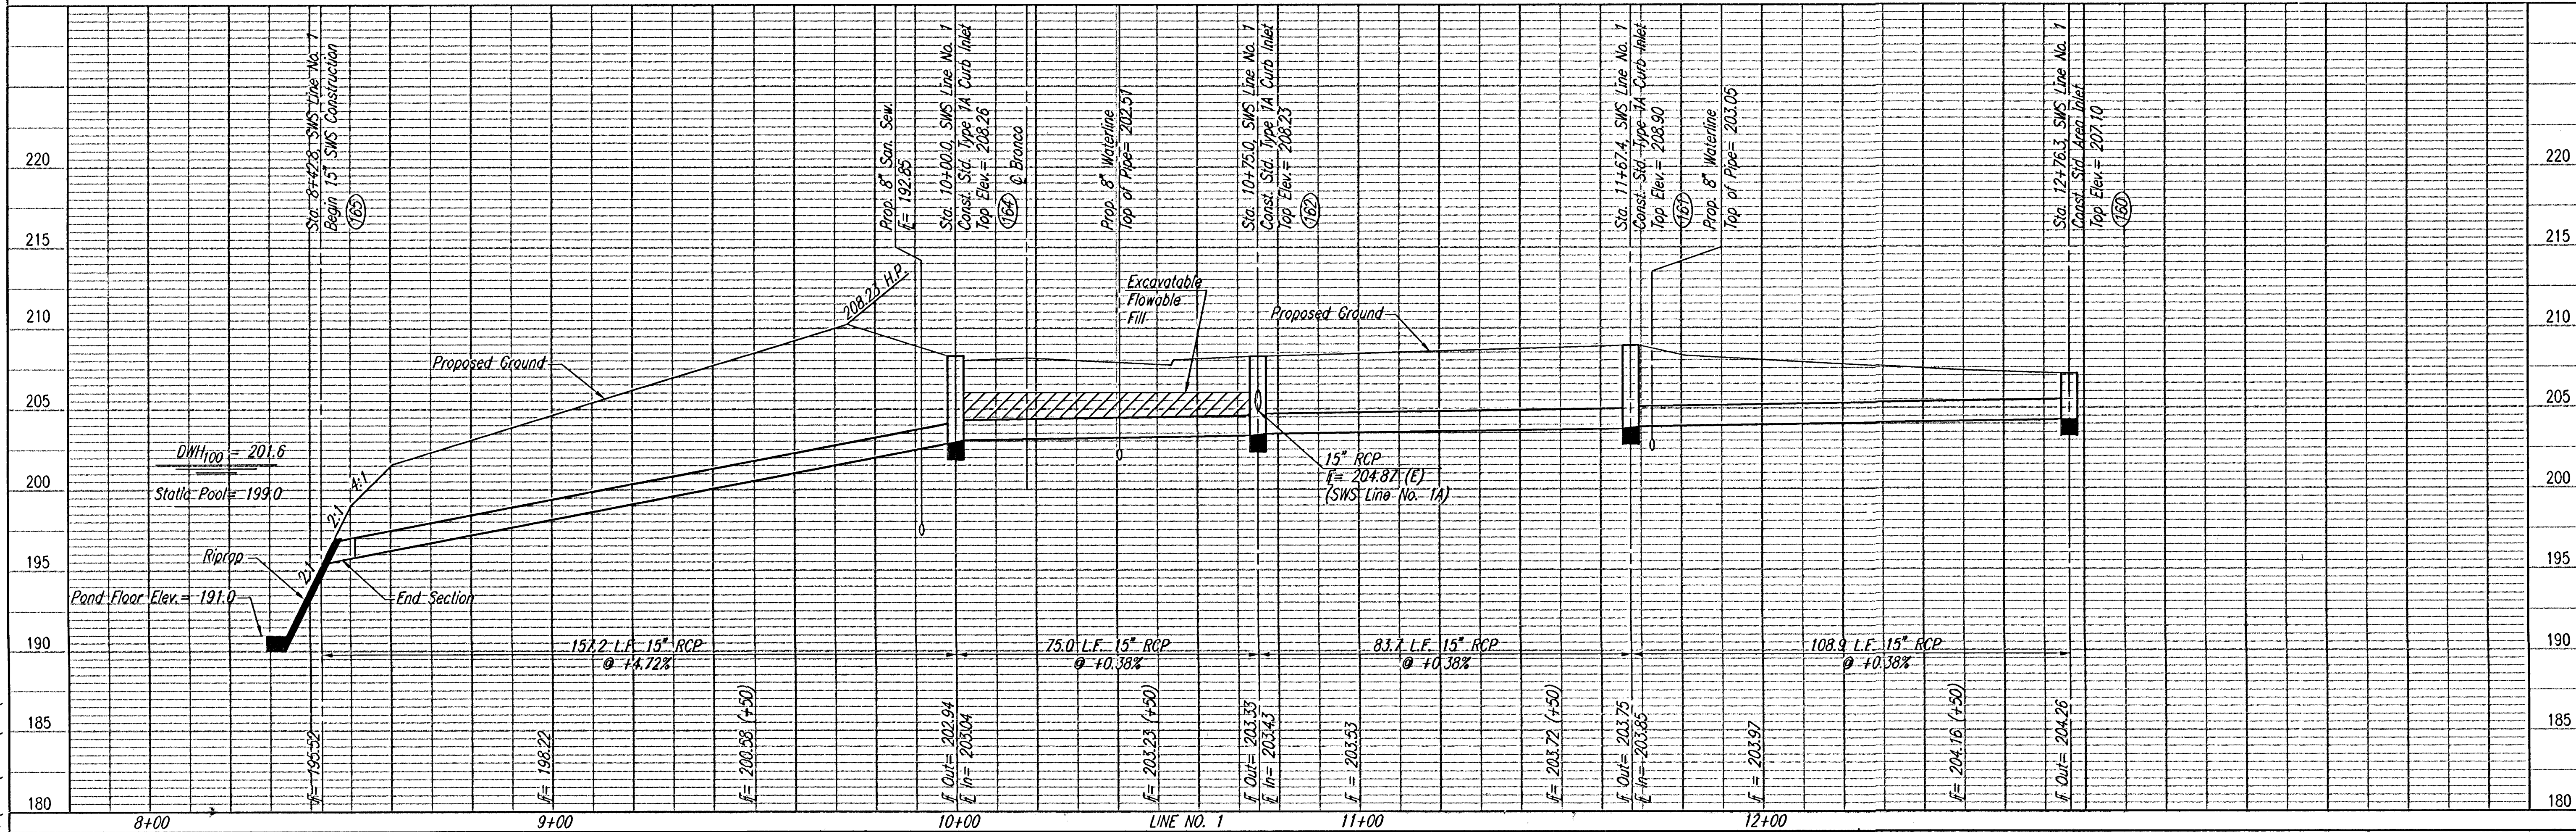

COORDINATE LIST		
POINT	NORTH	EAST
165	386,908.6403	2,371,272.2825
164	386,751.4373	2,371,275.4855
163	386,676.8602	2,371,311.8596
162	386,676.4720	2,371,276.5216
161	386,592.7813	2,371,277.4415
160	386,590.5633	2,371,168.5875

(162) = COORDINATE POINT NO.

RECORD DRAWING