



REMINGTON PLACE 2ND
AN ADDITION TO WICHITA, SEDGWICK COUNTY, KANSAS

SCALE: 1" = 100'

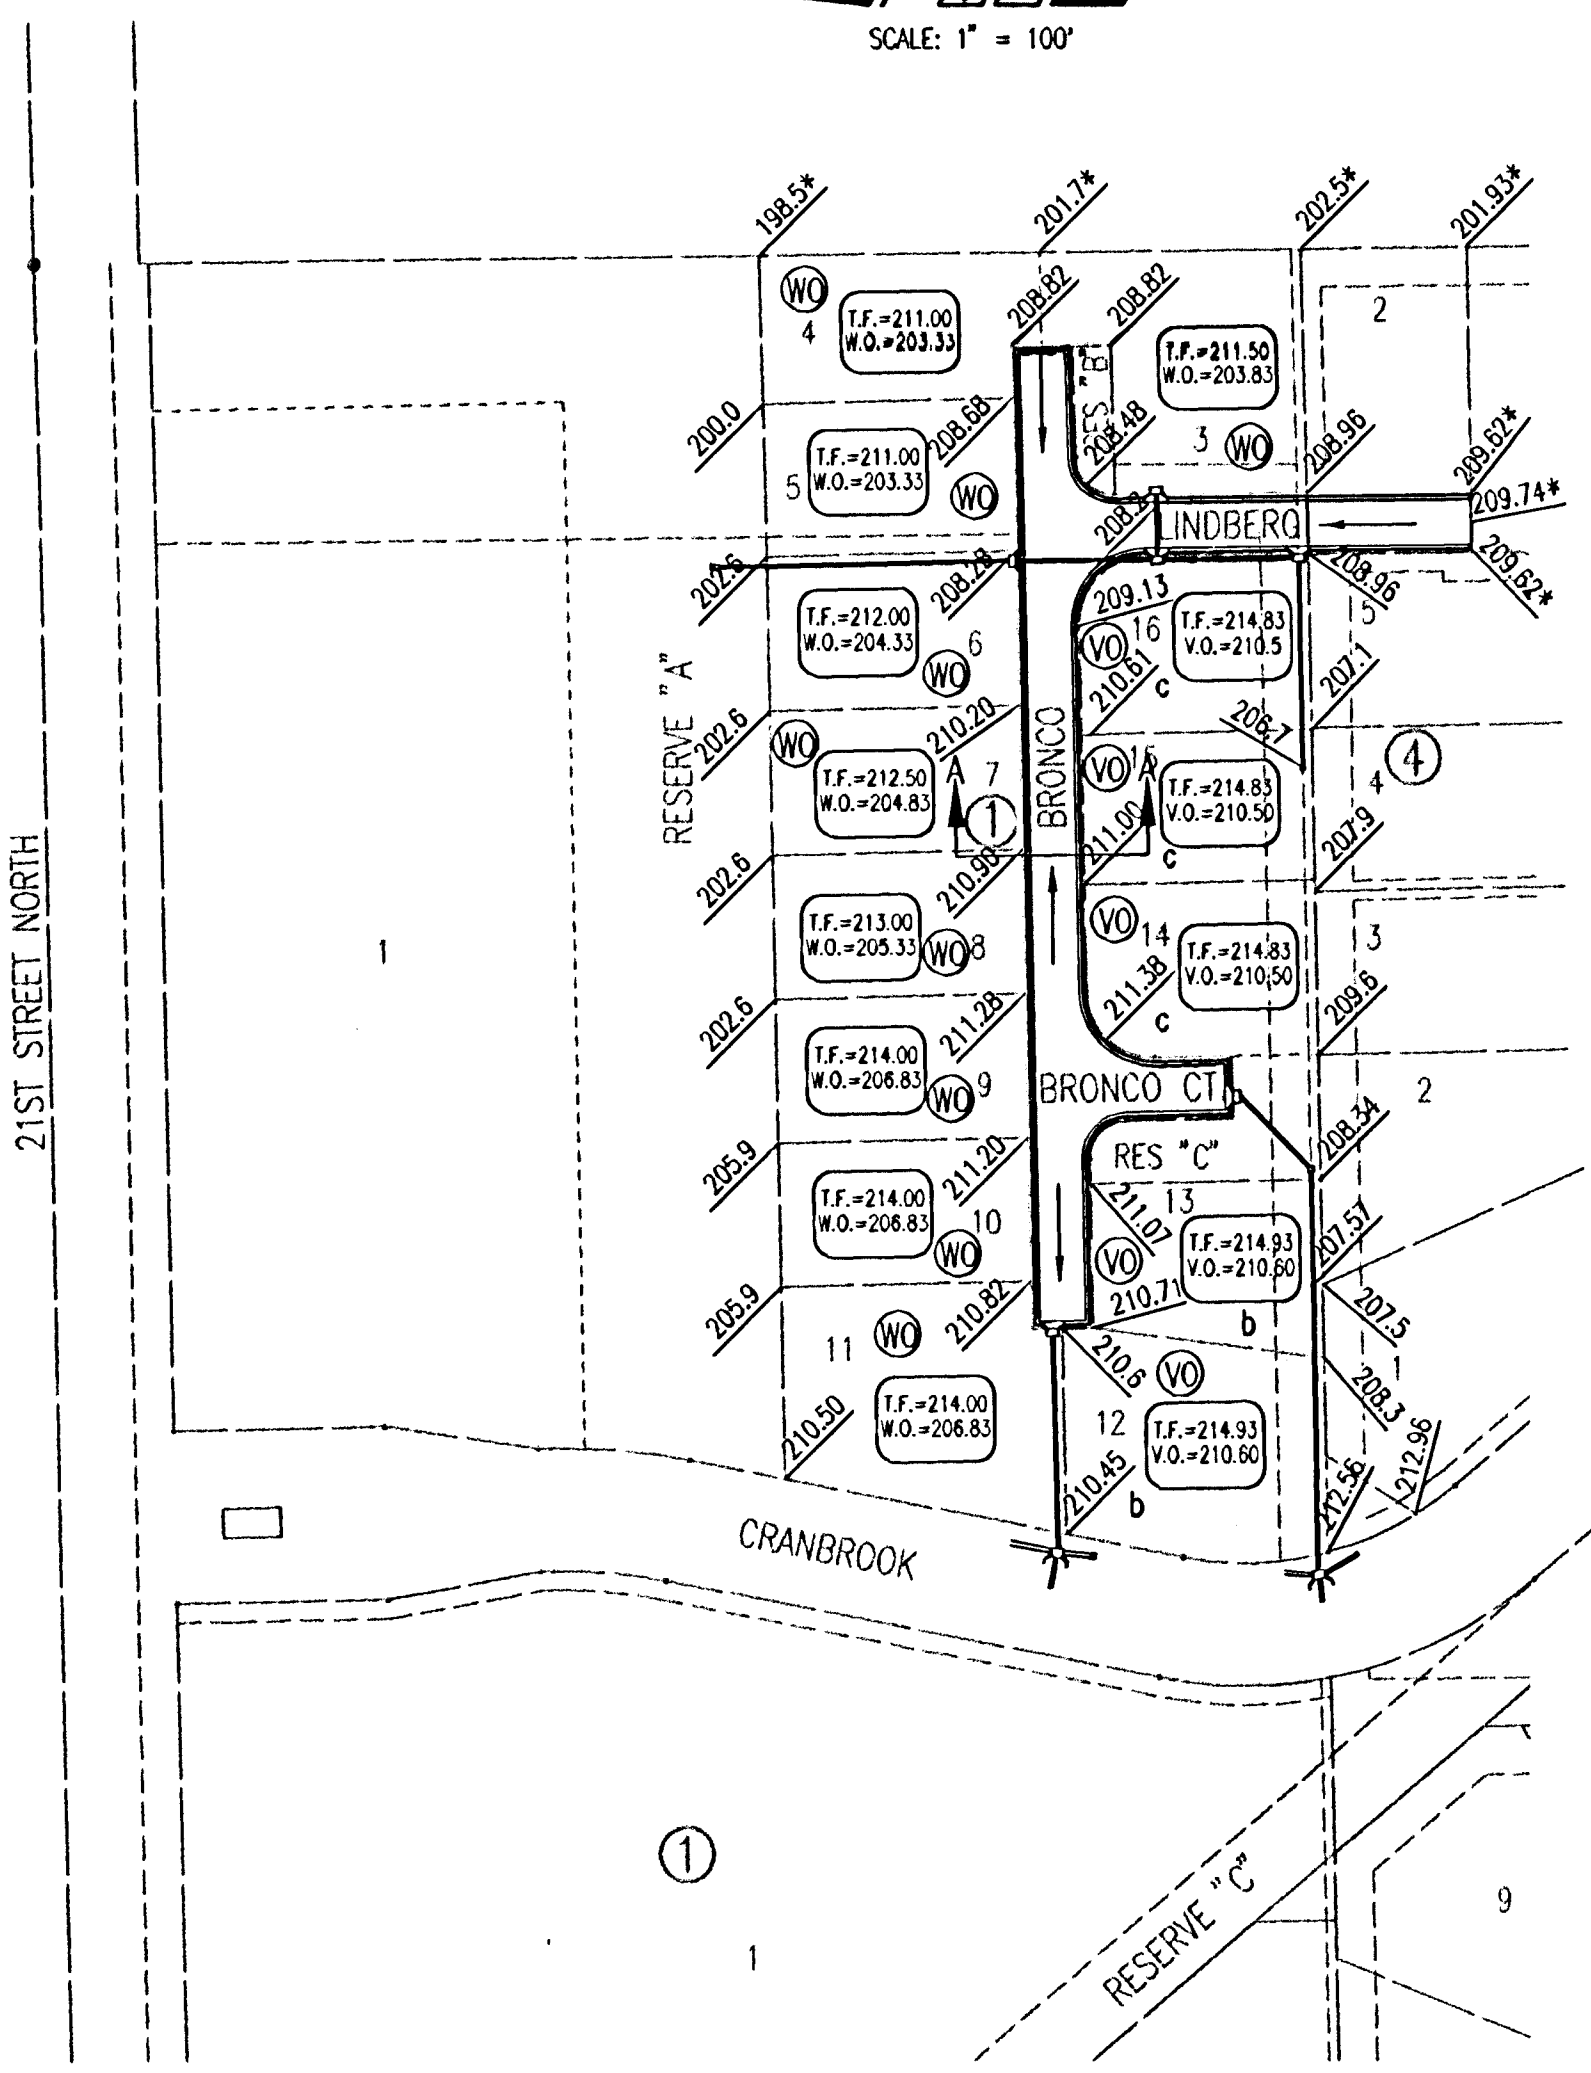

- a MINIMUM OPENING= 203.5
- b MINIMUM OPENING= 210.6
- c MINIMUM OPENING= 210.5
- d MINIMUM OPENING= 208.7
- f MINIMUM OPENING= 207.5

- (X) STD. BASEMENT
- (VO) VIEW-OUT BASEMENT
- (WO) WALK-OUT BASEMENT
- * MATCH EXISTING

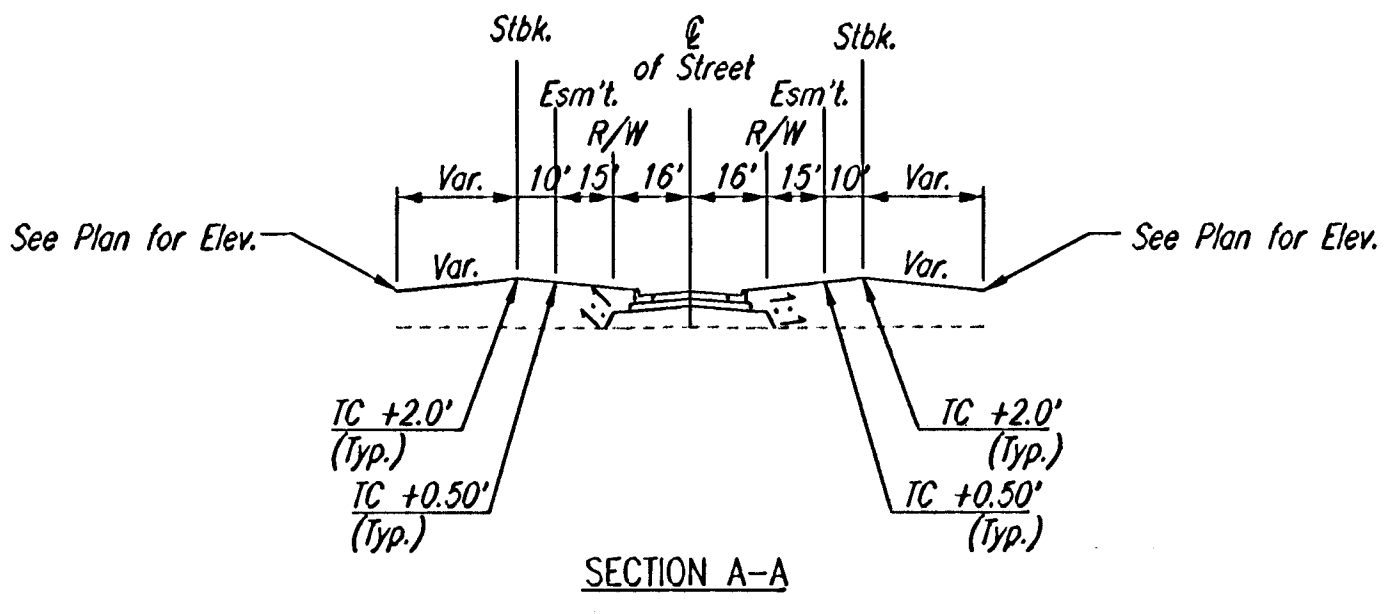

RECORD DRAWING

	Revision		By	Date
	CITY OF WICHITA, KANSAS NEIL D. CABLE P.E. - CITY ENGINEER			
	FOUR CORNER LOT GRADING			
	CITY OF WICHITA PROJECT NO. 472-83678			
	Professional Engineering Consultants, P.A. 303 S. TOPEKA • WICHITA, KANSAS 67202 316-262-2691 • FAX 316-262-3003			
Designed by	BER, JUD	Job No.	35-02662	Sht. 12 of 17
Drawn by	SAW	Date	January 2003	