



	BY	DATE
REFERENCES NOTED		
REFERENCES CHECKED		

AS BUILT
7/28/03
RDL
PDF

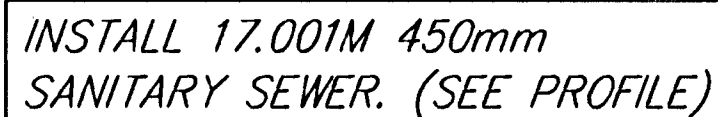

~~STA. 9+223.208, 6' 468' RT.,~~
 CONSTRUCT MANHOLE (TYPE P)
 TOP ELEV. = ~~402.950~~ ~~403.3~~ 37
 \$W FL = ~~399.007~~ 399.06
 S FL = ~~399.230~~ 399.21
 NE FL = ~~398.976~~ 399.03

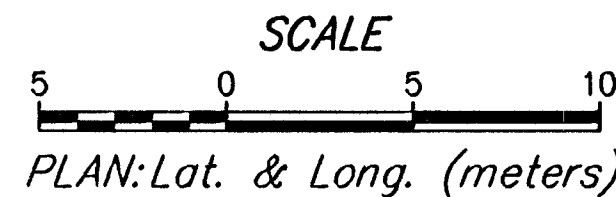

	224 NORTH MAIN WICHITA, KANSAS 67203 www.srb.com		318-284-8000 FAX 284-4621 E-Mail: srb@srb.com		REVISED
	SAVOY, RUGGLES & BOHM, P.A. ENGINEERING & SURVEYING				
PROJECT:					
472-76-245-83262-000-000-001					
DRAWN JRA	DESIGN JDS	REVIEW JDS	DATE Sept. 28, 2001	UTILITY JDS	SRB JOB 1217T
					73
					127