


DATE	BY	REFERENCES NOTED	CHECKED

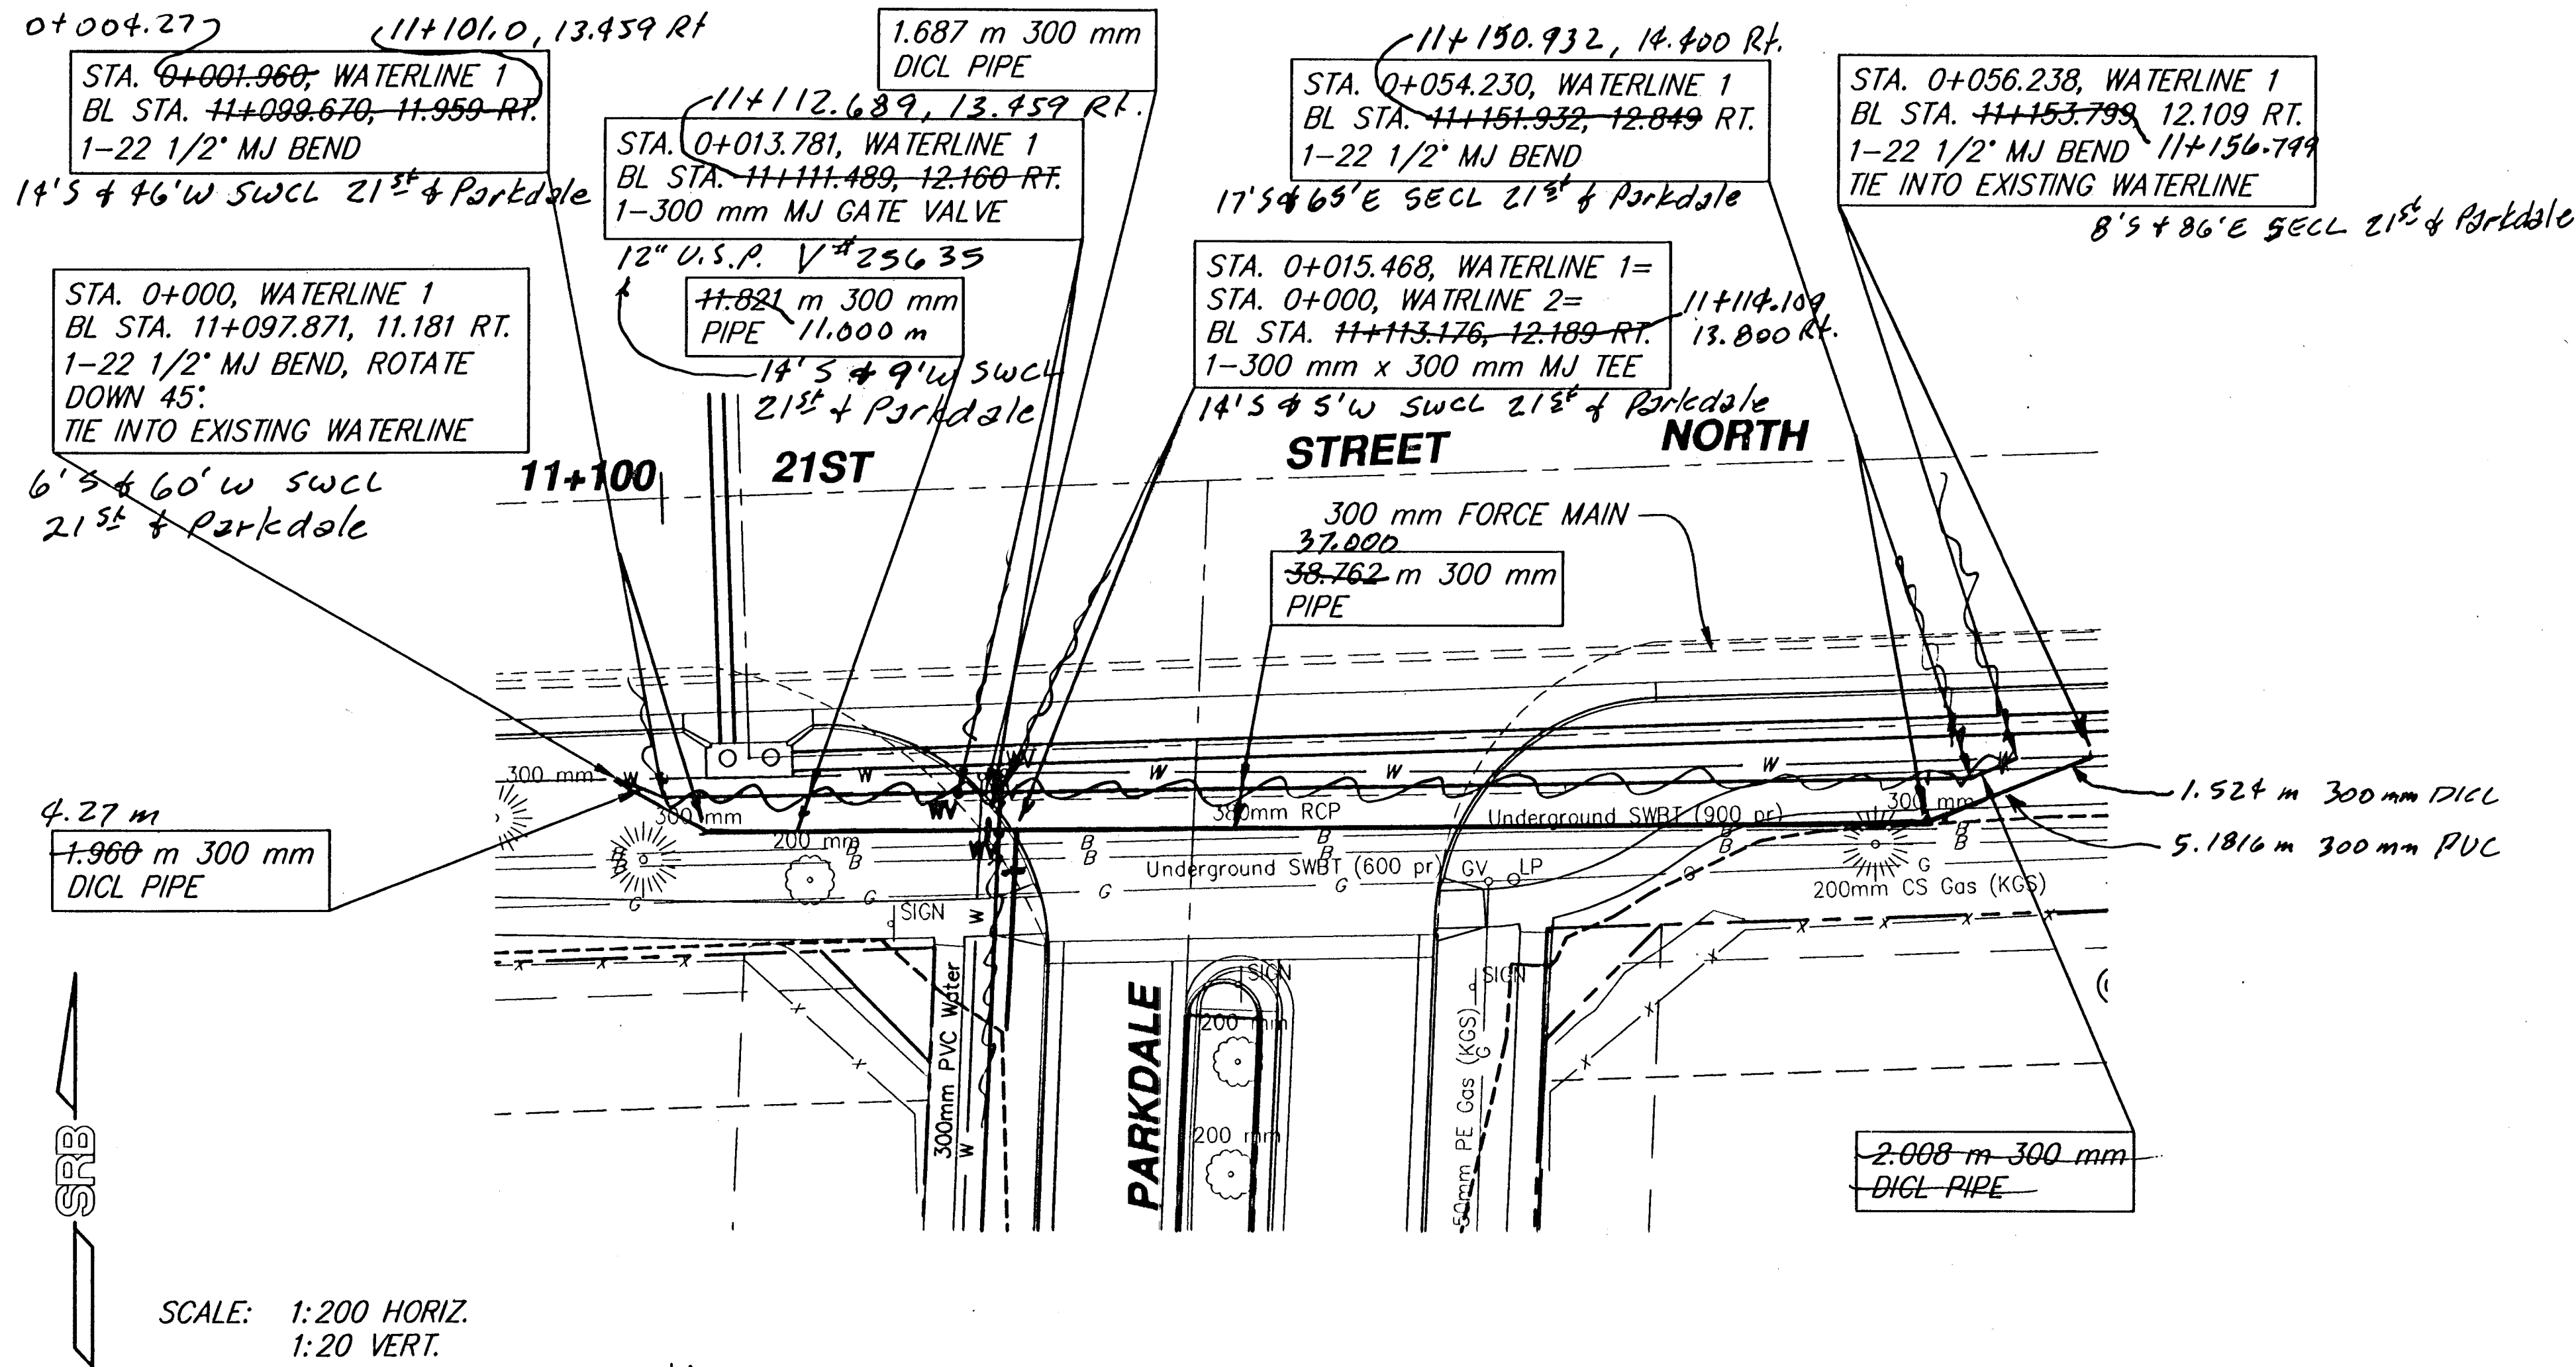



448-89419

SCALE: 1:200 HORIZ.
1:20 VERT.

FHWA REGION NO.	STATE	PROJECT NUMBER	FISCAL YEAR	SHEET NUMBER	TOTAL SHEETS
7	KANSAS	87 N-0189-01	2001	103	105

Contractor: Utility Contractors
Inspector: A. Smith C.O.W.
226 LF 12" PVC PIPE
35 LF 12" DIOL PIPE
2- 12" Valve Assy.

AS BUILT
5/21/03
R. Loomis

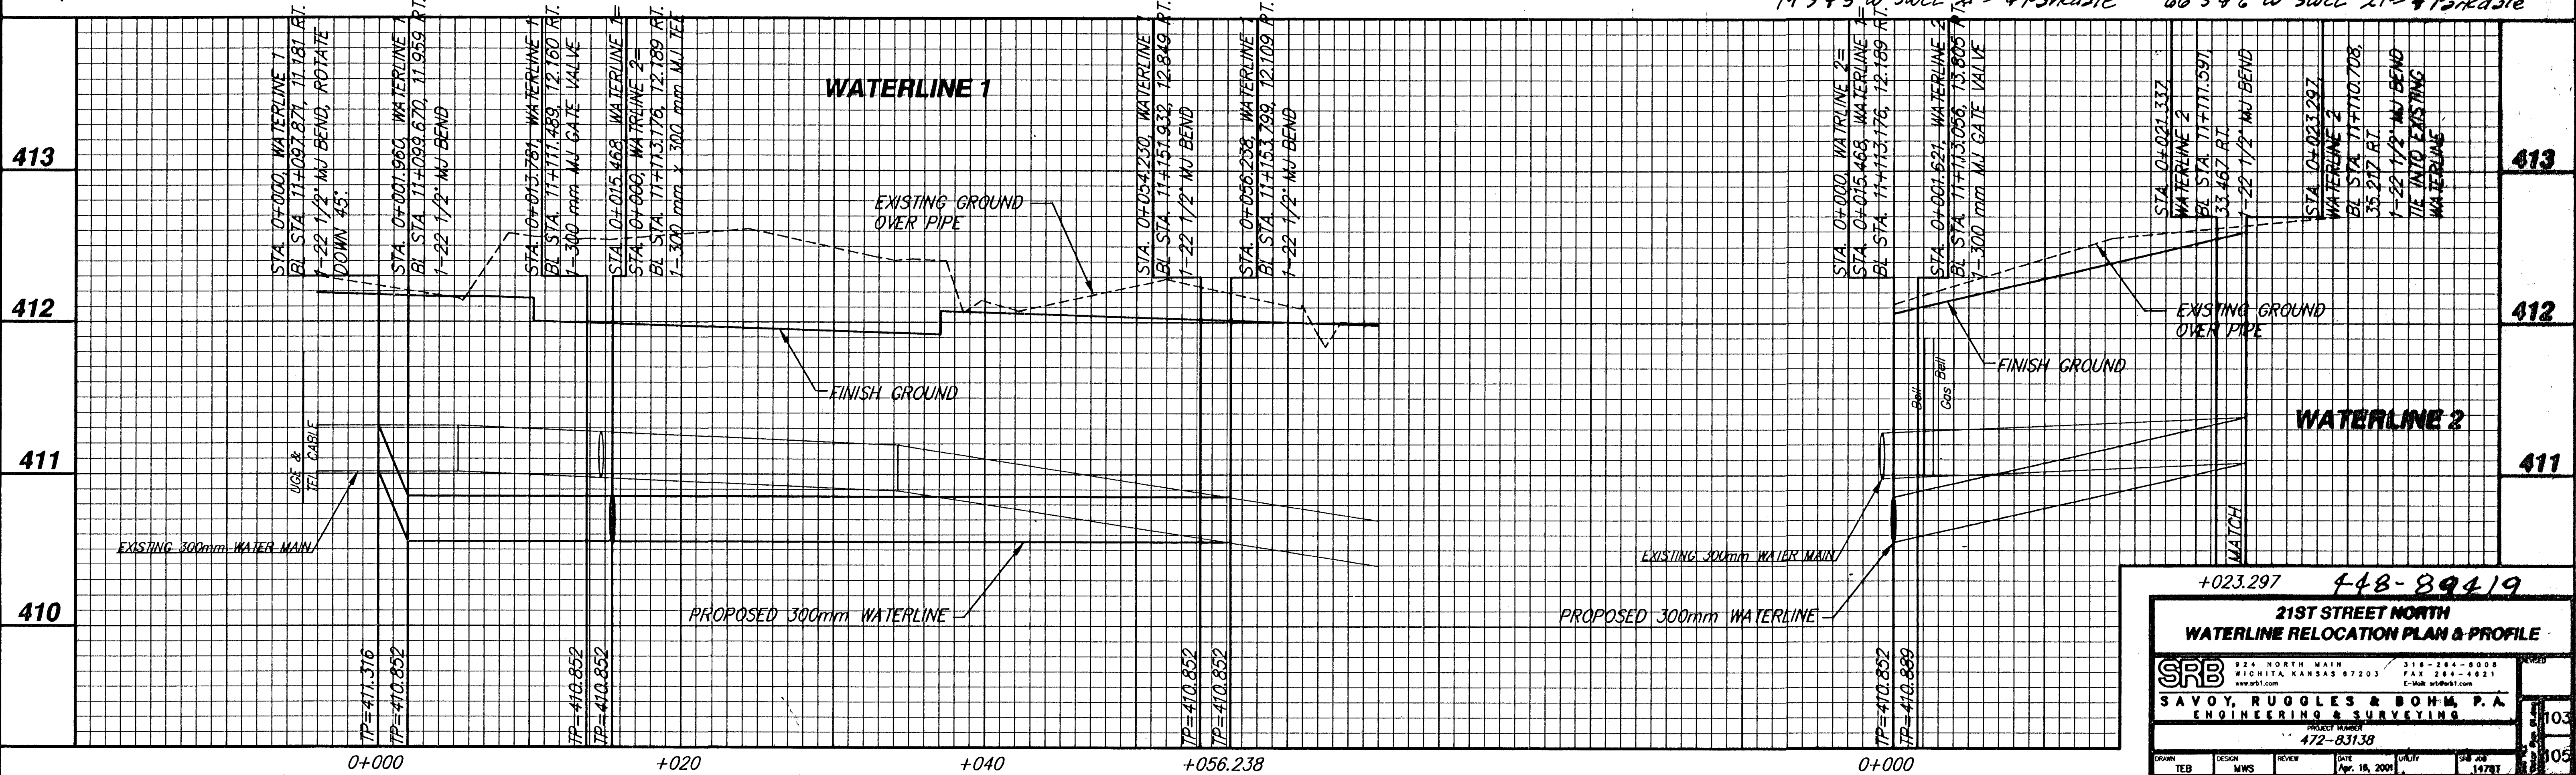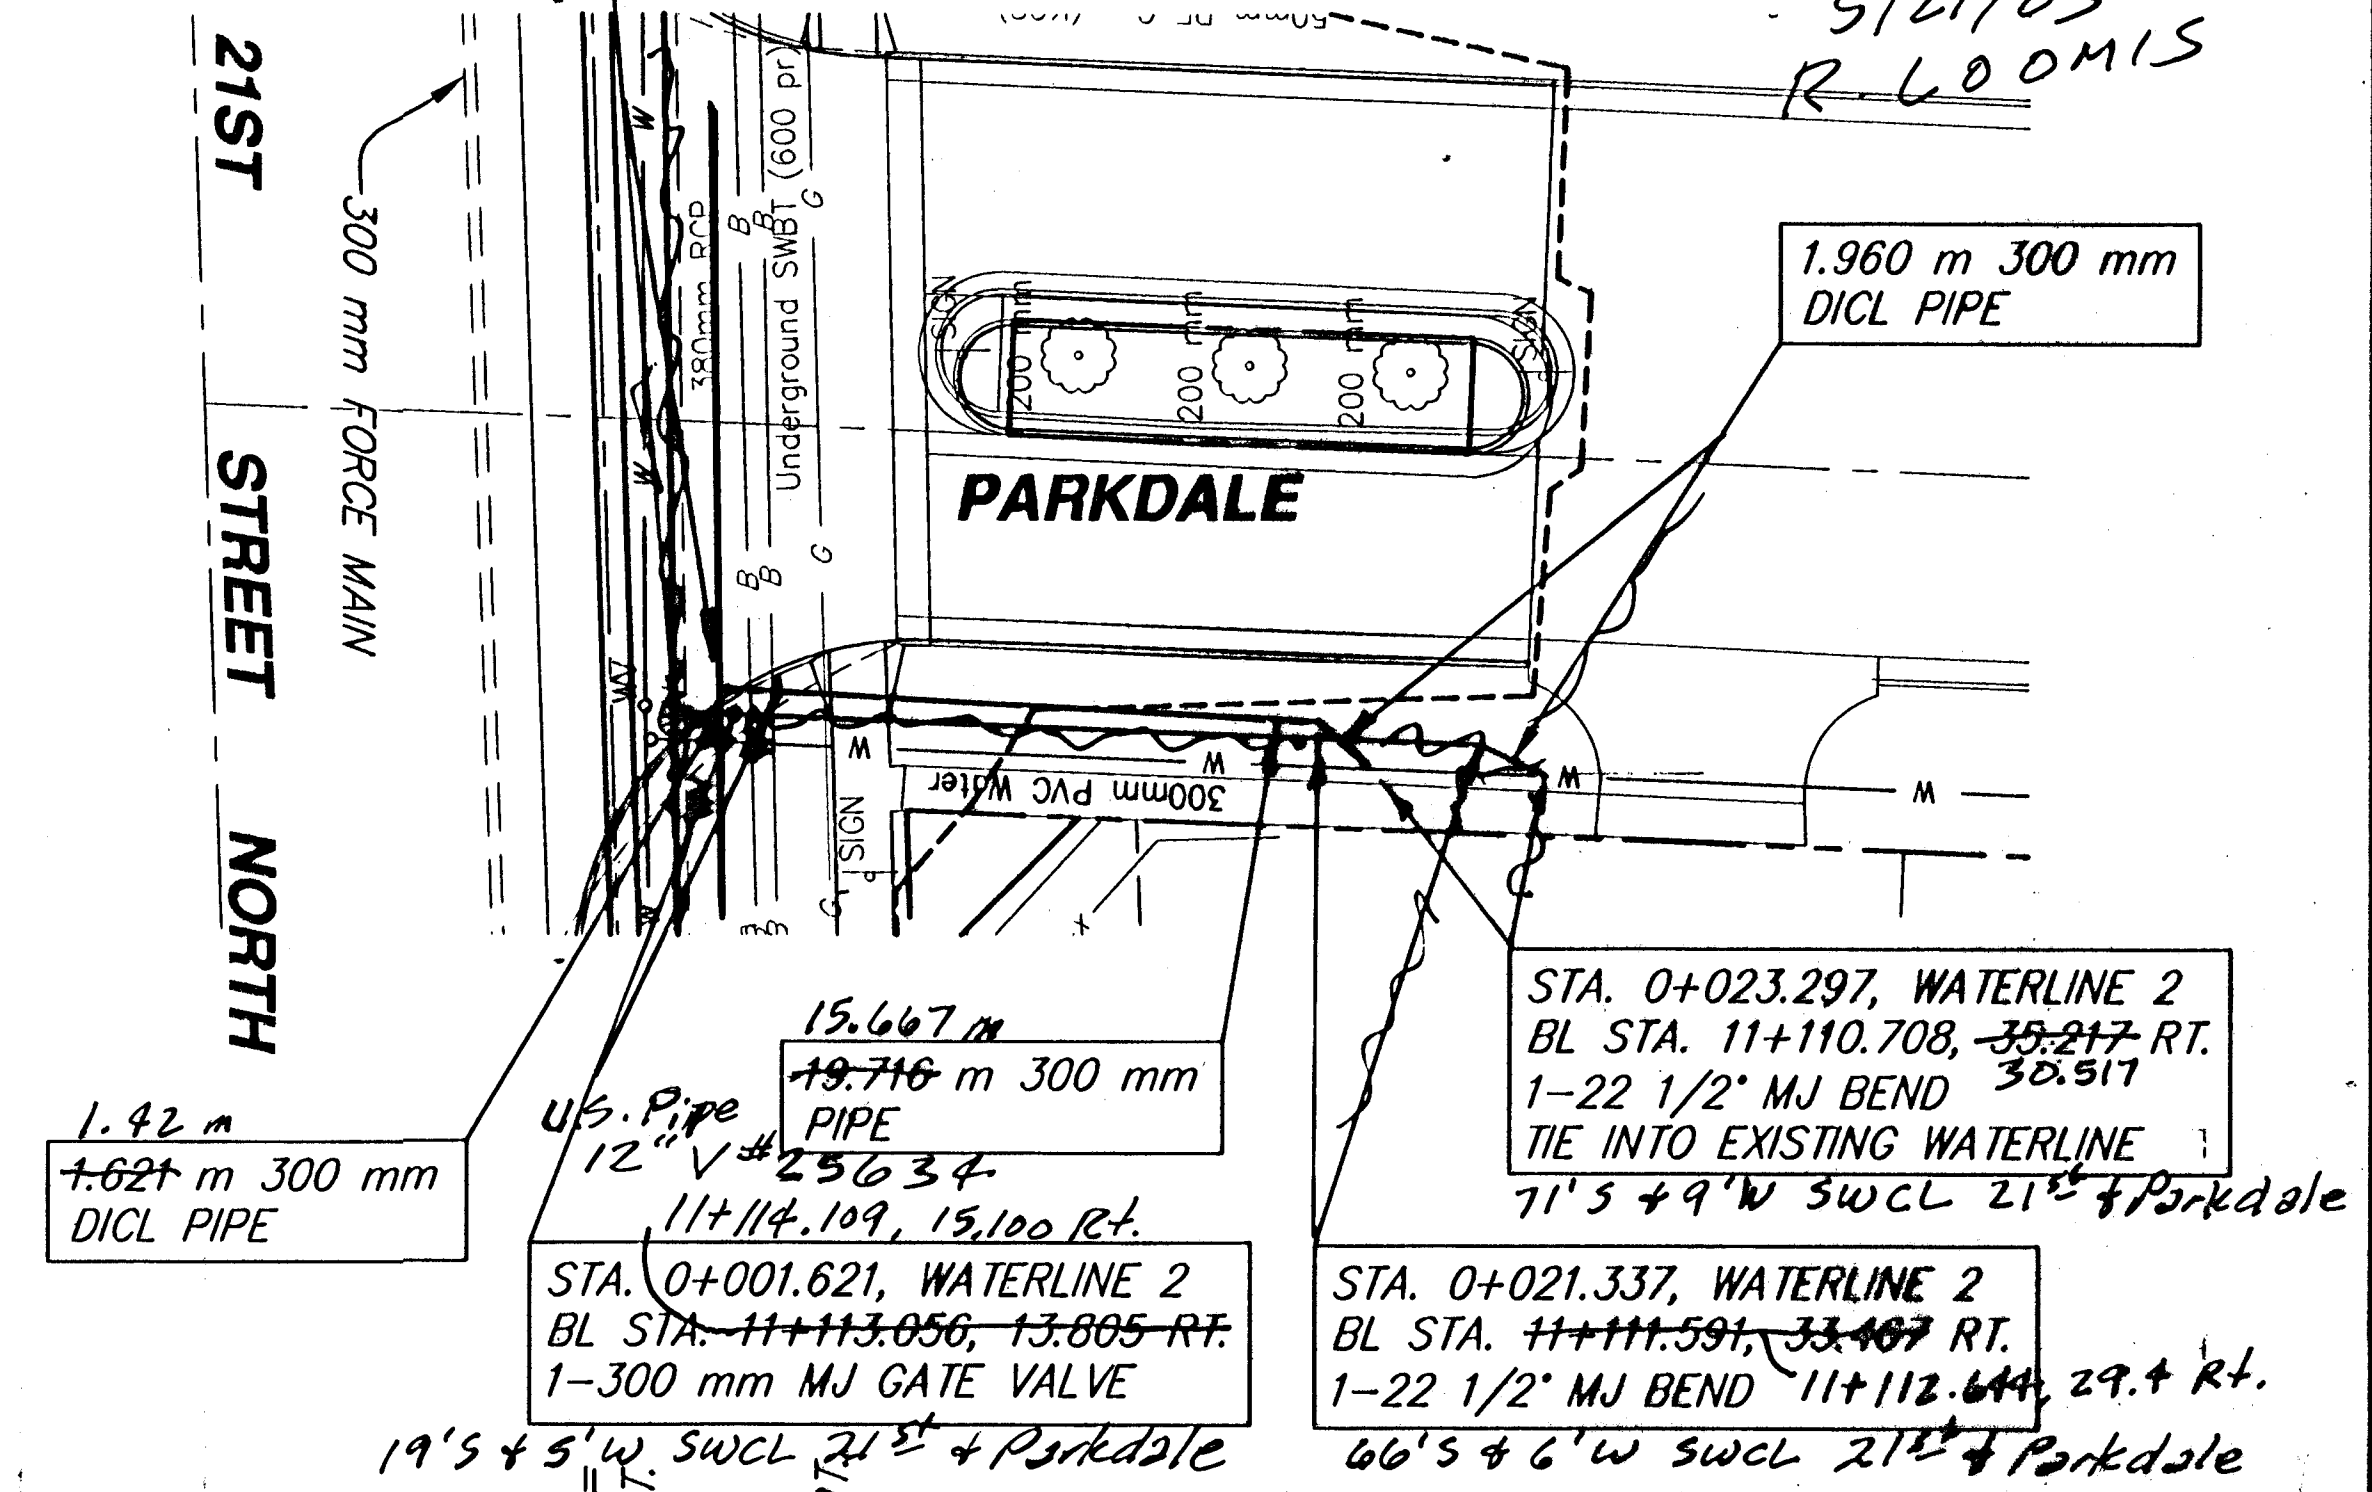

448-89419

21ST STREET NORTH
WATERLINE RELOCATION PLAN & PROFILE

SRB
SAVOY, RUGGLES & BOHM, P.A.
ENGINEERING & SURVEYING

PROJECT NUMBER
472-83138

DATE
Apr. 18, 2001

DESIGN
MWS

REVIEW
MWS

DATE
Apr. 18, 2001

SCALE
1:200

SHEET
103

TOTAL
105