

BENCHMARKS:
BM #1: COW BM at the SW corner of
Pawnee Ave. and Maize Road.
Elev. = 135.15 (City Datum)


BM #2: "□" in top of curb on the
north side of Yosemite, 65' east of
Maize Road.
Elev. = 143.67 (City Datum)

BM #3: COW BM at Shefford on the
south side of Pawnee Ave.
Elev. = 145.53 (City Datum)

P.V.I.
Elev. = 144.00
43.32' V.C.

P.V.I.
Elev. = 144.00
68.68' V.C.

Scale: 1" = 20'
• = Iron

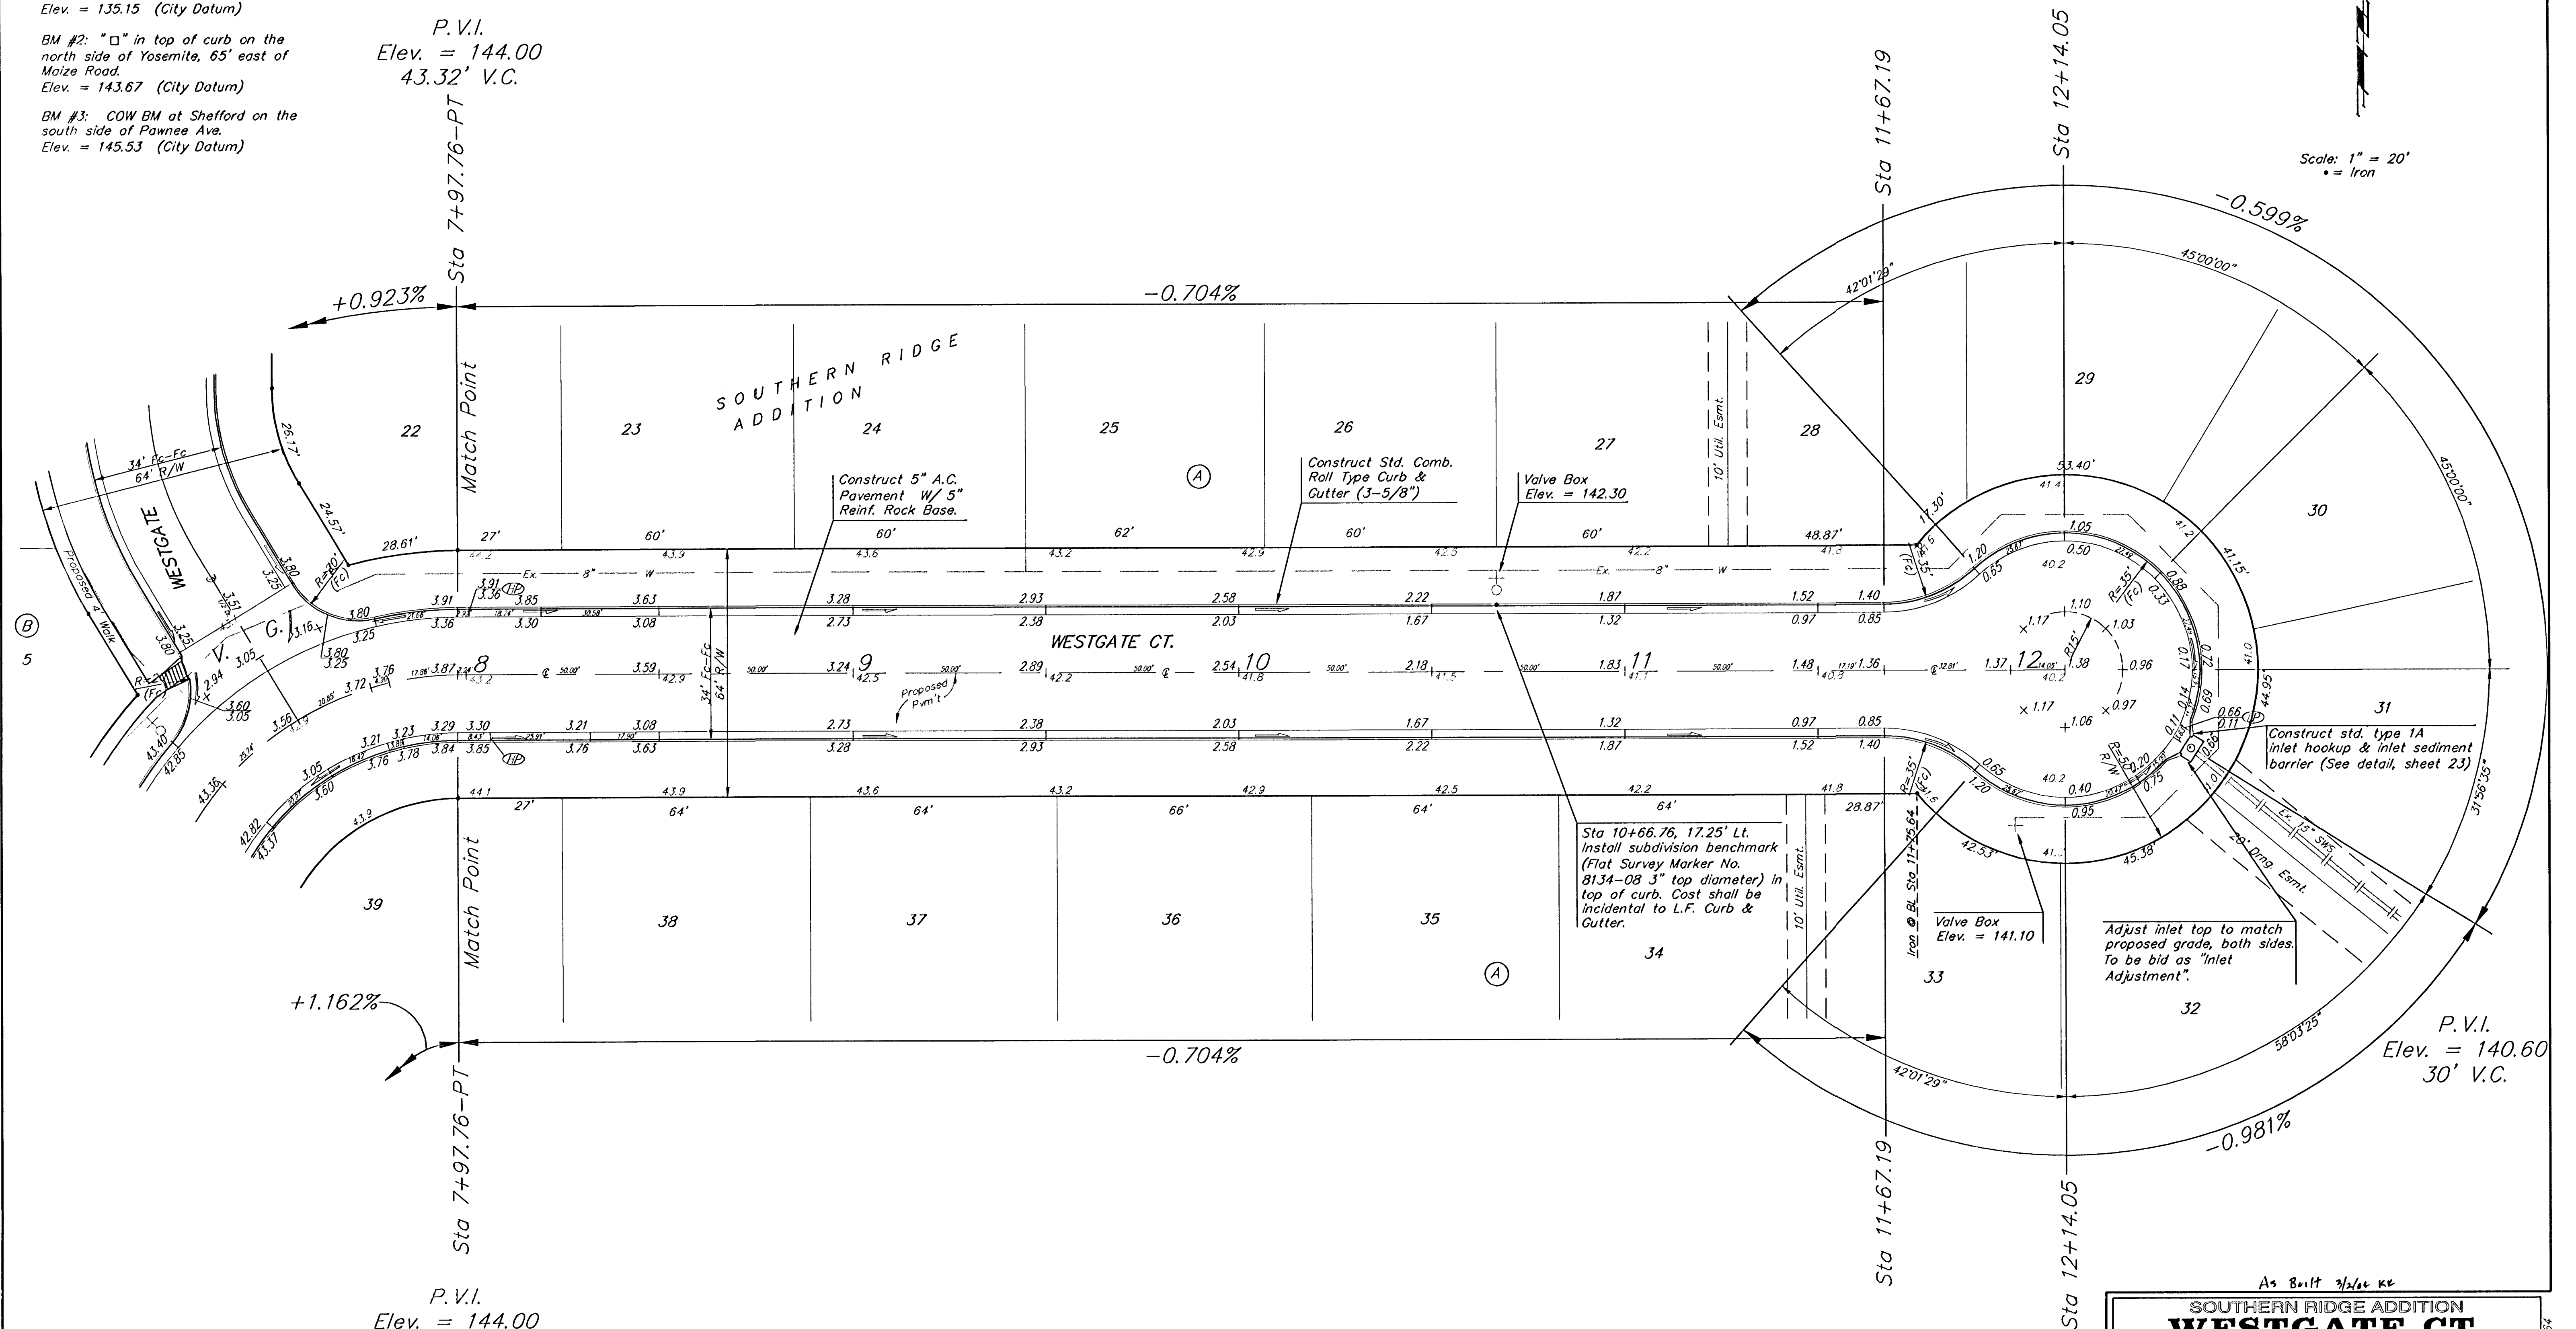

NOTE:
ROLL TYPE CURB & GUTTER TO
BE CONSTRUCTED ON THE
PAVEMENT SHOWN ON THIS SHEET.
TOP OF CURB ELEVATIONS ARE
GIVEN FOR FULL HEIGHT CURB.

As Built 3/5/06 KE

**SOUTHERN RIDGE ADDITION
WESTGATE CT.**
STA 7+97.76 TO STA 12+14.05

BAUGHMAN COMPANY P.A.
ENGINEERING, SURVEYING, & PLANNING
315-292-7271 • 315 ELLIS • WICHITA, KANSAS 67211

PROJECT NUMBER
472-83881

DESIGN NBW	DRAWN TMS	APPROVED	DATE 05/03	SCALE Noted	SHEET 12 OF 48
---------------	--------------	----------	---------------	----------------	-------------------------