


BENCHMARKS:
BM #1: COW BM at the SW corner of
Pawnee Ave. and Maize Road.
Elev. = 135.15 (City Datum)

BM #2: "□" in top of curb on the
north side of Yosemite, 65' east of
Maize Road.
Elev. = 143.67 (City Datum)

BM #3: COW BM at Shefford on the
south side of Pawnee Ave.
Elev. = 145.53 (City Datum)

P.V.I.
Elev. = 146.70
45.42' V.C.

Scale: 1" = 20'
• = Iron

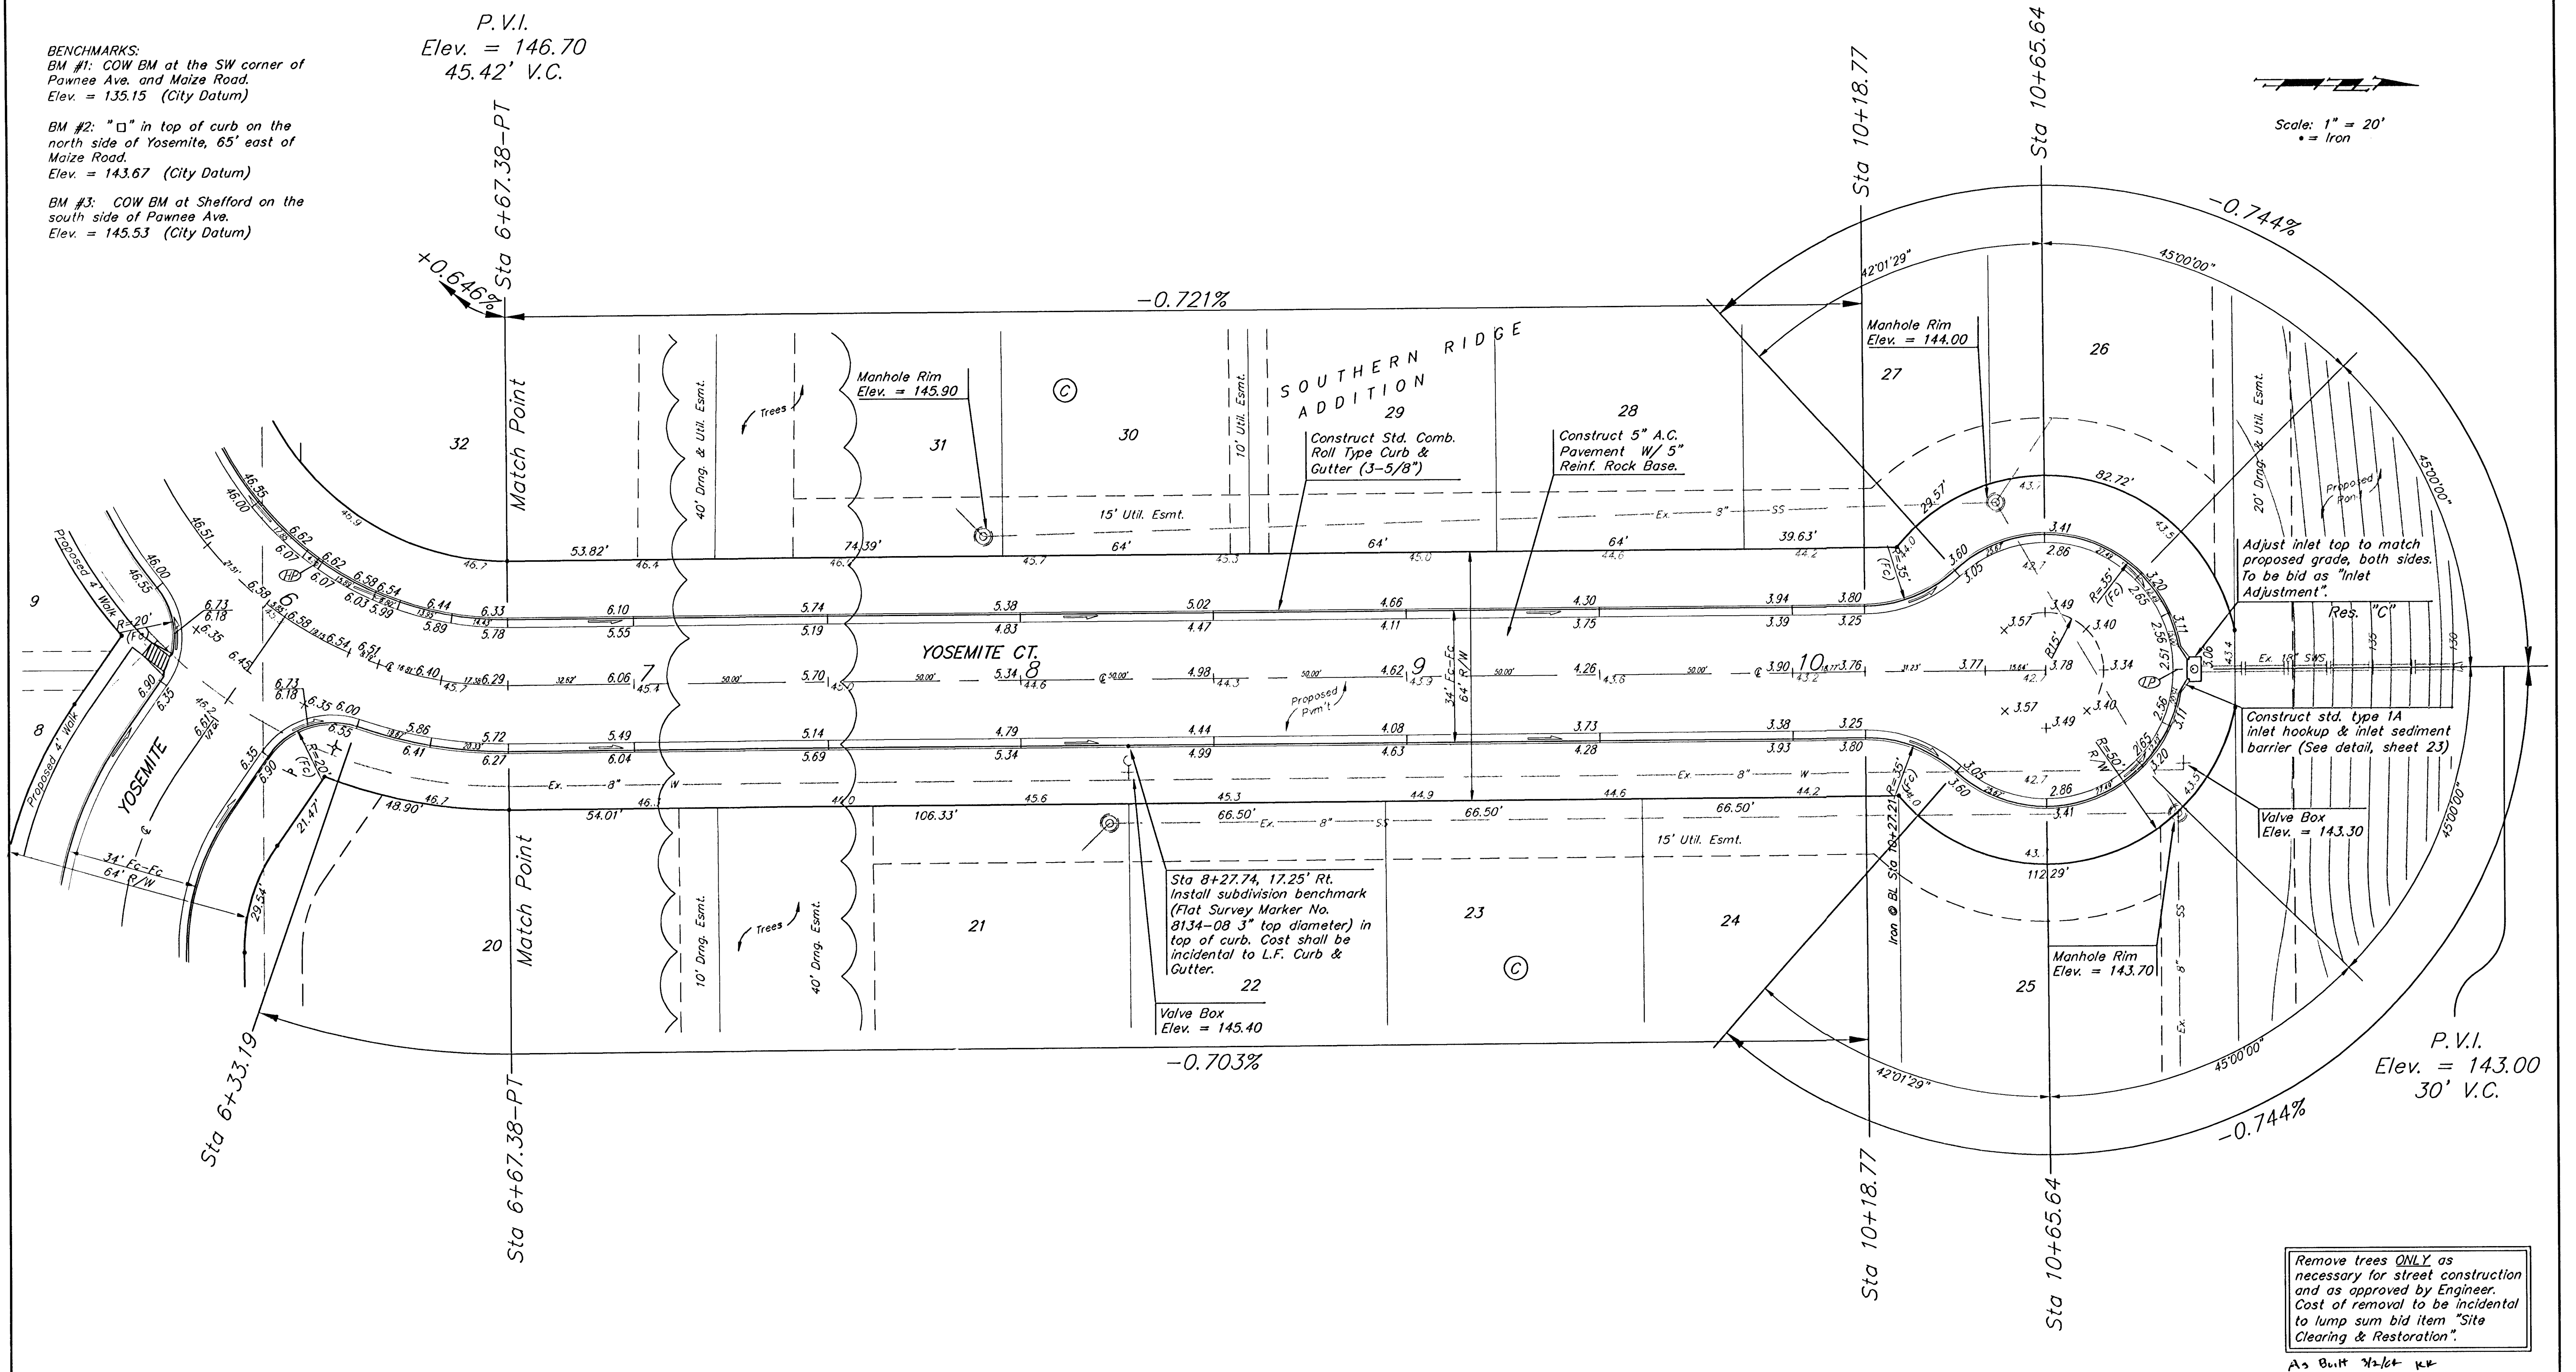

NOTE: ROLL TYPE CURB & GUTTER TO
BE CONSTRUCTED ON THE
PAVEMENT SHOWN ON THIS SHEET.
TOP OF CURB ELEVATIONS ARE
GIVEN FOR FULL HEIGHT CURB.

Remove trees ONLY as
necessary for street construction
and as approved by Engineer.
Cost of removal to be incidental
to lump sum bid item "Site
Clearing & Restoration".

As Built 1/2" = 1" PL

SOUTHERN RIDGE ADDITION
YOSEMITE CT.
STA 6+87.38 TO STA 10+85.64

BAUGHMAN COMPANY P.A.
ENGINEERING, SURVEYING, & PLANNING
318-262-7271 • 315 ELLIS • WICHITA, KANSAS 67211

PROJECT NUMBER
472-83881
DESIGN NBW DRAWN TMS APPROVED DATE 05/03 SCALE Noted
SHEET **15** OF **48**