

BENCHMARKS:
BM #1: COW BM at the SW corner of
Pawnee Ave. and Maize Road.
Elev. = 135.15 (City Datum)


BM #2: "□" in top of curb on the
north side of Yosemite, 65' east of
Maize Road.
Elev. = 143.67 (City Datum)

BM #3: COW BM at Shefford on the
south side of Pawnee Ave.
Elev. = 145.53 (City Datum)

P.V.I.
Elev. = 147.86
No V.C.

P.V.I.
Elev. = 146.20
27.74' V.C.

Scale: 1" = 20'
• = Iron

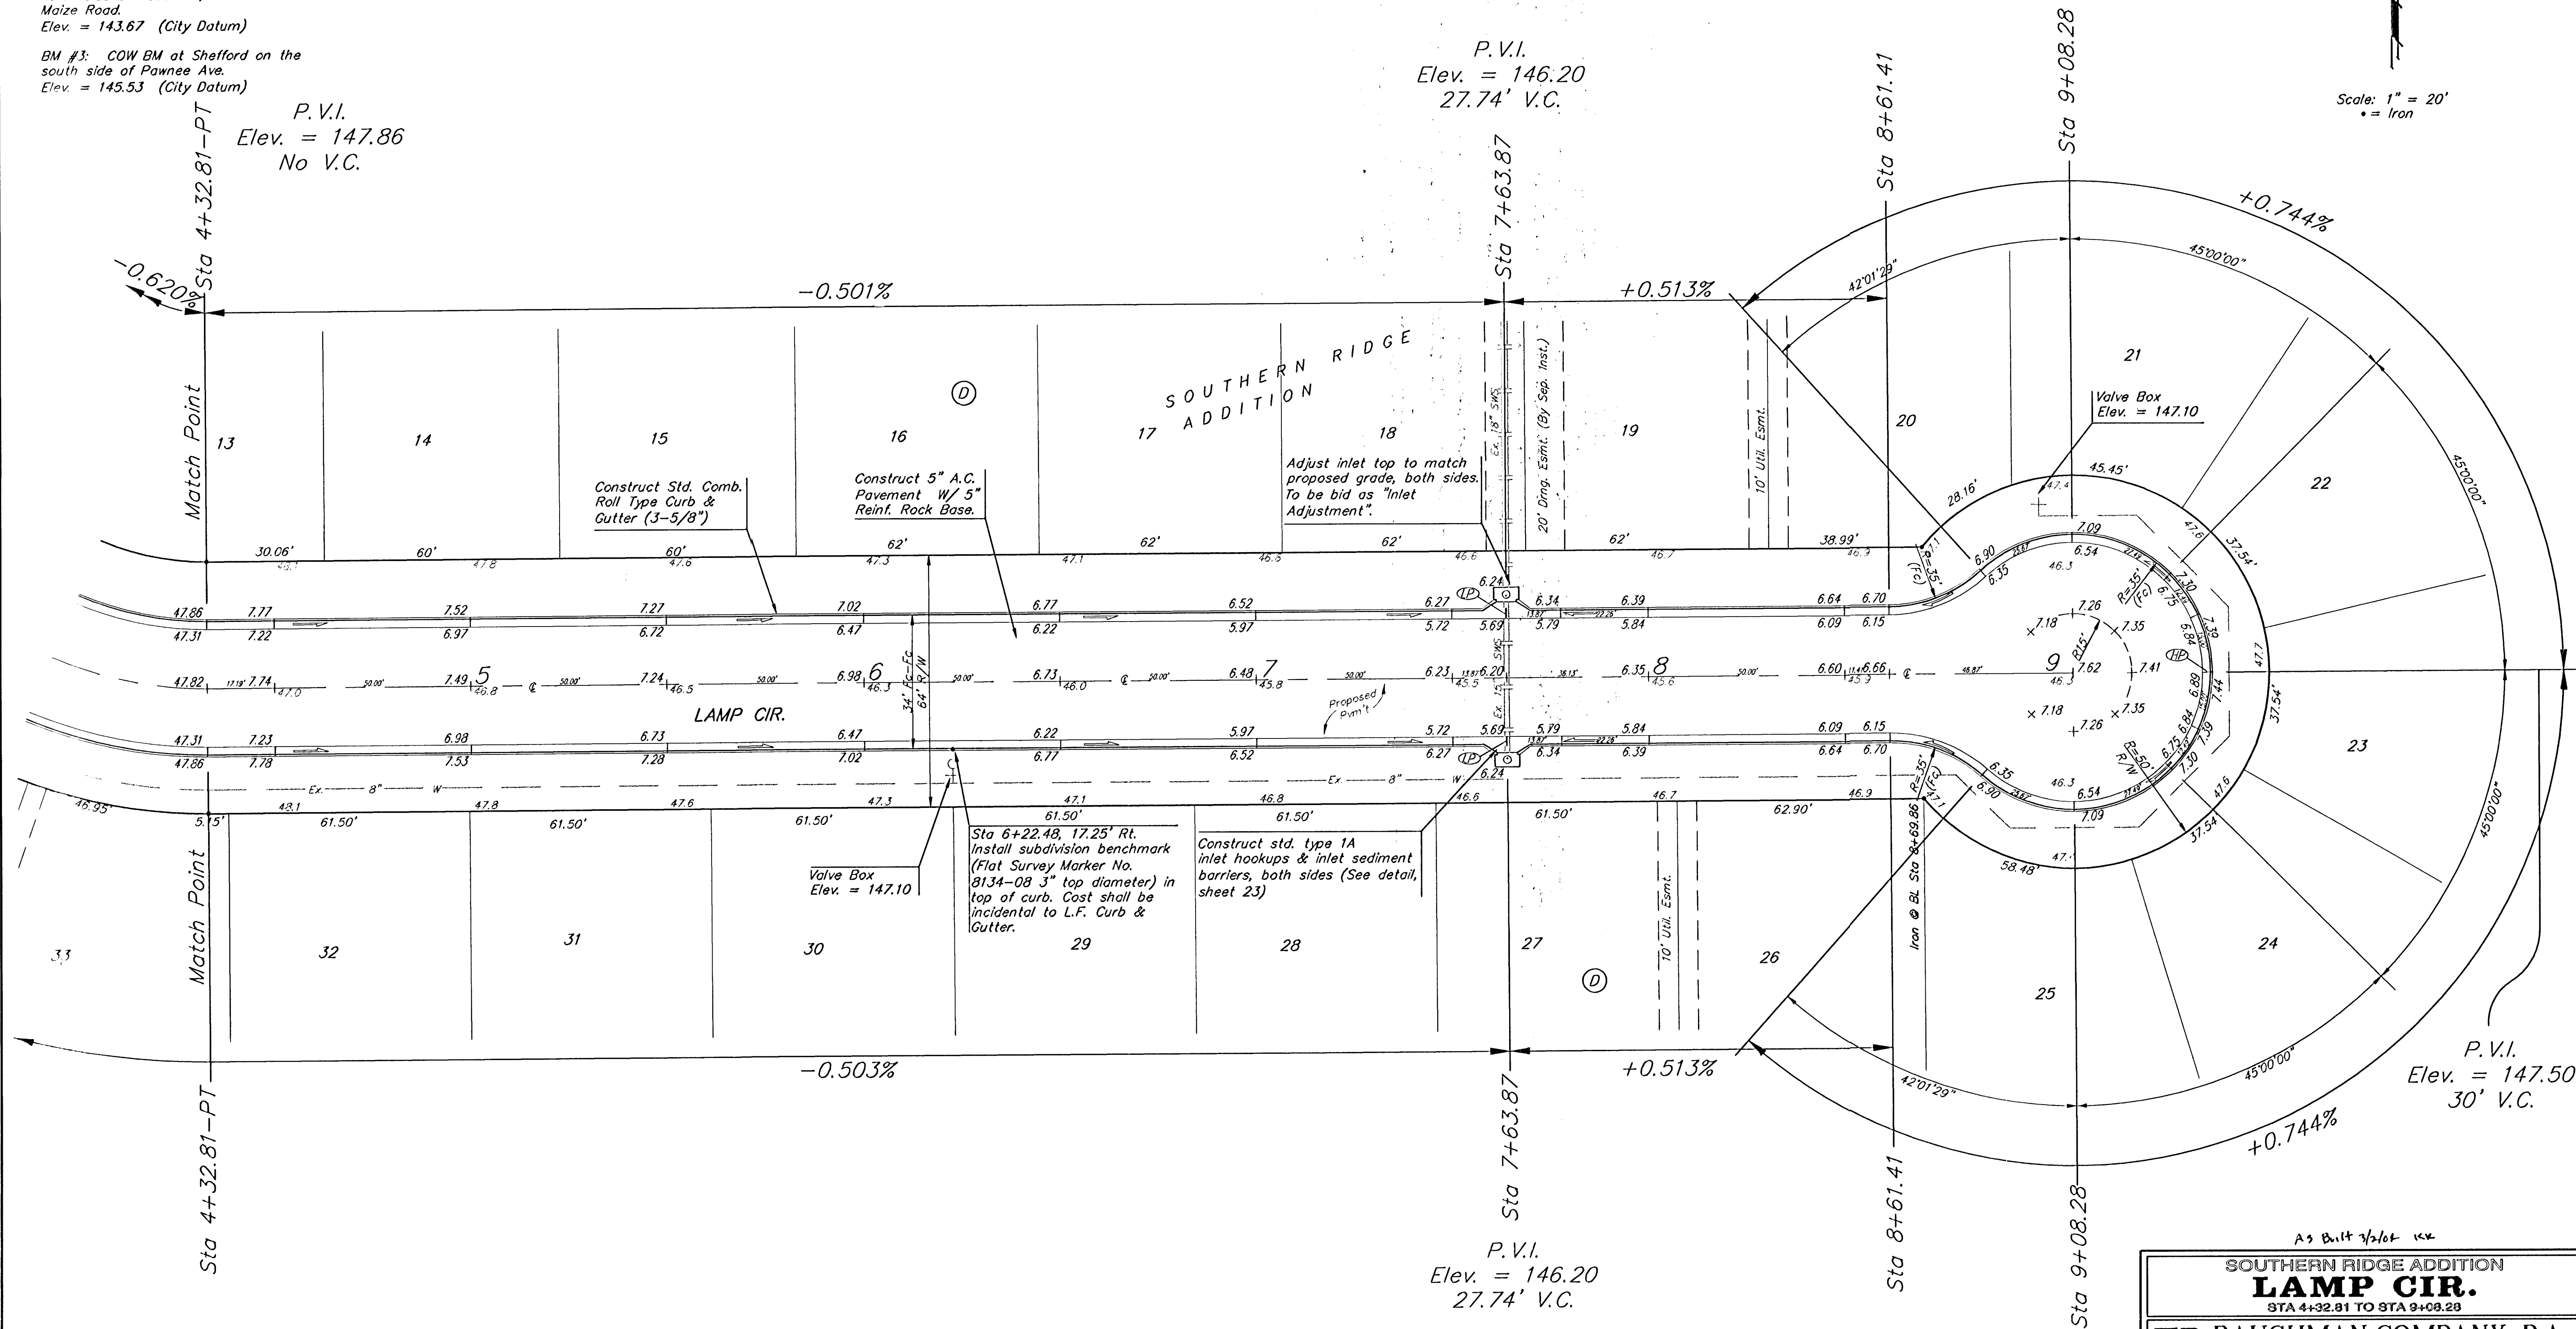

NOTE: ROLL TYPE CURB & GUTTER TO
BE CONSTRUCTED ON THE
PAVEMENT SHOWN ON THIS SHEET.
TOP OF CURB ELEVATIONS ARE
GIVEN FOR FULL HEIGHT CURB.

As Built 7/2/04 KKK

**SOUTHERN RIDGE ADDITION
LAMP CIR.**
STA 4+32.81 TO STA 9+08.28

BAUGHMAN COMPANY P.A.
ENGINEERING, SURVEYING, & PLANNING
316-262-7271 • 315 ELLIS • WICHITA, KANSAS 67211

PROJECT NUMBER
472-83881

DESIGN NBW	DRAWN TMS	APPROVED	DATE 05/03	SCALE Noted	SHEET 19 OF 48
---------------	--------------	----------	---------------	----------------	---------------------------------------