


RR Spike in N. Face of PP in
N. R/W of Maple N. of Nineiron.
Elev. = 177.01 (City Datum)

"□" Cut center of north
Headwall of RCBG in N. R/W of
Maple 570' East of centerline
of City View.
Elev. = 187.91 (City Datum)

P.V.I.
Elev. = 190.00
No V.C.

P.V.I.
Elev. = 183.50
72' V.C.

Scale: 1" = 20'
• = Iron

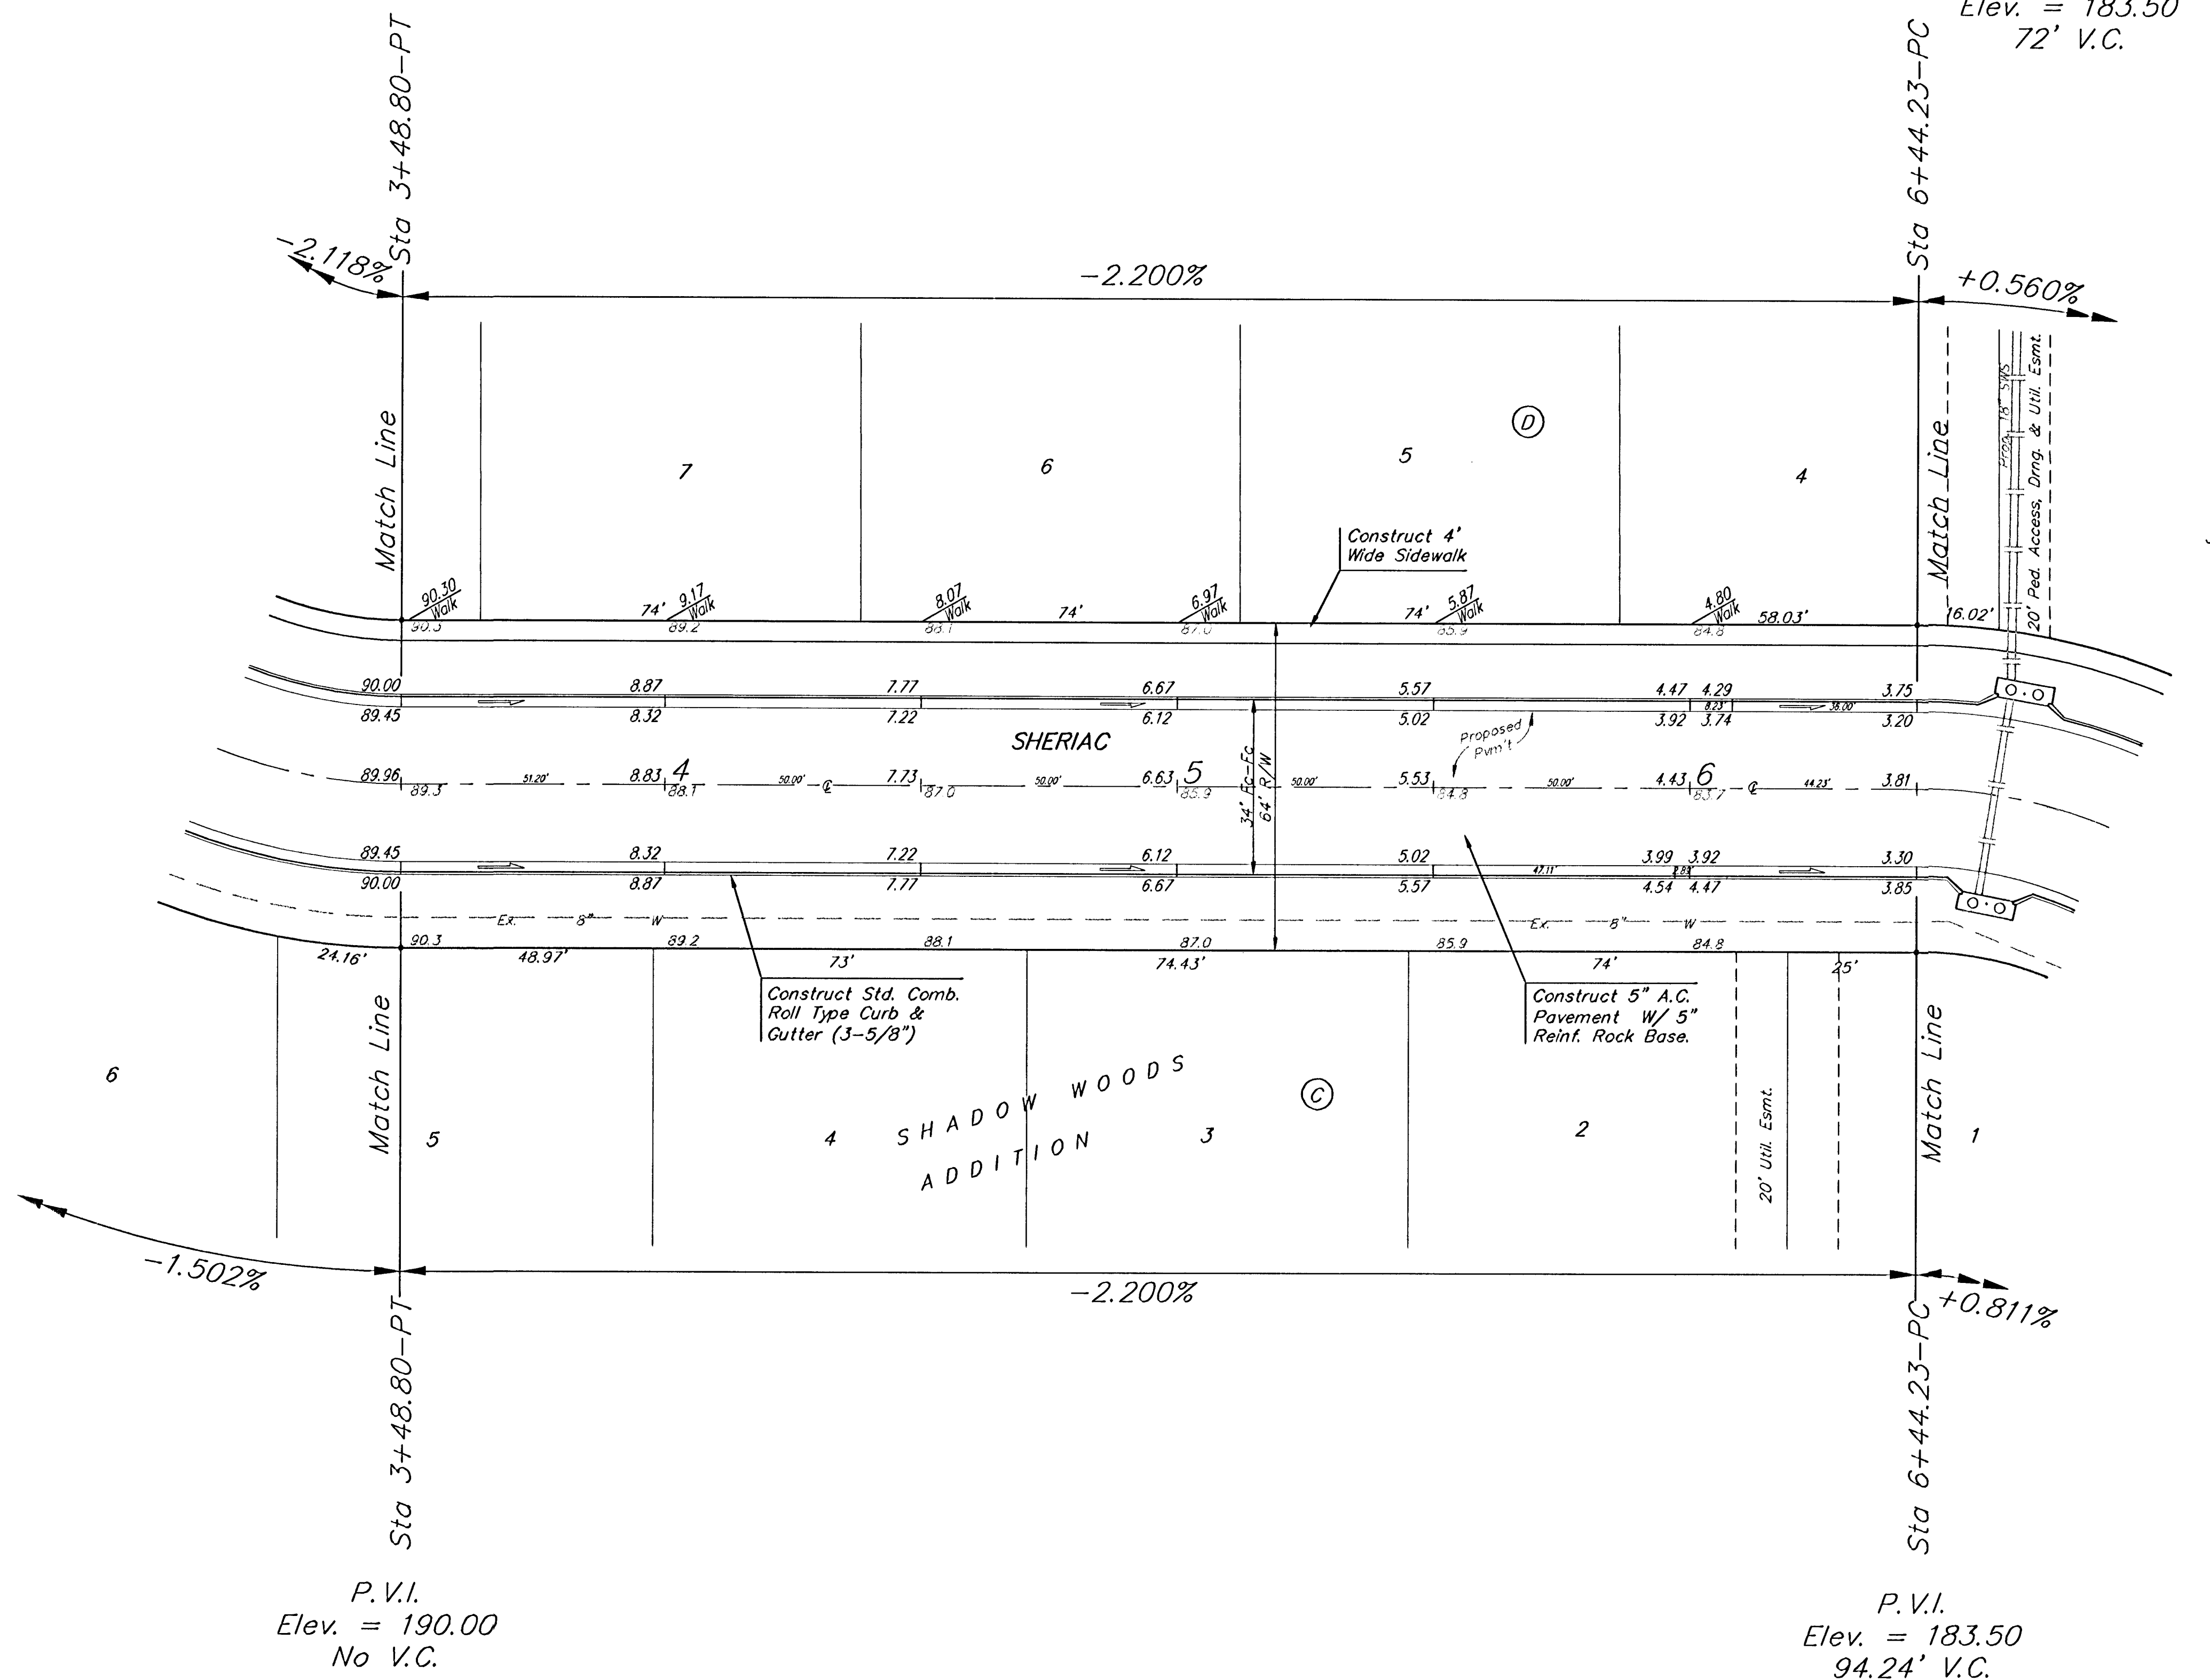

P.V.I.
Elev. = 190.00
No V.C.

P.V.I.
Elev. = 183.50
94.24' V.C.

Subdivision Bench Marks		
Street & Station	Location Description	Elevation
Sheriac Cir. 1+78.01, 14.25' Lt.	Adjacent to Fire Hydrant between Lots 17-18, Block C.	
Decker 0+31.90, 17.25' Rt.	Adjacent to Fire Hydrant at E. End of S. Curb Return of Sheriac & Decker.	
Decker Ct. 0+32.71, 14.25' Rt.	Adjacent to Fire Hydrant at E. End of S. Curb Return of Decker & Decker Ct.	

NOTE: ROLL TYPE CURB & GUTTER TO BE CONSTRUCTED ON THE PAVEMENT SHOWN ON THIS SHEET. TOP OF CURB ELEVATIONS ARE GIVEN FOR FULL HEIGHT CURB.

As Built

SHADOW WOODS ADDITION - PHASE IA
SHERIAC
STA 3+48.80 TO STA 6+44.23

BAUGHMAN COMPANY P.A.
ENGINEERING, SURVEYING, & PLANNING
319-262-7271 • 312 ELLIS • WICHITA, KANSAS 67211

PROJECT NUMBER
472-83721

DESIGN NDW DRAWN TMS APPROVED DATE 05-28-03 SCALE Noted

SHEET
8
OF
37