


RR Spike in N. Face of PP in
N. R/W of Maple N. of Nineiron.
Elev. = 177.01 (City Datum)

"□" Cut center of north
Headwall of RCB in N. R/W of
Maple 570' East of centerline
of City View.
Elev. = 187.91 (City Datum)

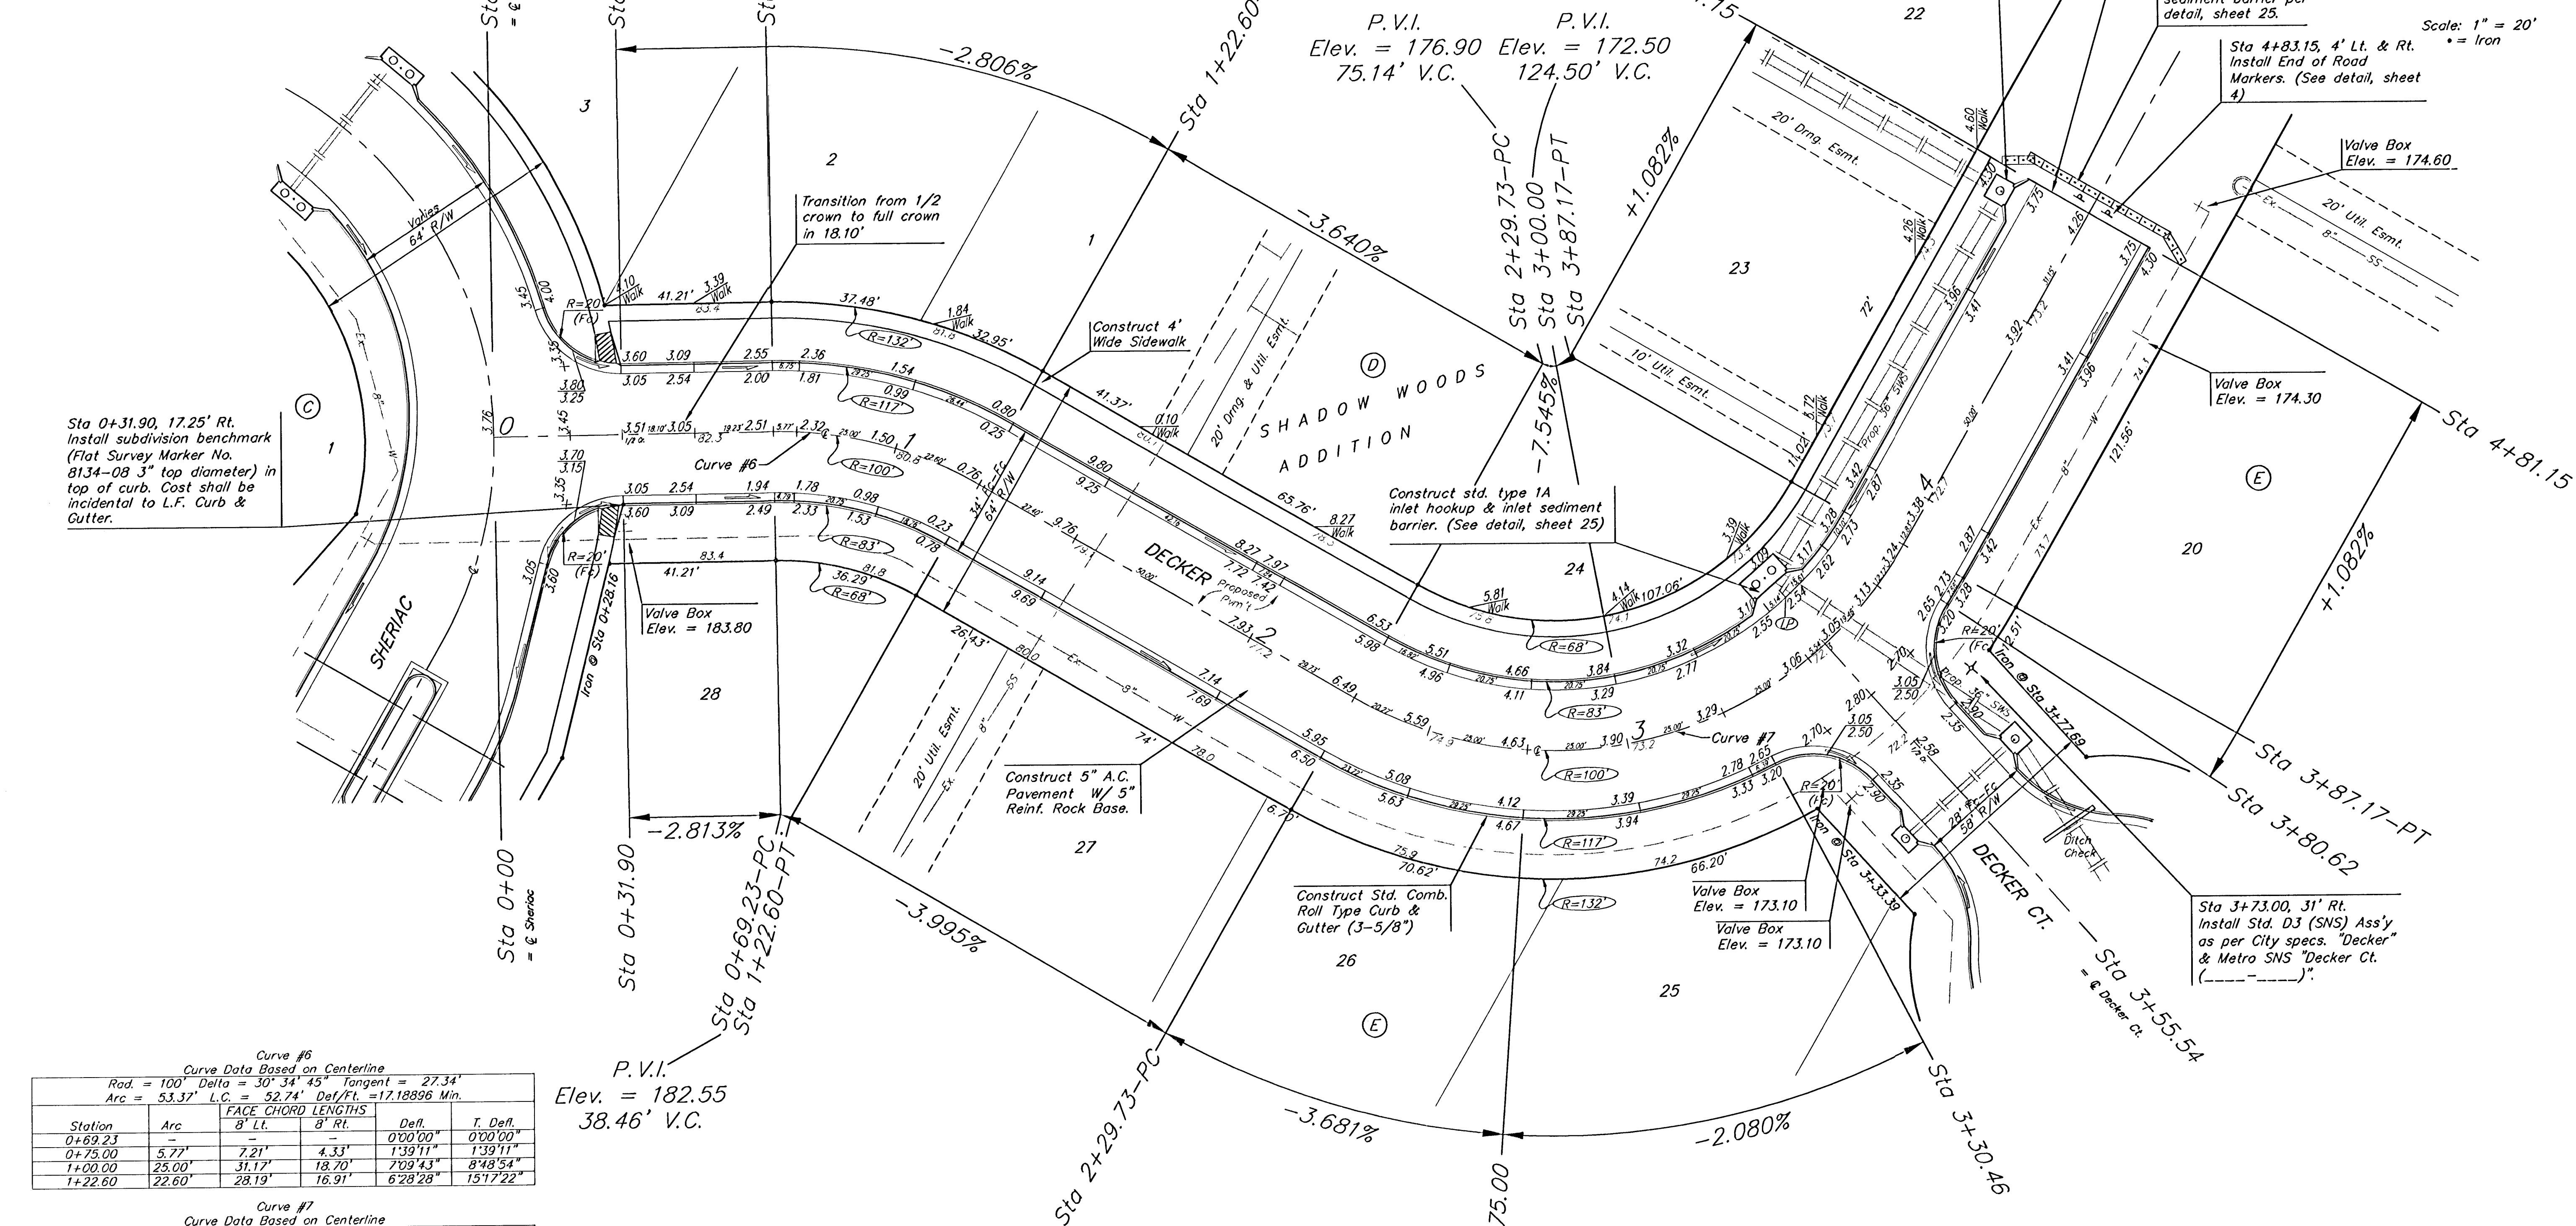

Curve #6
Curve Data Based on Centerline
Rad. = 100' Delta = 30° 34' 45" Tangent = 27.34'
Arc = 53.37' L.C. = 52.74' Def/Ft. = 17.18896 Min.

Station	Arc	FACE CHORD LENGTHS 8' Lt. 8' Rt.	Def.	T. Def.
0+69.23	-	-	0'00'00"	0'00'00"
0+75.00	5.77'	7.21' 4.33'	1'39'11"	1'39'11"
1+00.00	25.00'	31.17' 18.70'	7'09'42"	8'48'54"
1+22.60	22.60'	28.19' 16.91'	6'28'28"	15'17'22"

Curve #7
Curve Data Based on Centerline
Rad. = 100' Delta = 90° 12' 16" Tangent = 100.36'
Arc = 157.44' L.C. = 141.67' Def/Ft. = 17.18835 Min.

Station	Arc	FACE CHORD LENGTHS 8' Lt. 8' Rt.	Def.	T. Def.
2+29.73	-	-	0'00'00"	0'00'00"
2+50.00	20.27'	15.18' 25.29'	5'48'24"	5'48'24"
2+75.00	25.00'	18.70' 31.17'	7'09'42"	12'58'02"
3+00.00	25.00'	18.70' 31.17'	7'09'42"	20'07'49"
3+25.00	25.00'	18.70' 31.17'	7'09'42"	27'17'39"
3+50.00	25.00'	18.70' 31.17'	7'09'42"	34'27'29"
3+75.00	25.00'	18.70' 31.17'	7'09'42"	41'37'19"
4+00.00	25.00'	18.70' 31.17'	7'09'42"	48'47'09"

NOTE:
ROLL TYPE CURB & GUTTER TO
BE CONSTRUCTED ON THE
PAVEMENT SHOWN ON THIS SHEET.
TOP OF CURB ELEVATIONS ARE
GIVEN FOR FULL HEIGHT CURB.

As Built
SHADOW WOODS ADDITION - PHASE 1A
DECKER
STA 0+00 TO STA 4+81.15

BAUGHMAN COMPANY P.A.
ENGINEERING, SURVEYING, & PLANNING
316-202-7271 • 315 ELLIS • WICHITA, KANSAS 67211

PROJECT NUMBER
472-83721

DESIGN NBW DRAWN TMS APPROVED DATE 05-28-03 SCALE Noted

SHEET
11
OF
37