

1745 PPS

47TH STREET SOUTH

STAGE STORAGE FOR RETENTION DAM

Elev.	Acres	Ac. Ft.
59.0	0	0
60.0	0.041	0.0205
62.0	0.586	0.0647
64.0	1.692	2.782
66.0	3.168	7.642
68.0	4.740	15.550
Top of Dike 70.0	5.850	26.140

NOTE:

Flood routed 100yr 24hr storm with NRCS Site program 15.3 Ac. Ft. @ Elev. 68.0.

RUNOFF FROM K-MART

Q5yr = 35 cfs
Q100yr 24hr = 59 cfs
Q38" x 24" HE STORM SEWER = 34 cfs
C = 0.90 (DEVELOPED)



RUNOFF FROM LOT 1

Q5yr = 18 cfs
Q100yr 24 hr = 30 cfs
Q 36" SPIRAL CMP = 35 cfs
C = 0.90 (DEVELOPED)

COMBINED

SEC. A-A Q_s = 35 + 0 - 34 = 1 cfs
SEC. A-A Q₁₀₀ = 59 + 0 - 34 = 25 cfs
SEC. B-B Q_s = 35 + 11 - 34 = 12 cfs
SEC. B-B Q₁₀₀ = 59 + 19 - 34 = 44 cfs
SEC. C-C Q_s = 35 + 18 - 34 = 19 cfs
SEC. C-C Q₁₀₀ = 59 + 30 - 34 = 55 cfs

SCALE: 1" = 100'

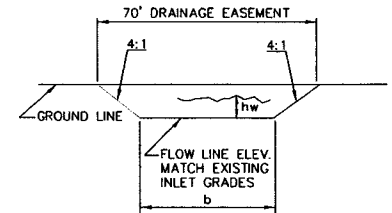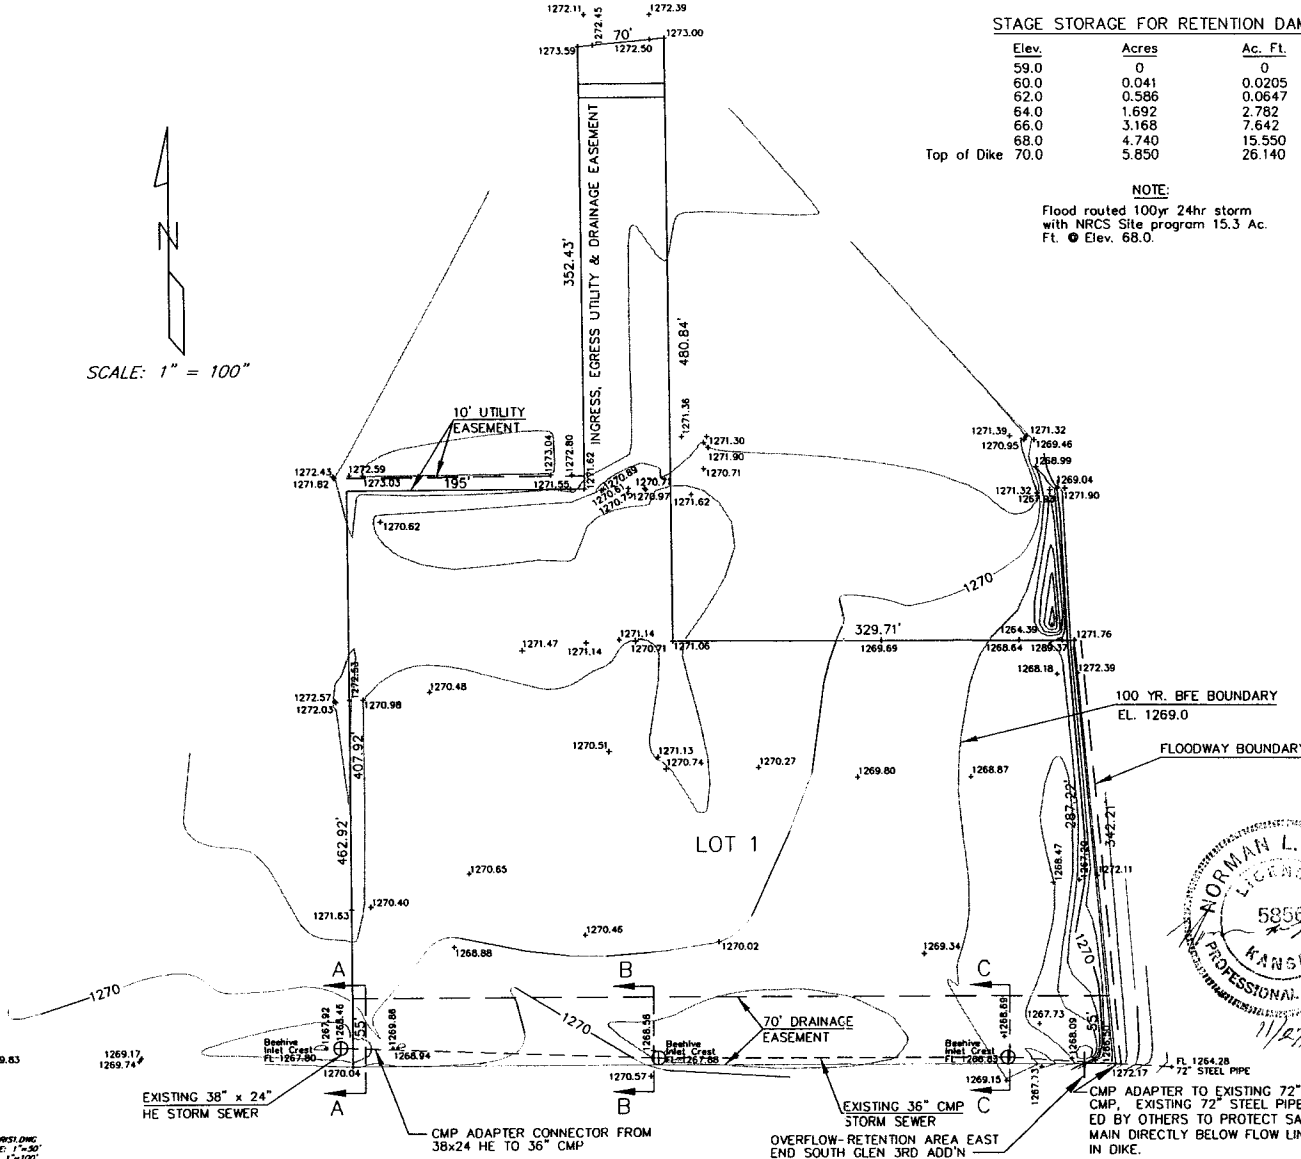

TYPICAL SECTION OF DRAINAGE EASEMENT

NOT TO SCALE
VEGETATED n = 0.30

	Q	b	hw	s
SEC. A-A	25	50'	0.5'	.001
SEC. B-B	44	64'	0.6'	.001
SEC. C-C	55	64'	0.7'	.001

REVISED: 11/20/06

AS BUILT

DRAINAGE IMPROVEMENTS

47TH STREET SOUTH @ EMPORIA, LOT 1, SOUTH GLEN, 3RD ADDITION, SEDGWICK COUNTY, WICHITA, KANSAS.

NLR & gb Engineering Technology

Design, Survey, Cadd & Construction

10405 Ringer Drive
Wichita, Kansas 67209
Phone: (316) 722-8517

SCALE:	DATE:	PROJ. NO.:	DES.:	DWG.:	CHECK.:	APP.:
1" = 100'	APRIL 2006	30093-KS	NLR	GB	NLR	NLR

Sheet 1 of 1

Last Plot-Date: 11/20/06

DR. GB

DES.

PLOT CADD

DR. GB

DES.

PLOT CADD

DES.

PLOT CADD

DES.

PLOT CADD

30093-KS-001
PROJ. SCALE: 1"=30'
PLOT SCALE: 1"=100'