


SCALE: 1"=20'

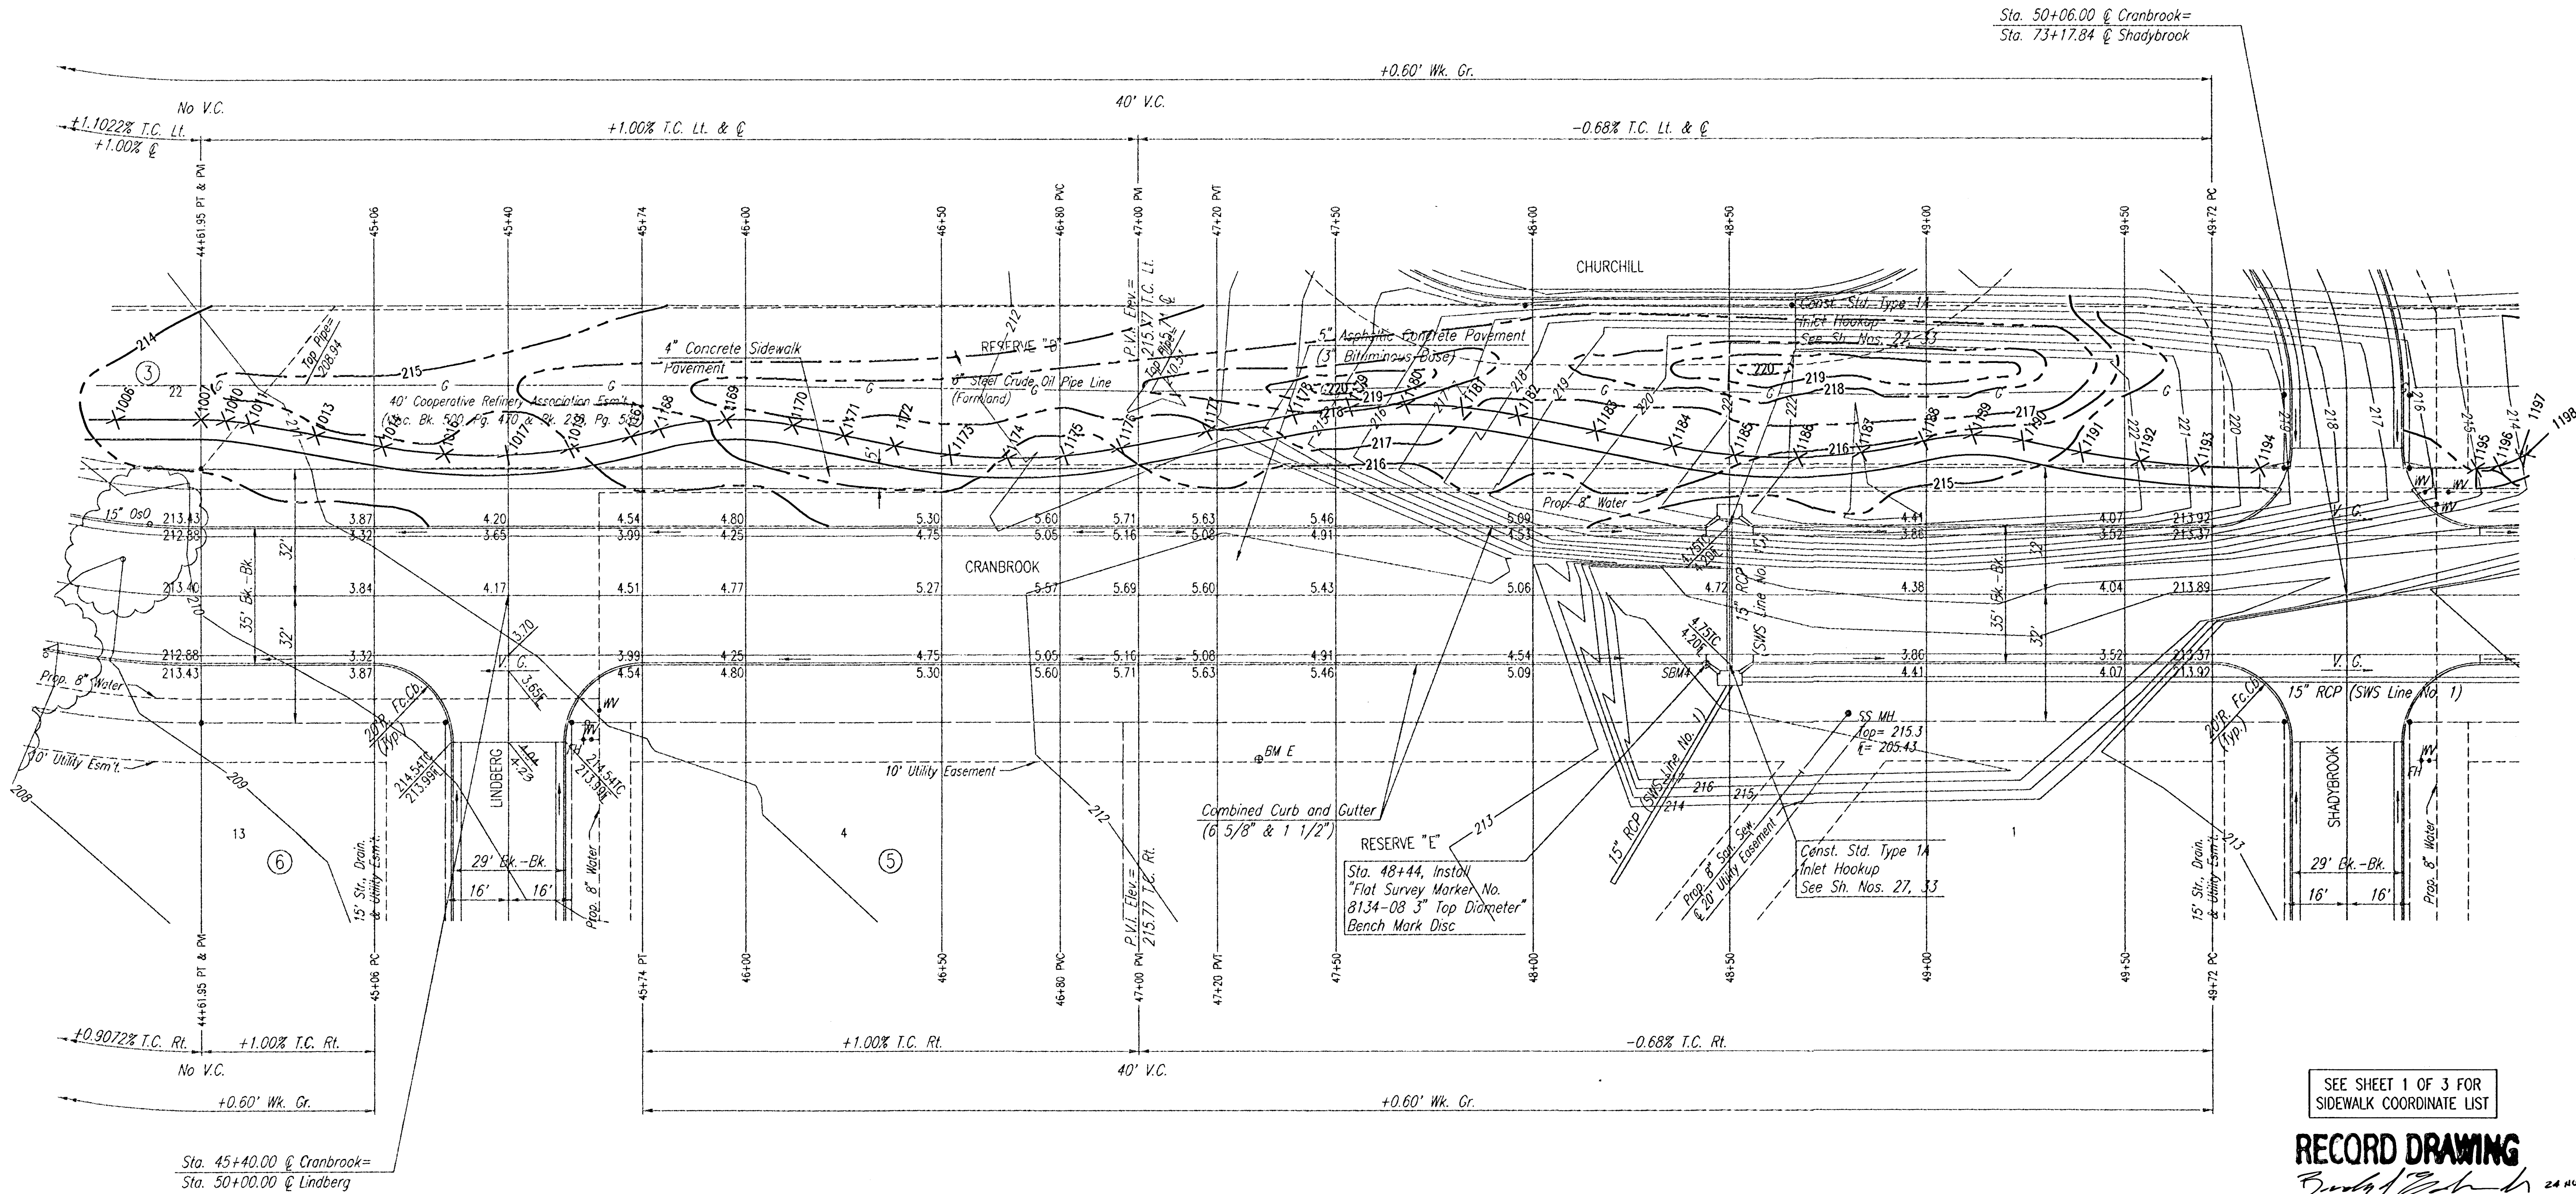

SEE SHEET 1 OF 3 FOR
SIDEWALK COORDINATE LIST

RECORD DRAWING

24 NOV 03

REMINGTON PLACE - PHASE 2

CRANBROOK
STA. 44+61.95 TO STA. 49+72.00
(REVISED WALK)
SHEET 2 OF 3



Professional Engineering Consultants, P.A.

303 S. TOPEKA • WICHITA, KANSAS 67202
316-262-2691 • FAX 316-262-3003

Designed by	BER	Checked by	
Drawn by	DEP	Date	DEC., 2002
		Job No.	02398