


WATER VALVE BOX ELEVATIONS			
STREET	STATION	OFFSET	PROPOSED ELEVATION
19TH STREET NORTH	65+02.44	23.0'LL	210.1
19TH STREET NORTH	65+05.44	26.0'LL	210.0
19TH STREET NORTH	69+78.44	24.0'LL	211.9

$$\frac{\text{Sta. } 70+15.44 \text{ @ } 19\text{th St. N=}}{\text{Sta. } 42+69.42 \text{ @ Cranbrook}}$$


RECORD DRAWING
Budy E. Eshel 24 Nov 03
REMINGTON PLACE - PHASE 2

19TH STREET NORTH
STA. 64+45.44 TO STA. 69+78.44

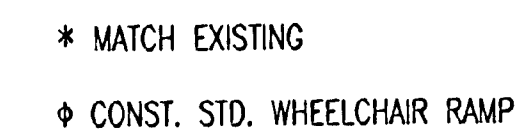

Professional Engineering Consultants, P.A.
 303 S. TOPEKA • WICHITA, KANSAS 67202
 316-262-2691 • FAX 316-262-3003

Designed by	BER	Checked by	
Drawn by	DEP	Date DEC., 2002	Job No. 02398

DSNR: DEP OPER: DEP SCALE: 1=20.00
Q:\2002\02398\000\ 19THS1 12-03-2002 03:16:08 pm