



PROJECT NO.	SHEET NO.	TOTAL SHEETS
472-83378	12	50

WATER VALVE BOX ELEVATIONS			
STREET	STATION	OFFSET	PROPOSED ELEVATION
19TH STREET NORTH	70+41.25	29.0'LL	212.1
19TH STREET NORTH	71+67.44	28.0'LL	212.1
19TH STREET NORTH	71+87.44	28.0'LL	210.9

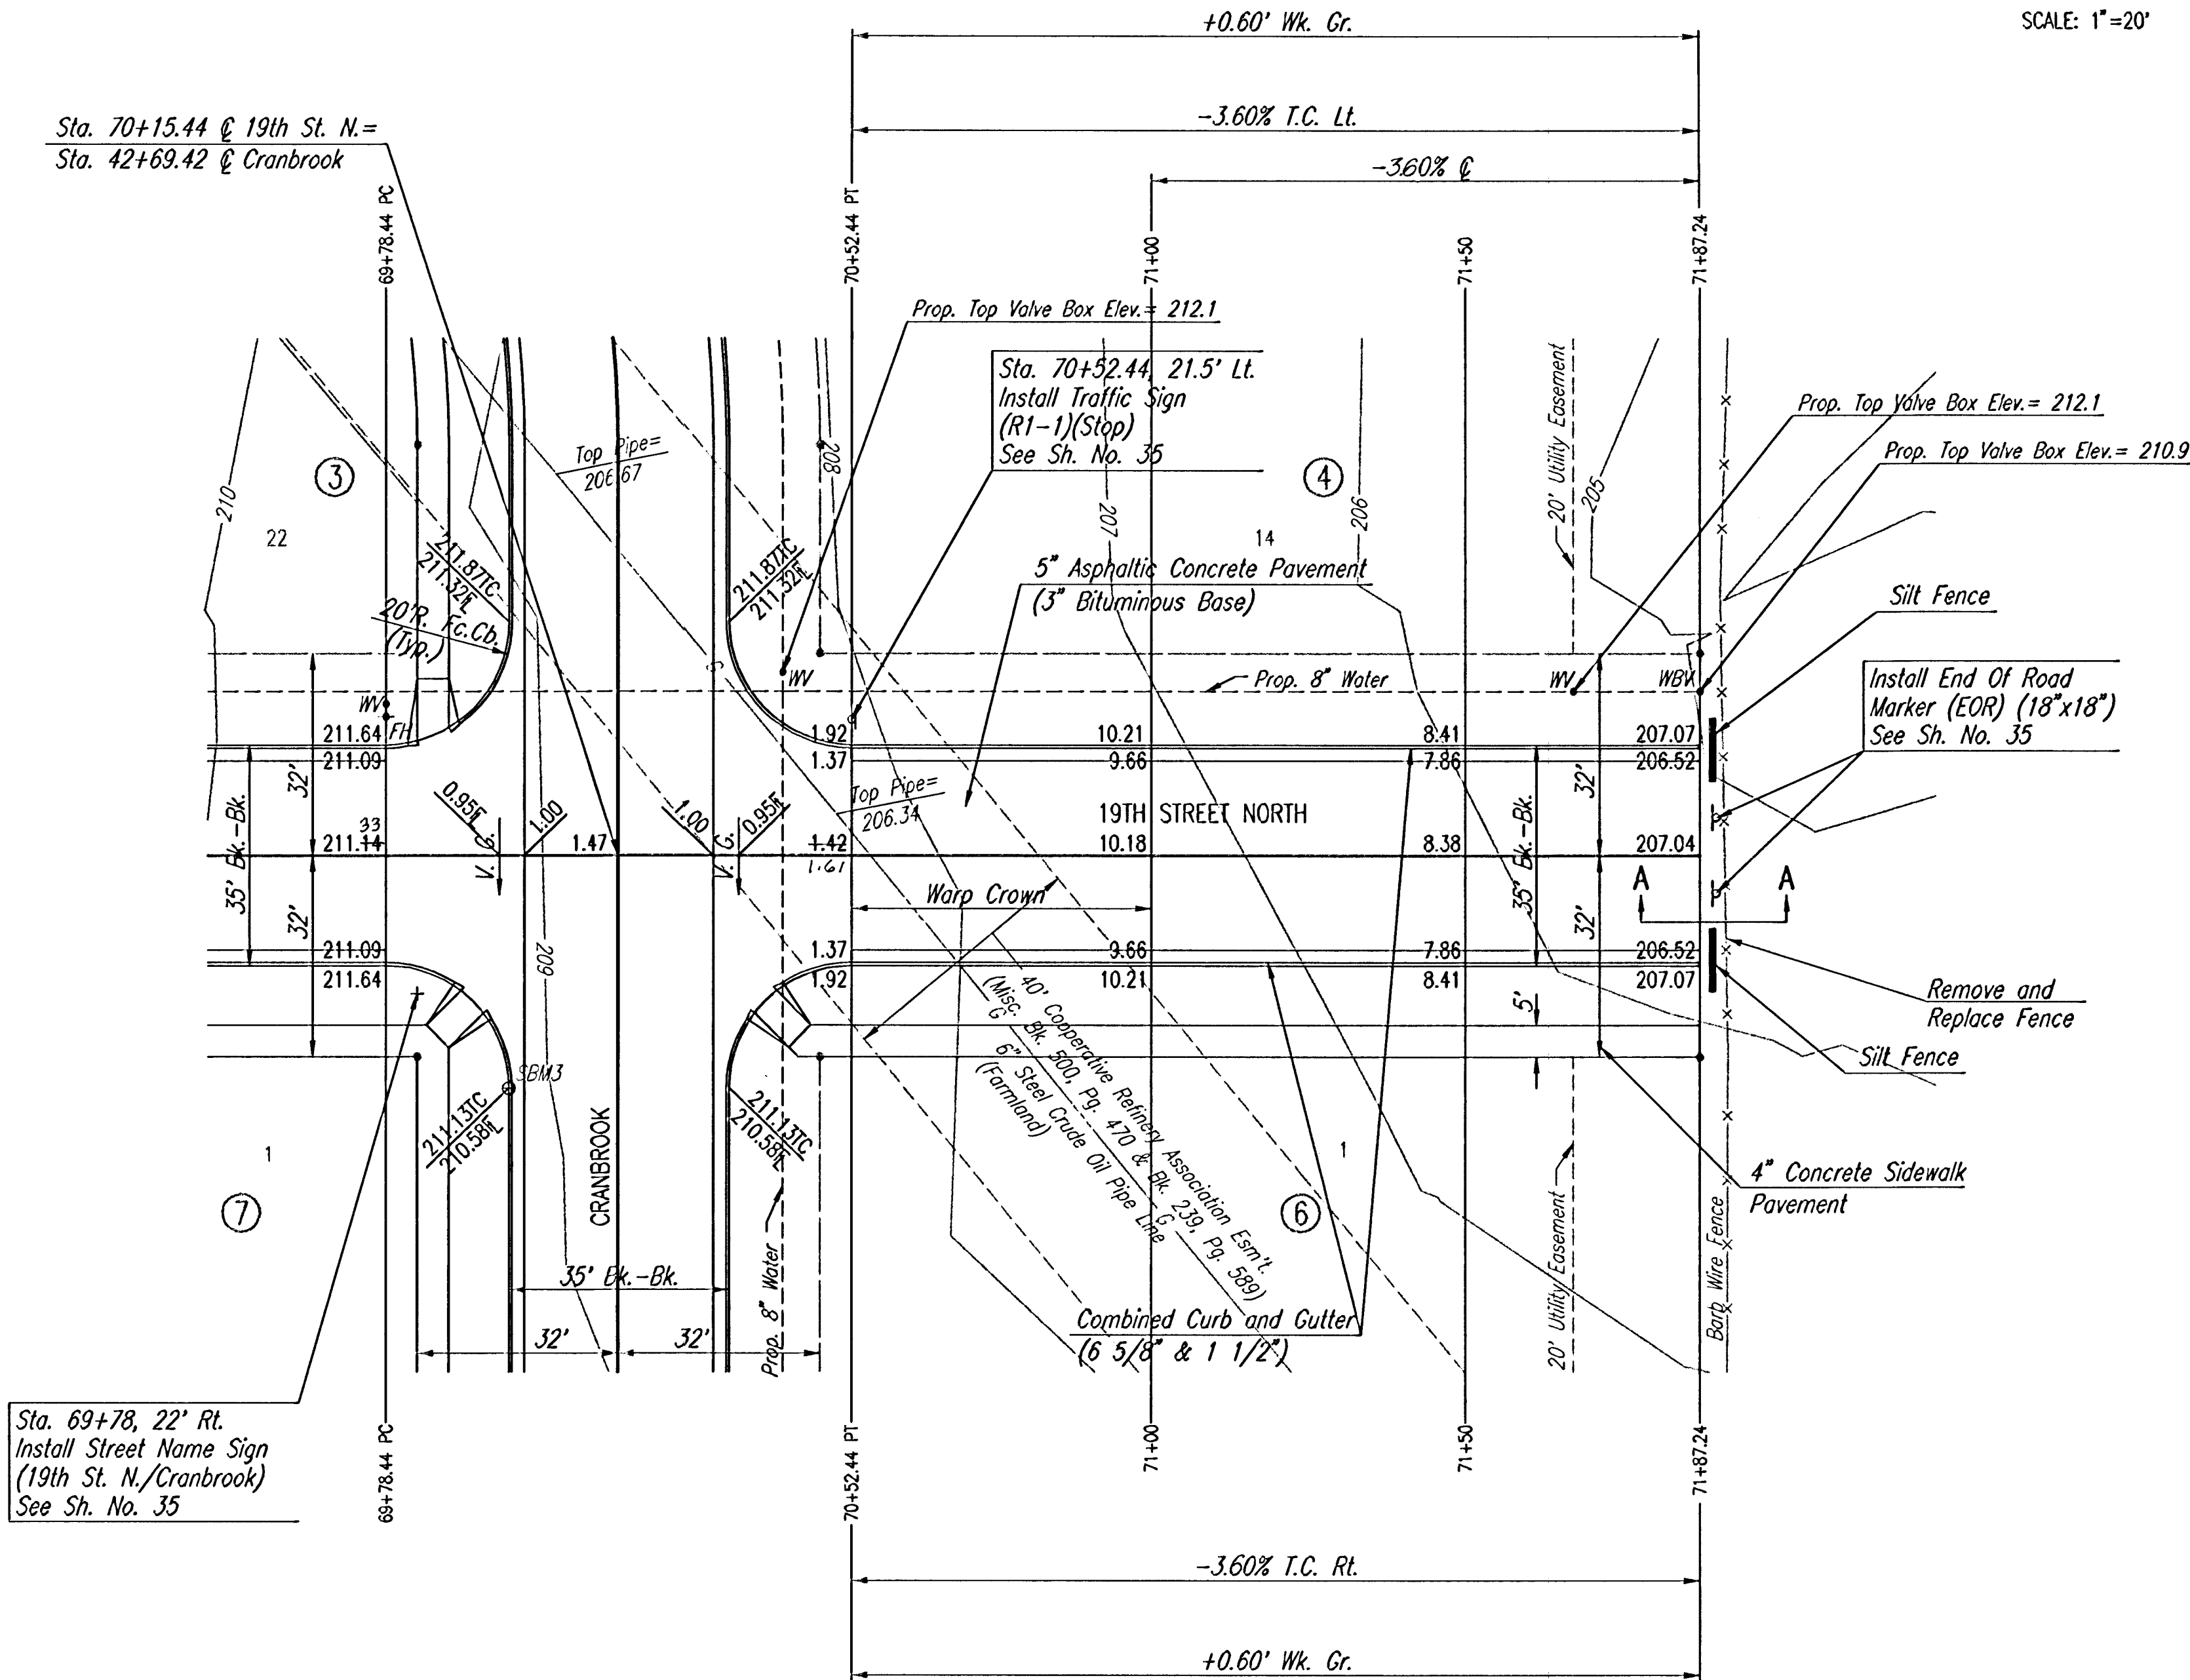

SCALE: 1"=20'

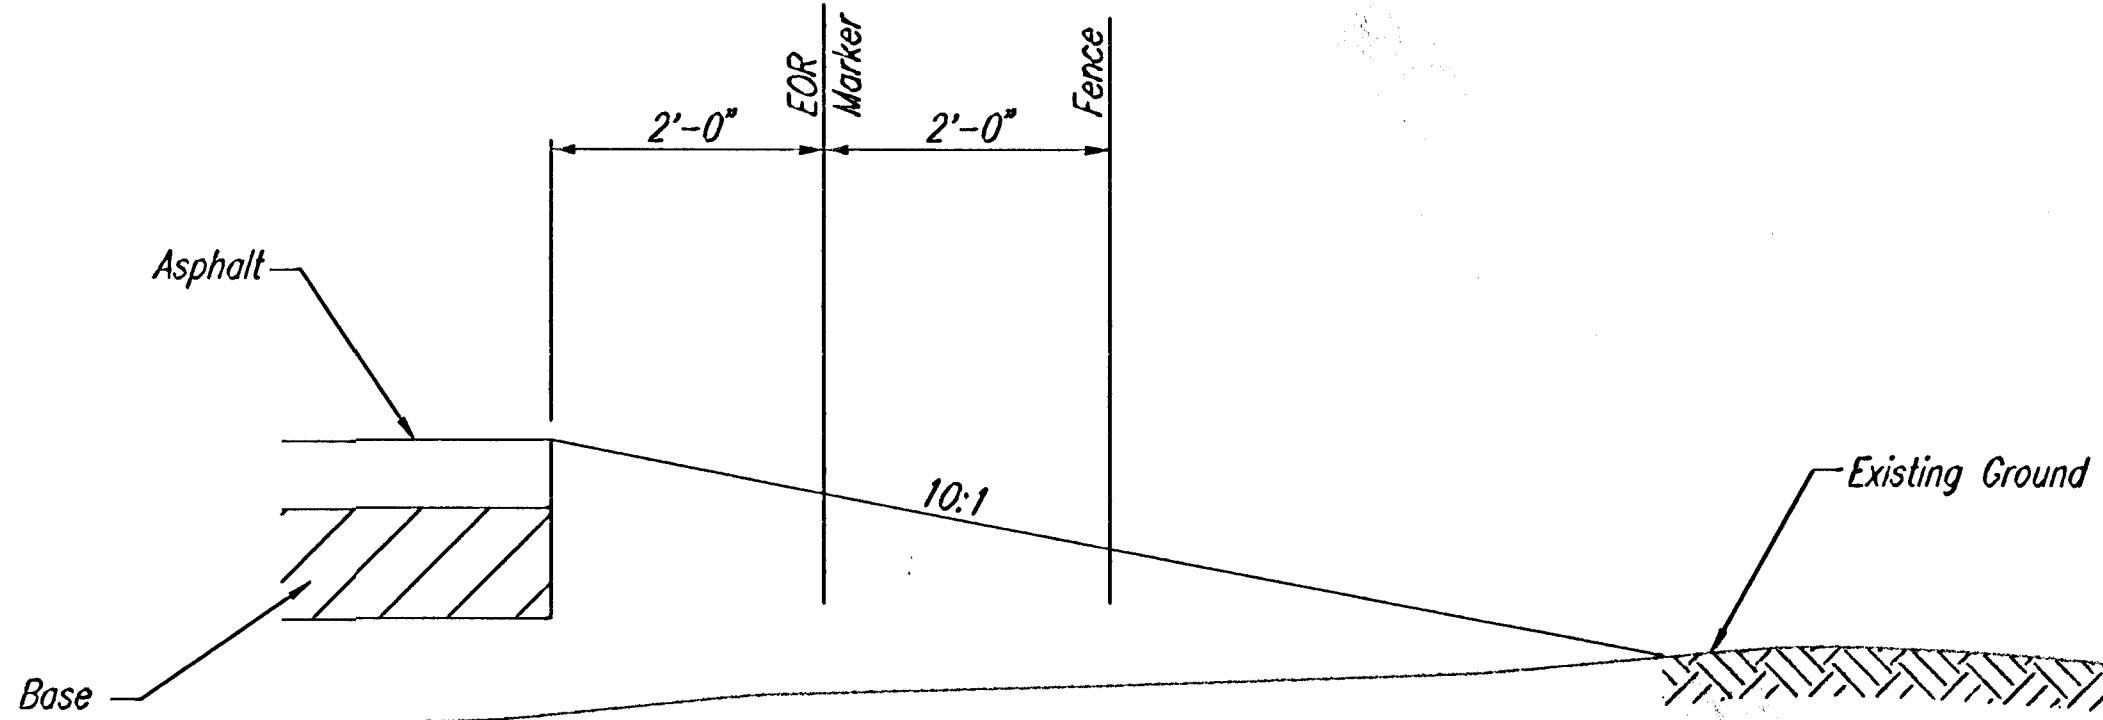

SECTION A-A

RECORD DRAWING

REMINGTON PLACE - PHASE 2

19TH STREET NORTH
STA. 69+78.44 TO STA. 71+87.24



Professional Engineering Consultants, P.A.
303 S. TOPEKA • WICHITA, KANSAS 67202
316-262-2691 • FAX 316-262-3003

Designed by	BER	Checked by	
Drawn by	DEP	Date	DEC., 2002

Job No. 02398