


WATER VALVE BOX ELEVATIONS			
STREET	STATION	OFFSET	PROPOSED ELEVATION
CHURCHILL	46+69.73	23.0' RL	216.2

PROJECT NO.	SHEET NO.	TOTAL SHEETS
472-83376	16	50

SCALE: 1"=20'

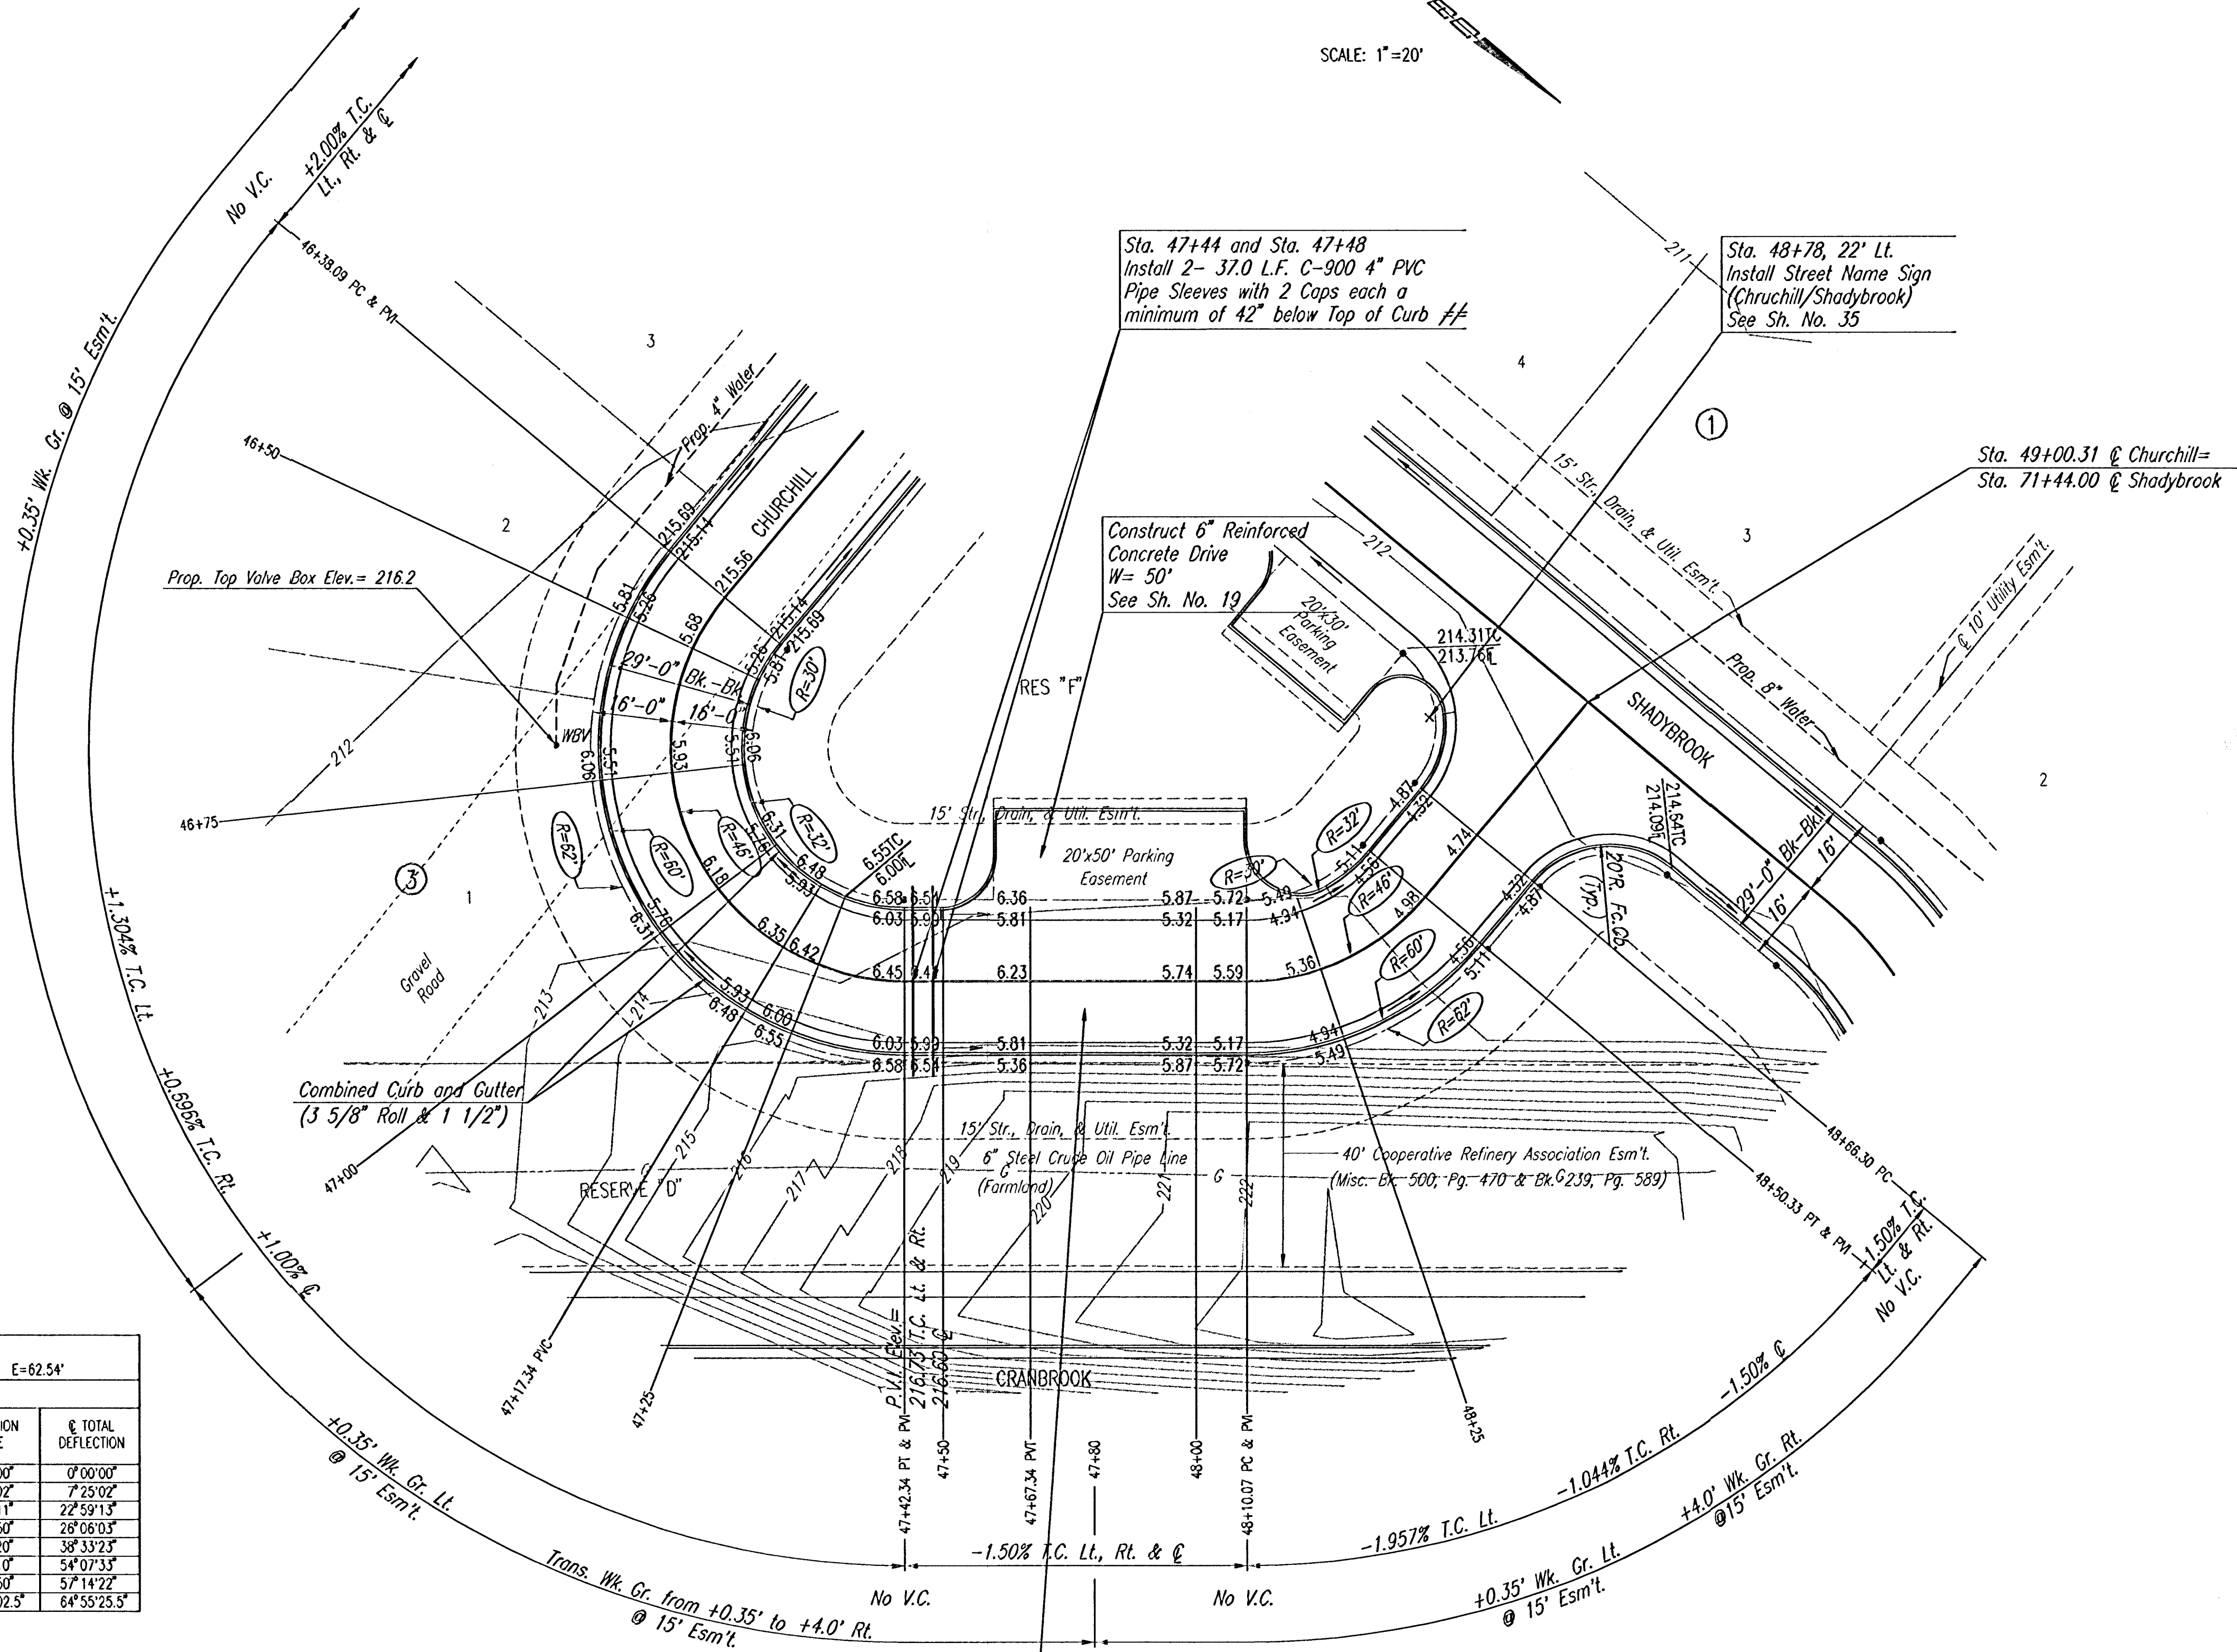

CURVE DATA						
Δ=129°50'51" D=124°33'22" R=46.00' L=104.25' T=98.31' E=62.54'						
CURVE DATA BASED ON RADIUS Δ/2=64°55'25.5"						
STATION	ARC LENGTH	FACE CURB LENGTH	CHORD LENGTH	DEFLECTION ANGLE	TOTAL DEFLECTION	
		LEFT CURB	RIGHT CURB	8' OFF LEFT FACE CURB	8' OFF RIGHT FACE CURB	
46+38.09						0°00'00"
46+50	11.91'	8.29'	15.53'	6.20'	17.56'	7°25'02"
46+75	25.00'	17.39'	32.61'	12.88'	36.50'	15°34'11"
46+80	5.00'	3.48'	6.52'	2.61'	7.39'	3°06'50"
47+00	20.00'	13.91'	26.09'	10.35'	29.33'	12°27'20"
47+25	25.00'	17.39'	32.61'	12.88'	36.50'	15°34'10"
47+30	5.00'	3.48'	6.52'	2.61'	7.39'	3°06'50"
47+42.34	12.34'	8.58'	16.09'	6.42'	18.18'	7°41'02.5"
TOTAL	104.25'	72.52'	135.97'	Defl./ft.=37.366187 min.		64°55'25.5"

CURVE DATA						
Δ=50°09'09" D=124°33'22" R=46.00' L=40.27' T=21.52' E= 4.79'						
CURVE DATA BASED ON RADIUS Δ/2=25°04'34.5"						
STATION	ARC LENGTH	FACE CURB LENGTH	CHORD LENGTH	DEFLECTION ANGLE	TOTAL DEFLECTION	
		LEFT CURB	RIGHT CURB	8' OFF LEFT FACE CURB	8' OFF RIGHT FACE CURB	
48+10.07						0°00'00"
48+25	14.93'	10.39'	19.47'	7.78'	21.97'	9°17'53"
48+50.34	25.34'	17.62'	33.05'	12.88'	36.99'	15°46'41.5"
TOTAL	40.27'	28.01'	52.52'	Defl./ft.=37.362180 min.		25°04'34.5"

NOTE: THIS STREET TO BE CONSTRUCTED WITH ROLL-TYPE CURB. TOP OF CURB ELEVATIONS GIVEN ARE FOR FULL HEIGHT CURB.

EACH END OF 4" PVC PIPE SLEEVE SHALL BE MARKED WITH STEEL "I" POSTS OR 2" STEEL PIPE A MAXIMUM OF 12" ABOVE GRADE. PIPE, CAPS, PIPE INSTALLATION AND MARKERS SHALL BE SUBSIDIARY TO "COMBINED CURB AND GUTTER (6 5/8" & 1 1/2)".

RECORD DRAWING

24 NOV 03

REMINGTON PLACE - PHASE 2

CHURCHILL
STA. 46+38.09 TO STA. 49+00.31



Professional Engineering Consultants, P.A.
303 S. TOPEKA • WICHITA, KANSAS 67202
316-262-2691 • FAX 316-262-3003

Designed by	BER	Checked by	
Drawn by	DEP	Date	DEC., 2002
		Job No.	02398

DSNR: DEP OPER: DEP SCALE: 1"=20.00
C:\2002\02398\000\CHURCHILL2 12-03-2002 03:13:02 pm