
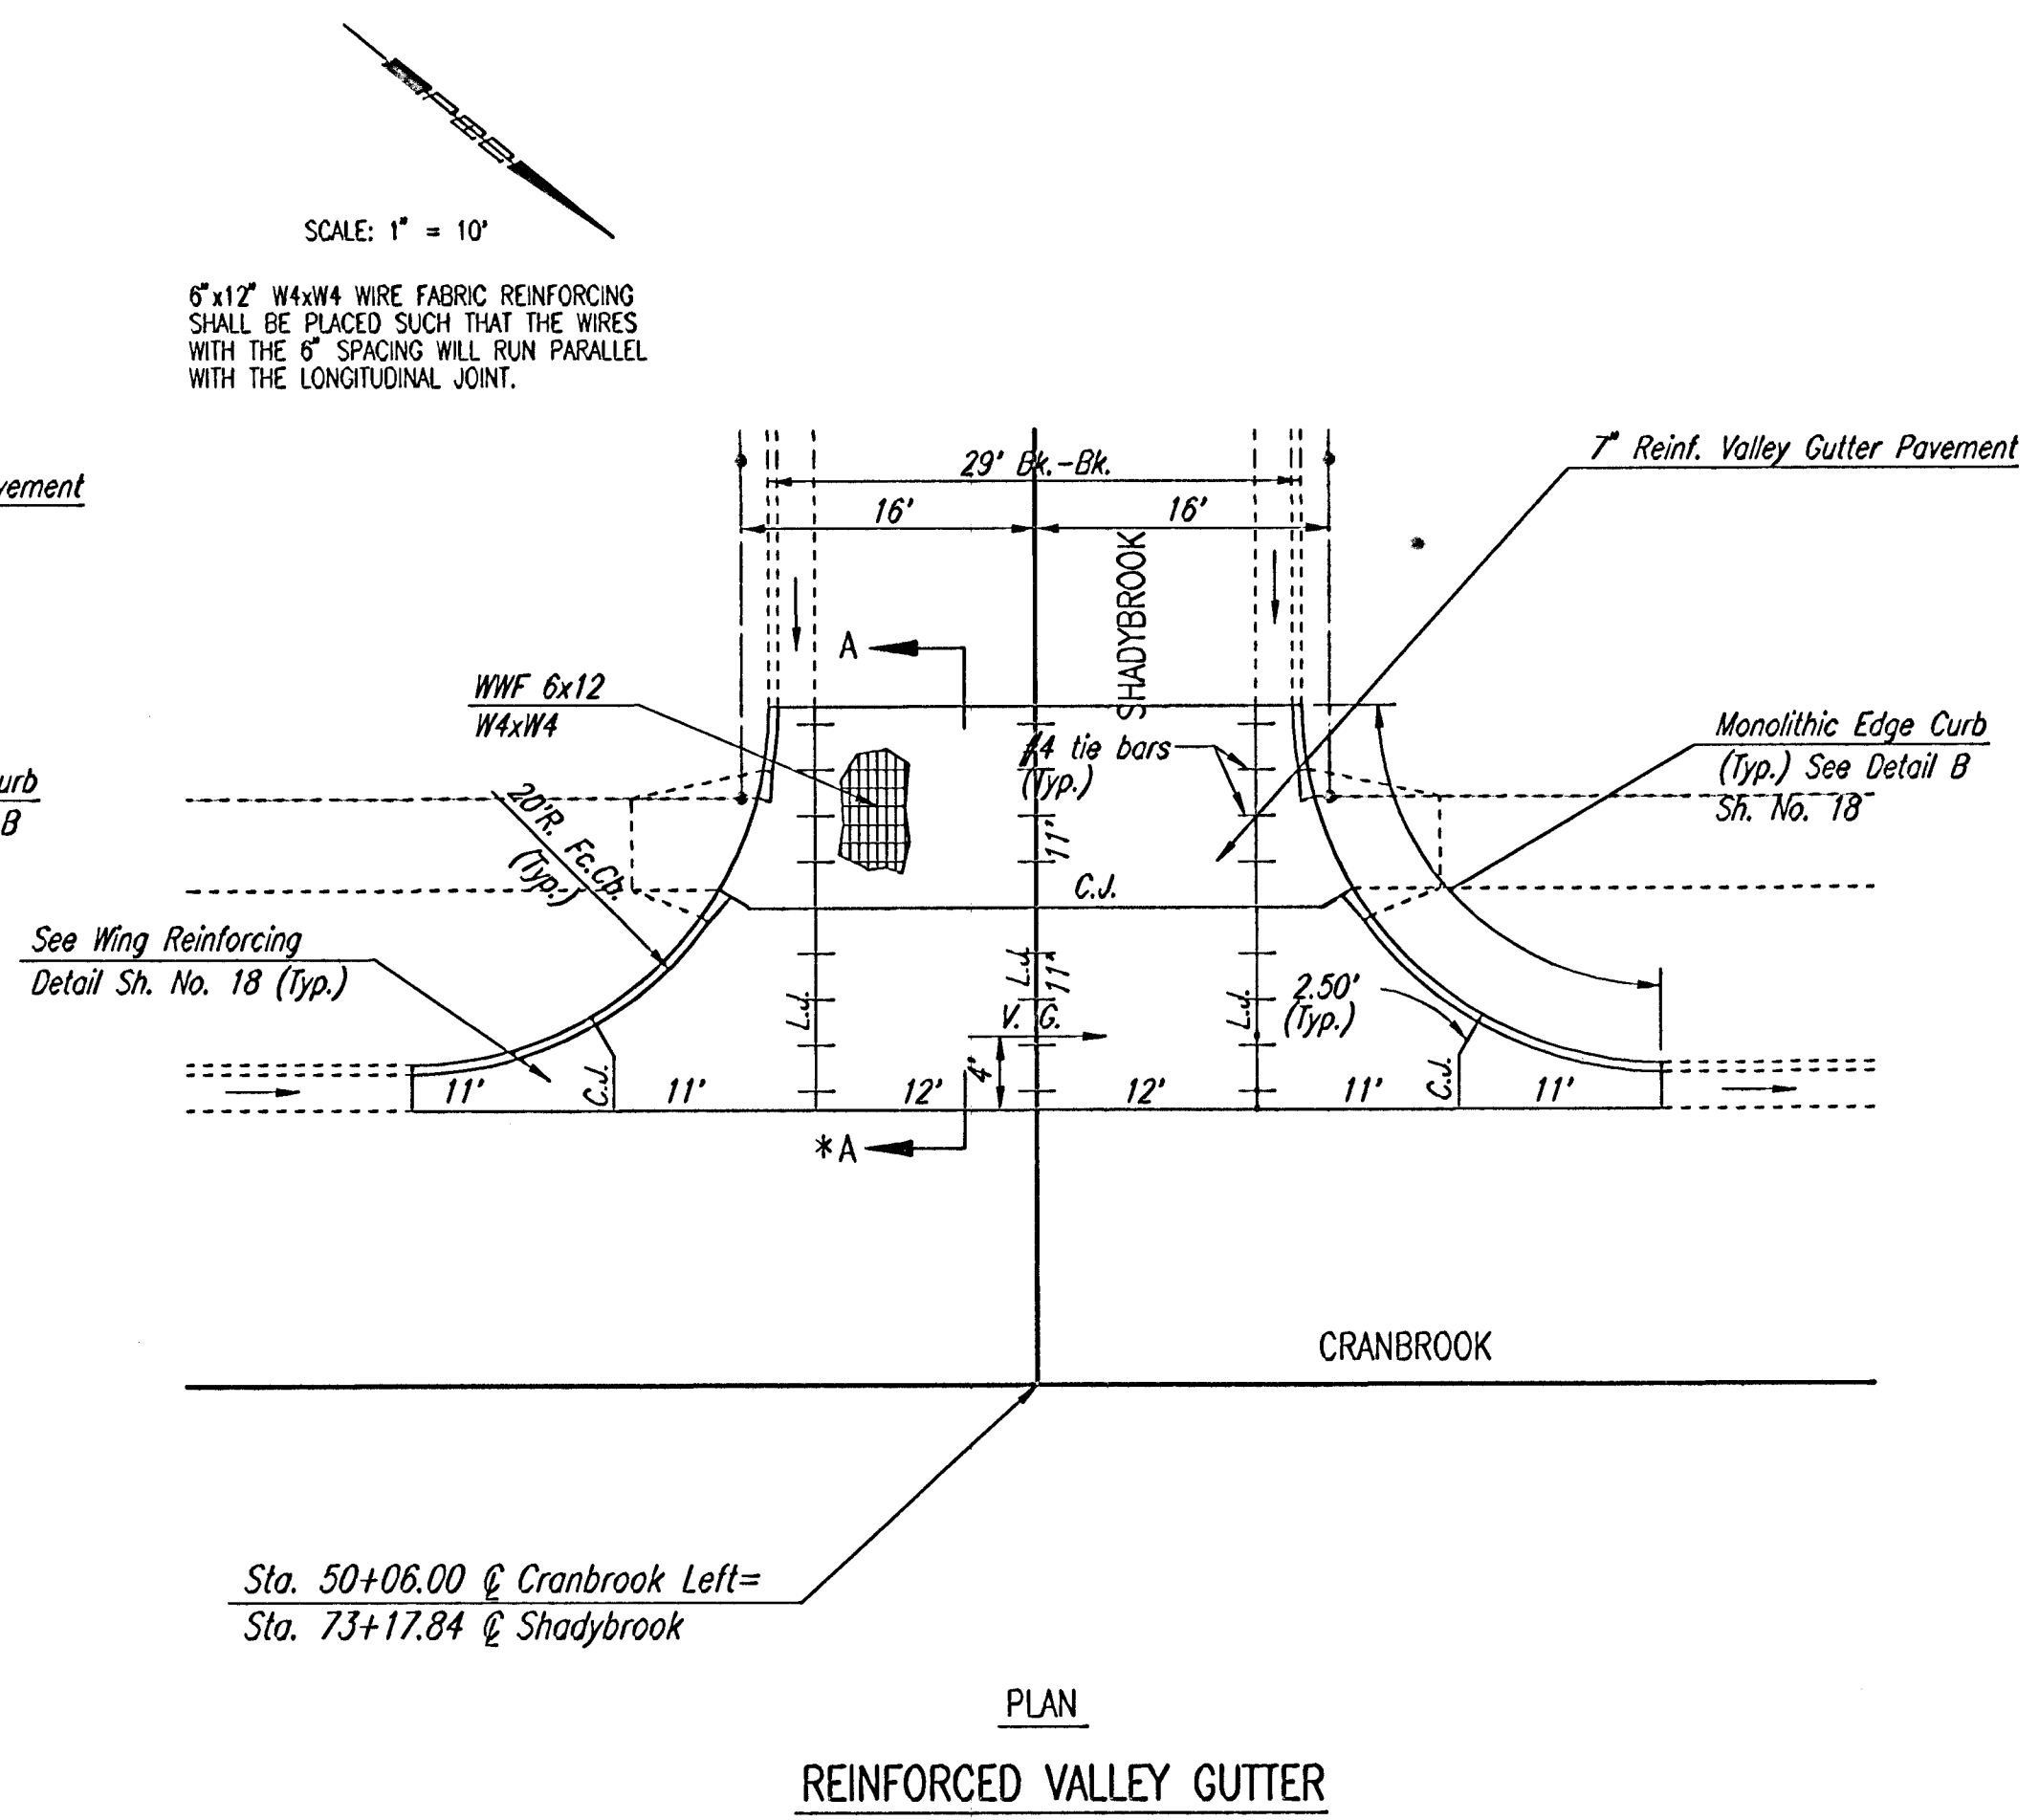
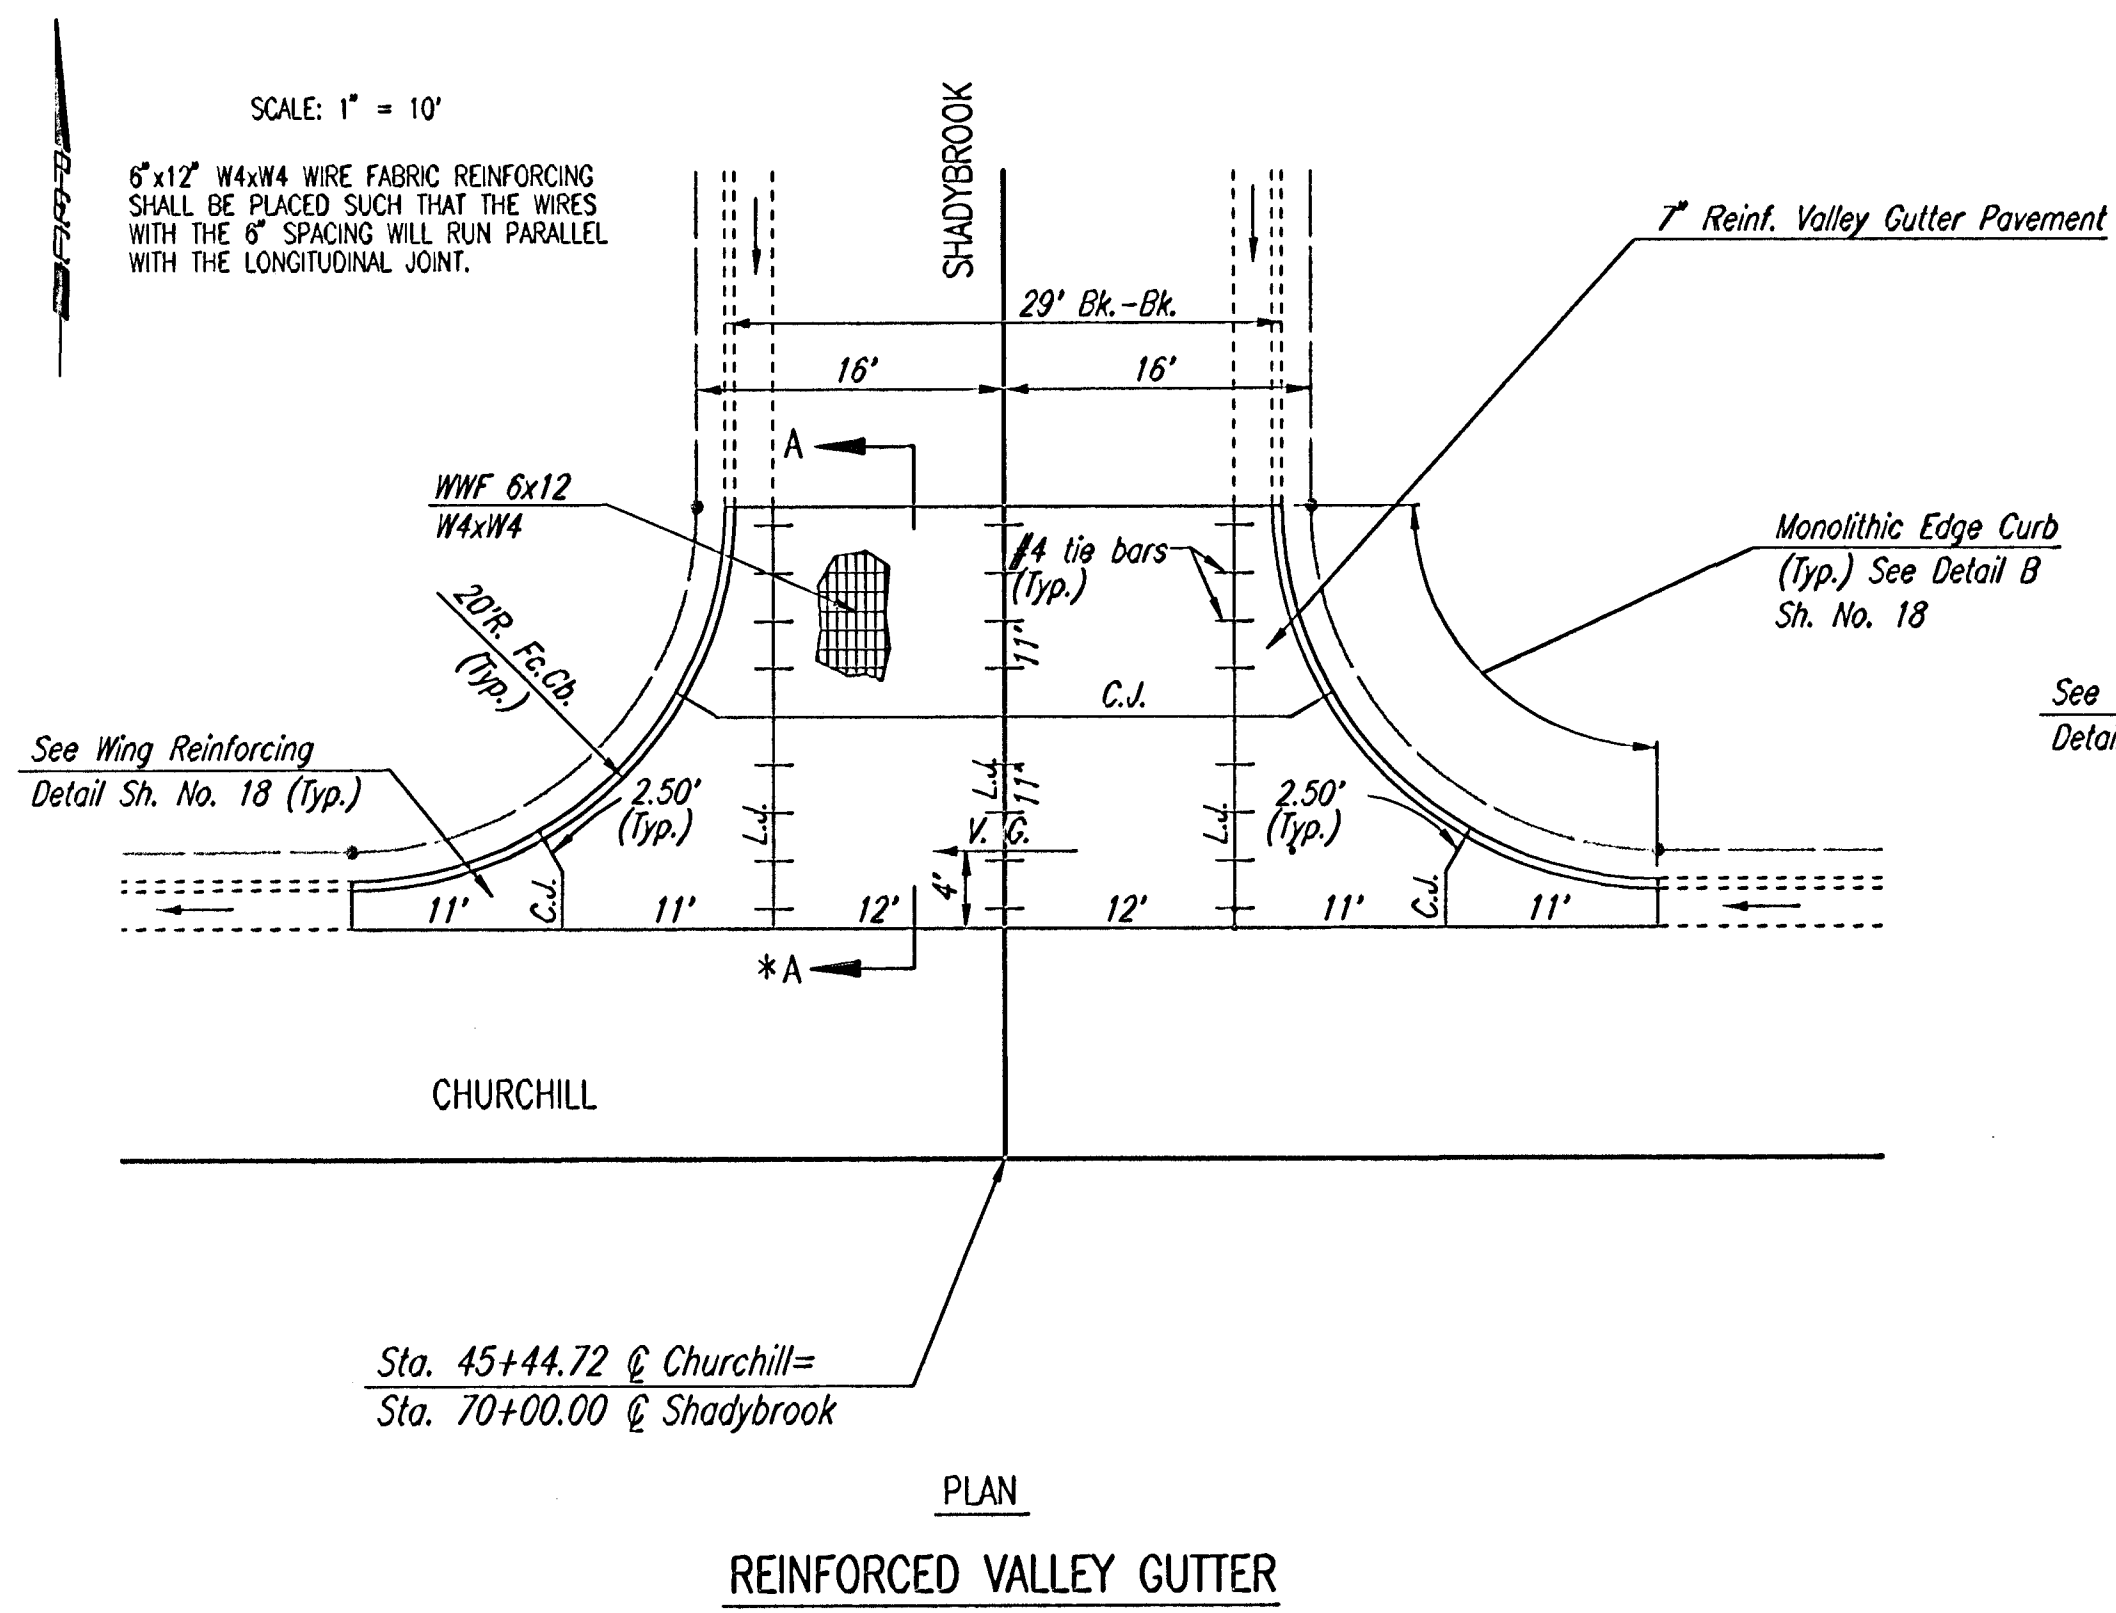
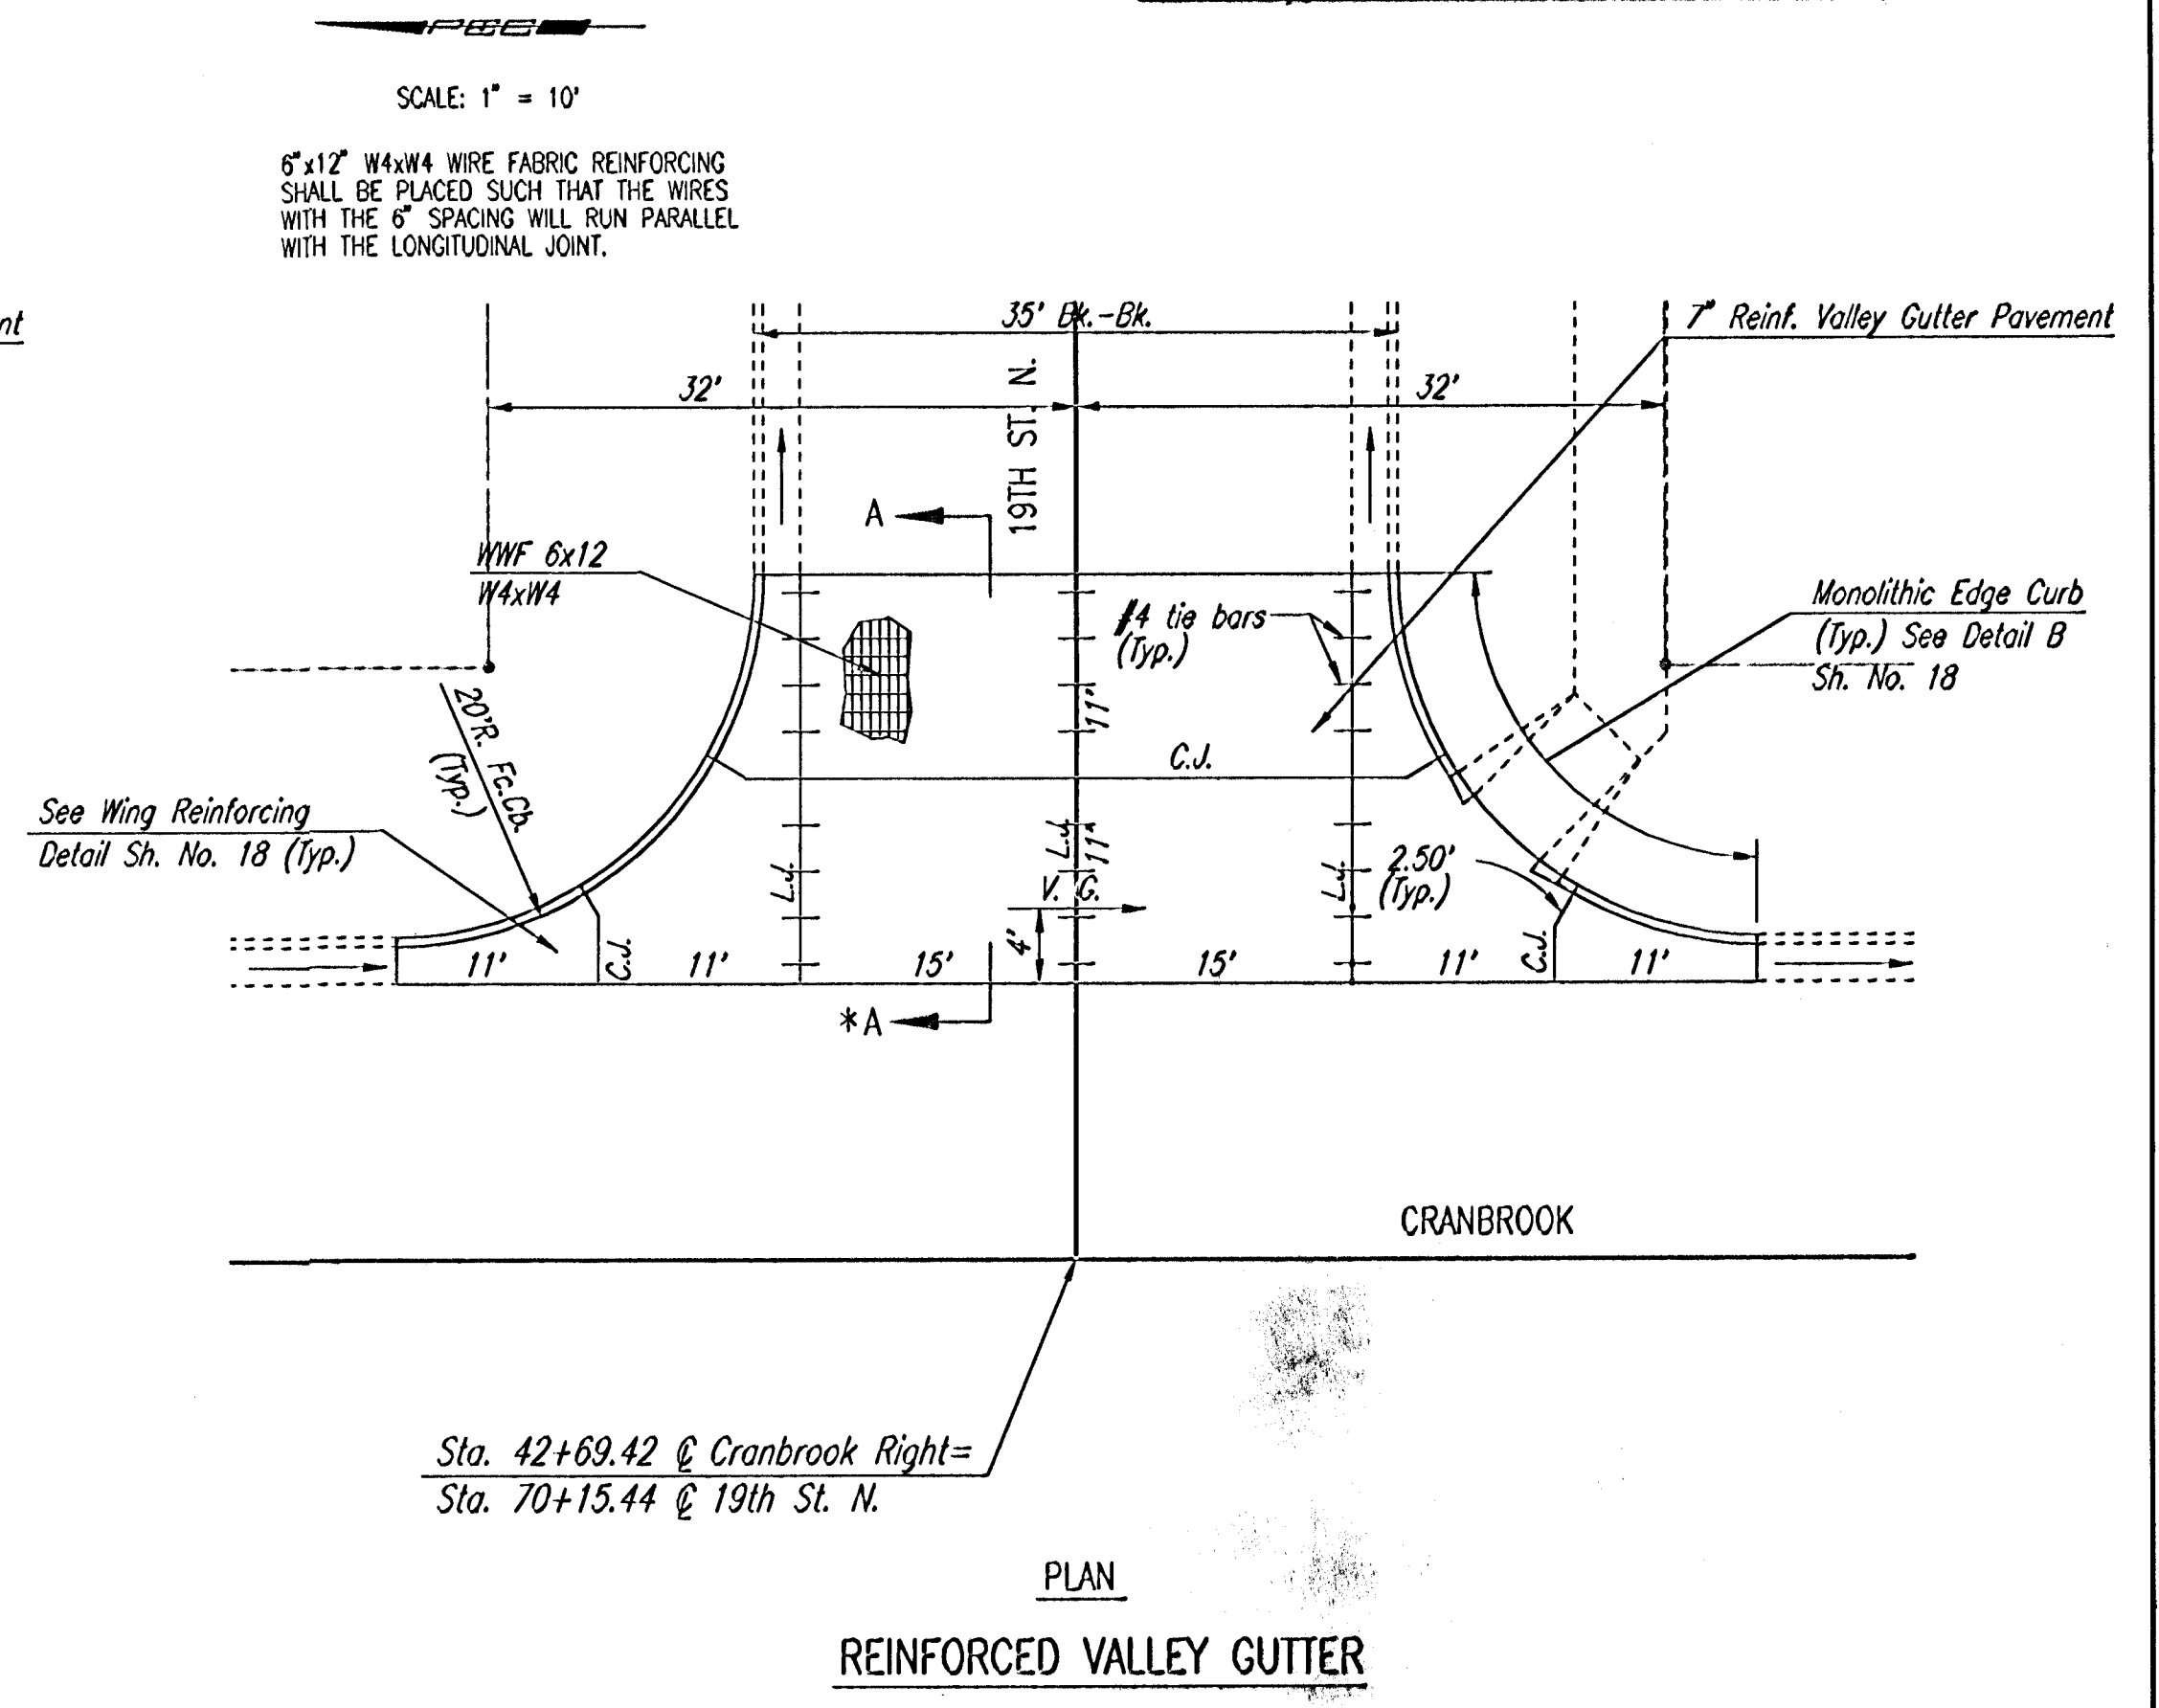
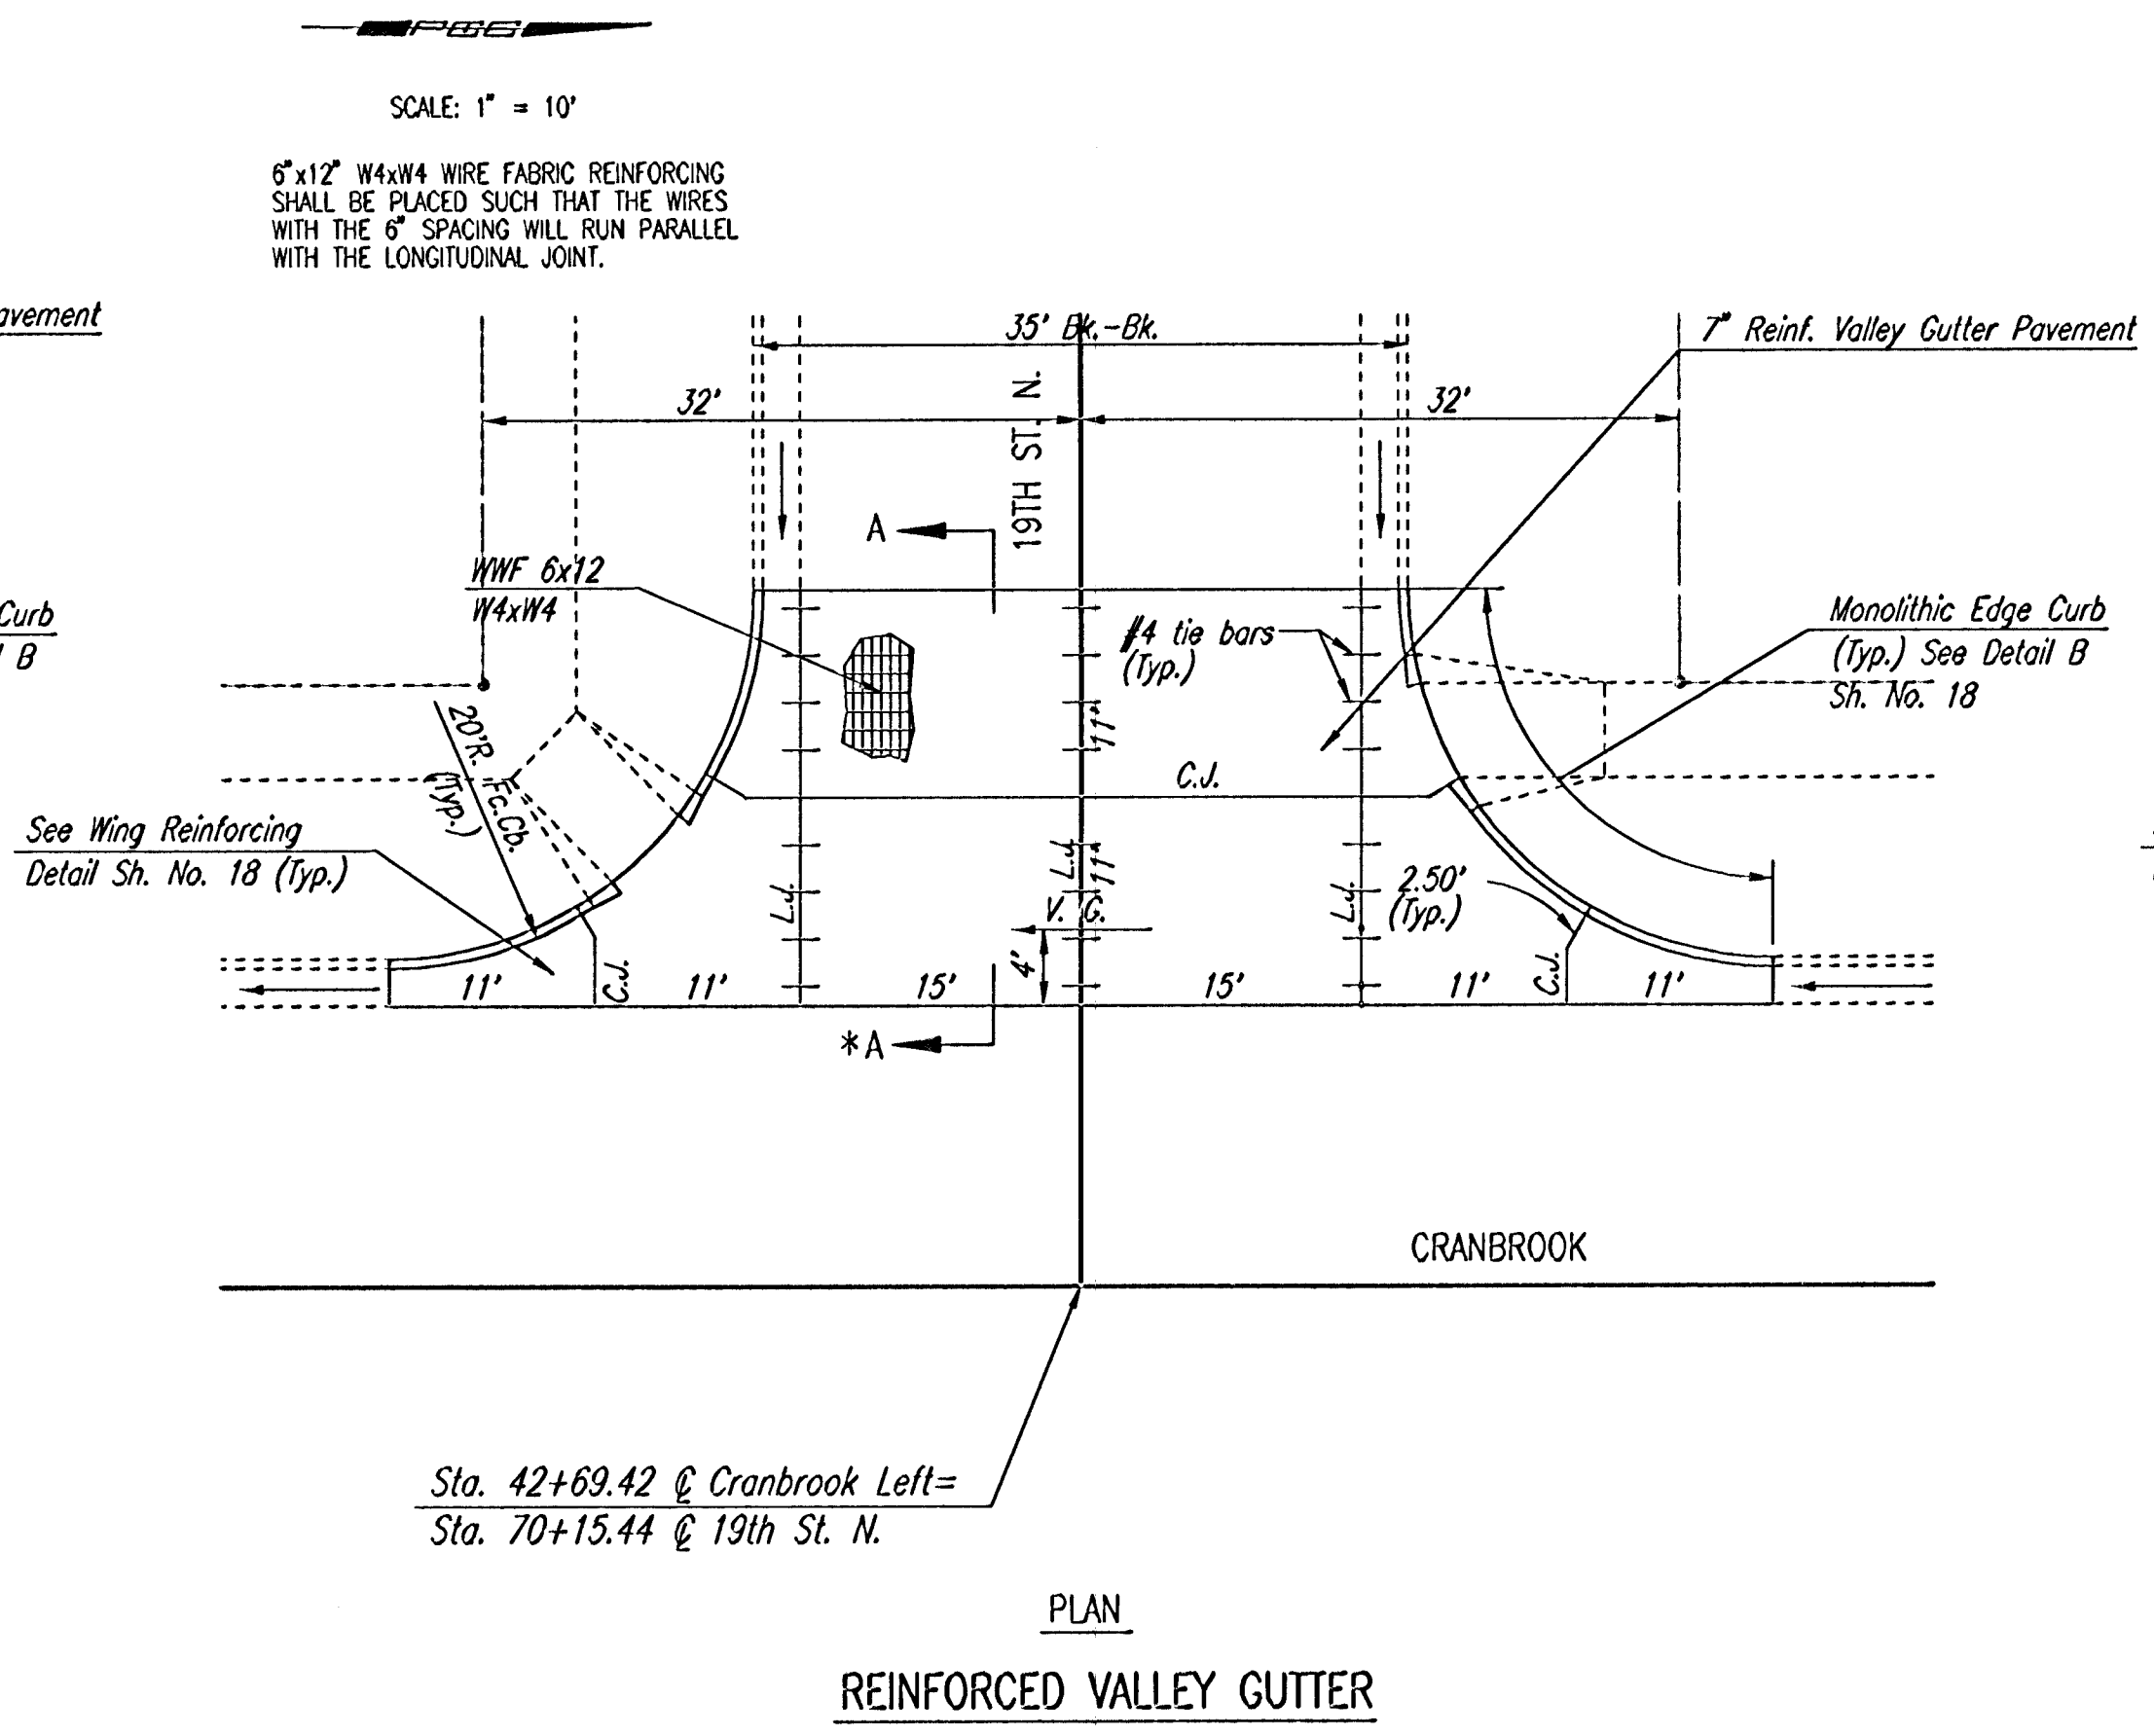


PROJECT NO.	SHEET NO.	TOTAL SHEETS
472-83376	18	50

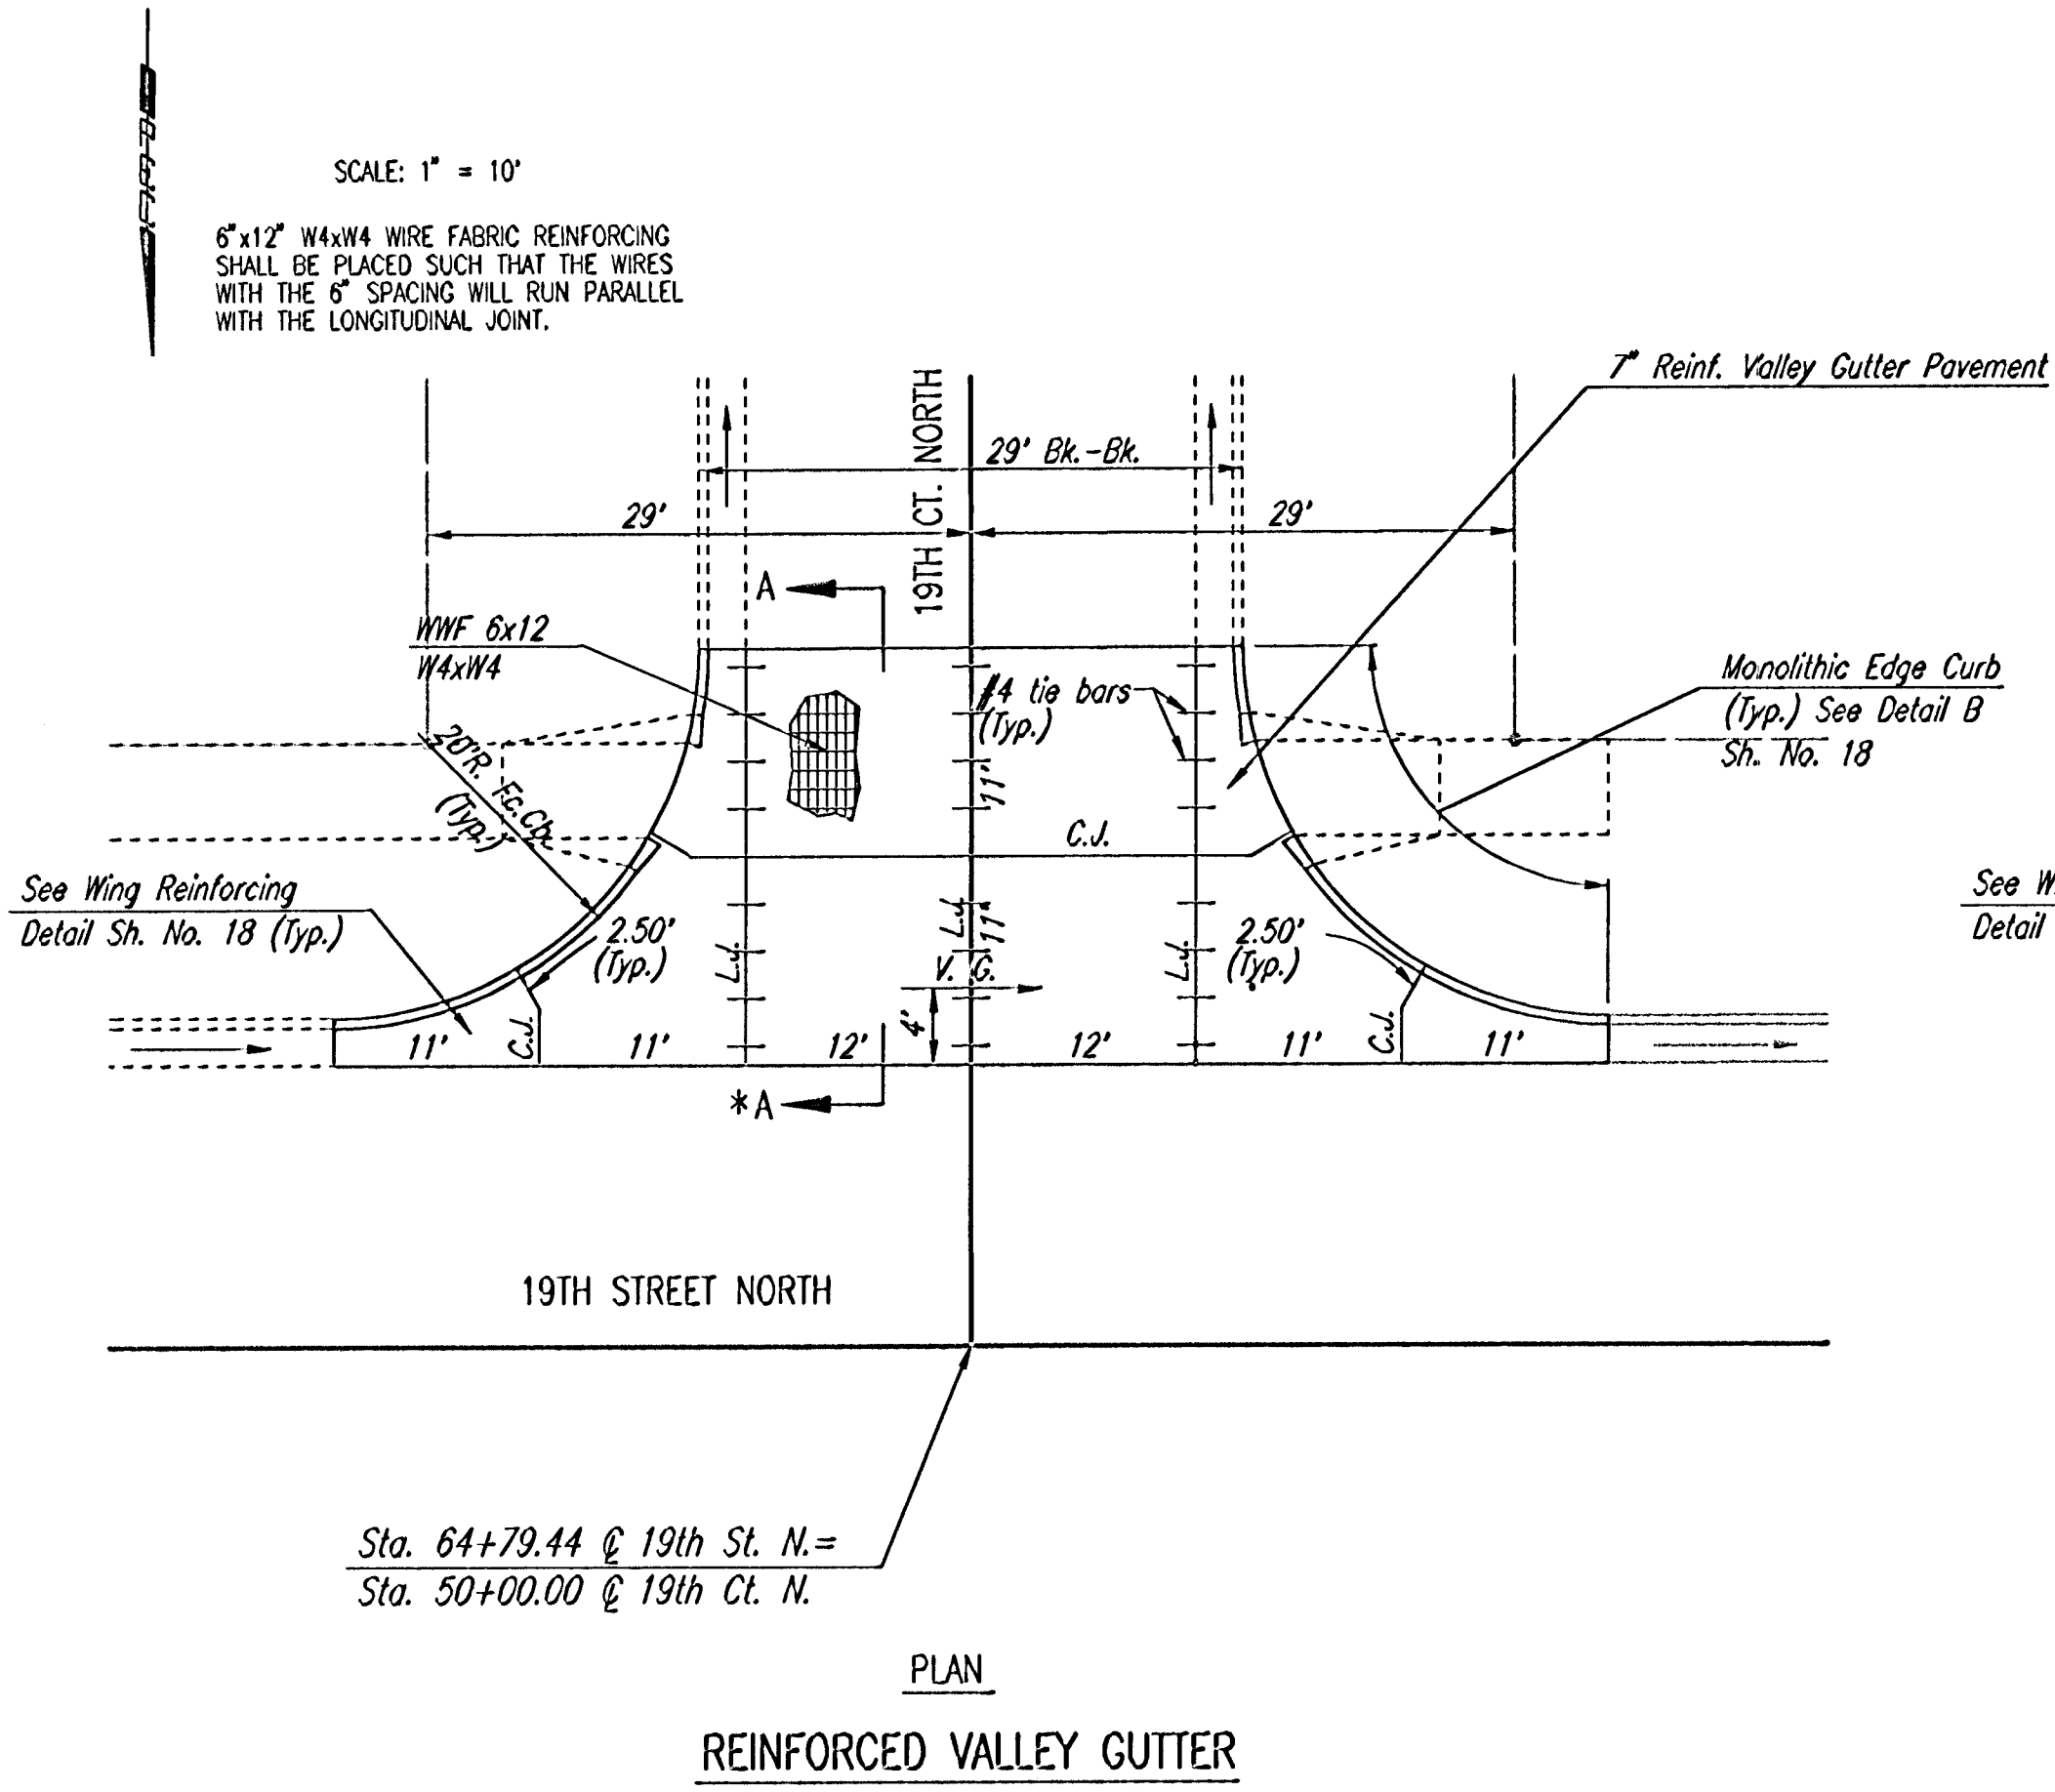

RECORD DRAWING
24 NOV 03
REMINGTON PLACE - PHASE 2

VALLEY GUTTER PLANS

Professional Engineering Consultants, P.A. 303 S. TOPEKA • WICHITA, KANSAS 67202 316-262-2691 • FAX 316-262-3003			
Designed by	BER	Checked by	
Drawn by	DEP	Date	DEC., 2002
		Job No.	02398

* SEE SH. NO. 18 FOR SECTION A-A

DSNR: RRY OPER: DEP SCALE: 1"=10.00
01/2002 02:39:01 C:\00\VALGUT\PLAN2 12-03-2002 03:11:25 pm