


DSNR: SLD OPER: DEP SCALE: 1"=20.00
C: 2002 023581 0001 SWS LINE 2 12-03-2002 03:09:10 pm

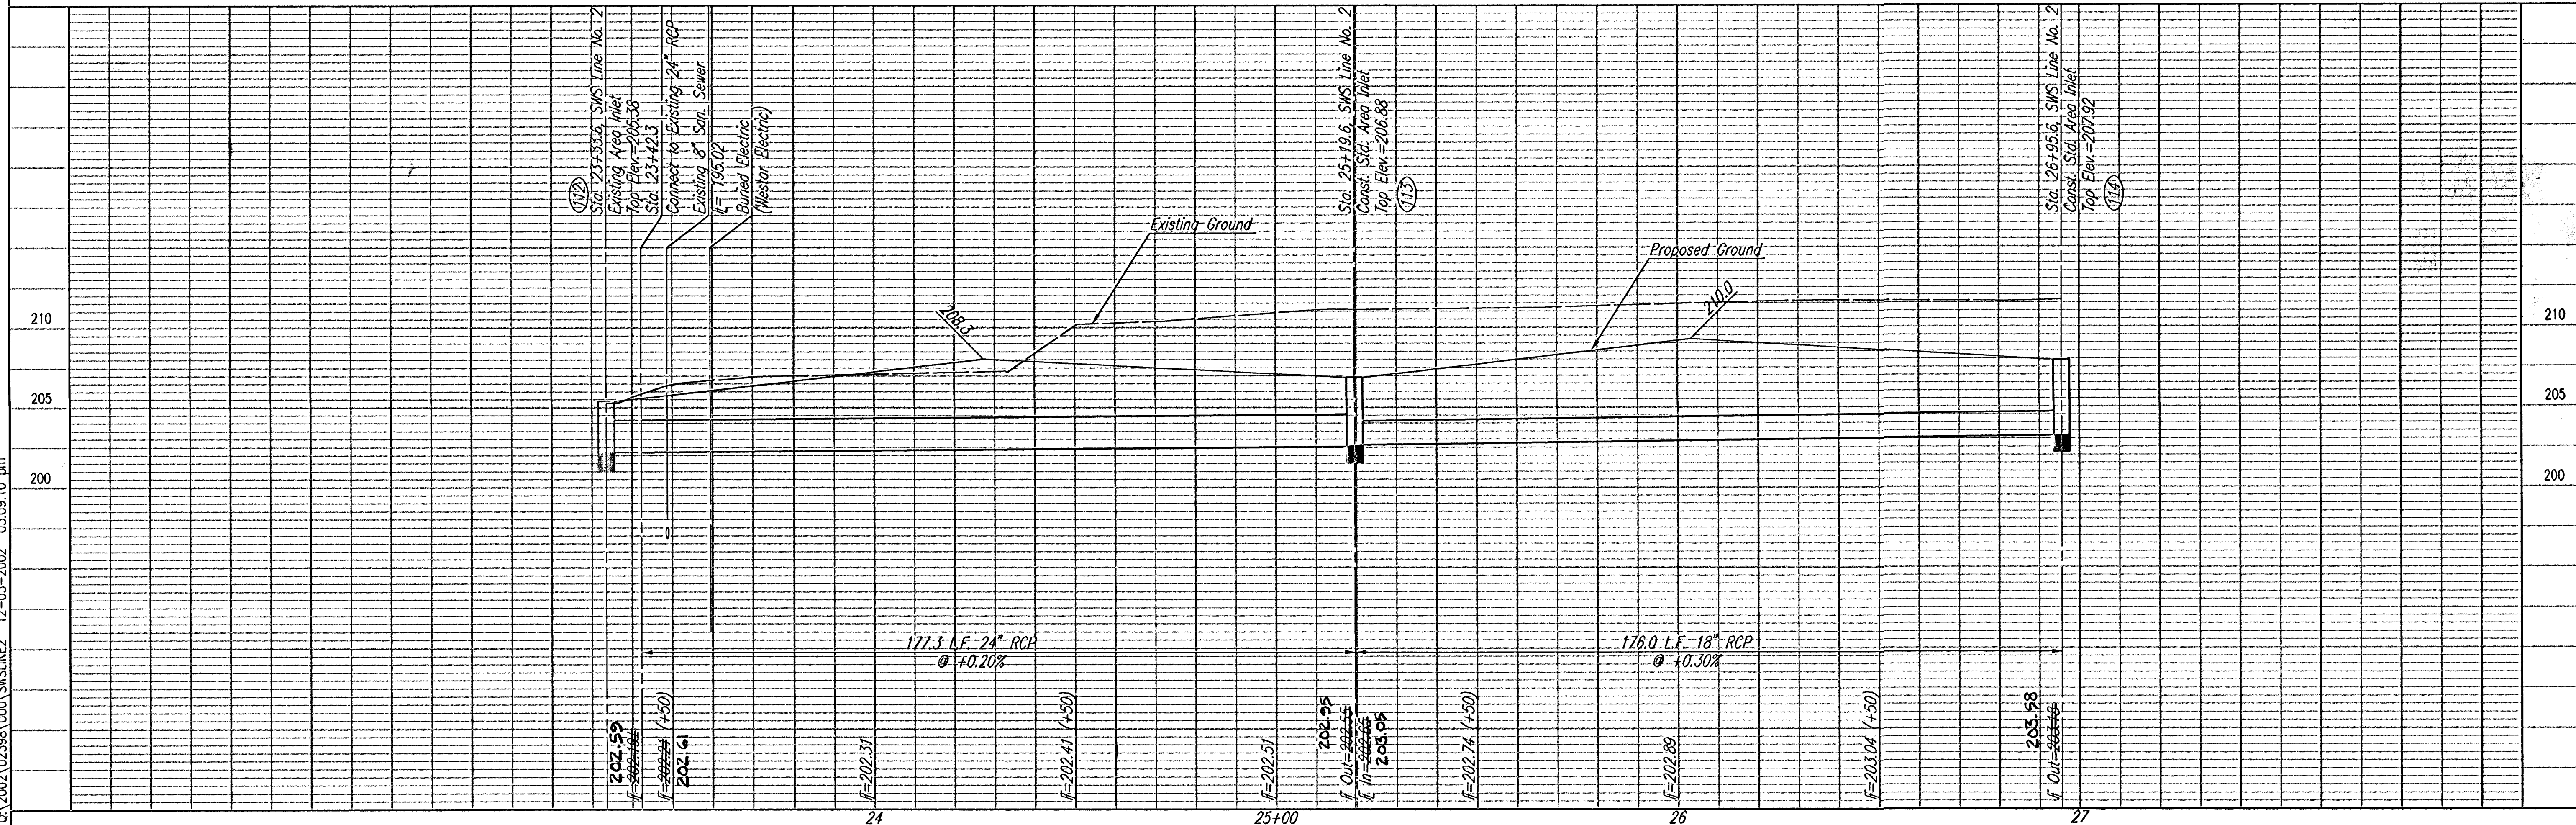

Sta. 23+33.6, SWS Line No. 2
Std. Area Inlet
Top Elev. = 205.38

Sta. 23+42.3, SWS Line No. 2
Contractor to remove plug
and connect new 24" RCP to
existing 24" RCP
Install 177.3 L.F. 24" RCP (E)

CAUTION!!!
Buried Electric (Westar Energy)
Buried 8" Sanitary Sewer
(City of Wichita)

Sta. 25+19.6, SWS Line No. 2
Const. Std. Area Inlet
L=3'-0", W=3'-0"
Top Elev. 206.88
Install 176.0 L.F. 18" RCP (E)
See Sh. Nos. 28, 31 & 32

Sta. 26+95.6, SWS Line No. 2
Const. Std. Area Inlet
L=3'-0", W=3'-0"
Top Elev. 207.92
See Sh. Nos. 28, 31 & 32

RECORD DRAWING

114 = COORDINATE POINT NO.

COORDINATE LIST		
POINT	NORTH	EAST
112	385,894.9075	2,370,657.3608
113	385,897.4814	2,370,843.3604
114	385,899.4151	2,371,019.3498