


Sta. 13+53.0, SWS Line No. 4=
Sta. 20+00.0, SWS Line No. 5
Type C Area Inlet
Top Elev. = 204.58

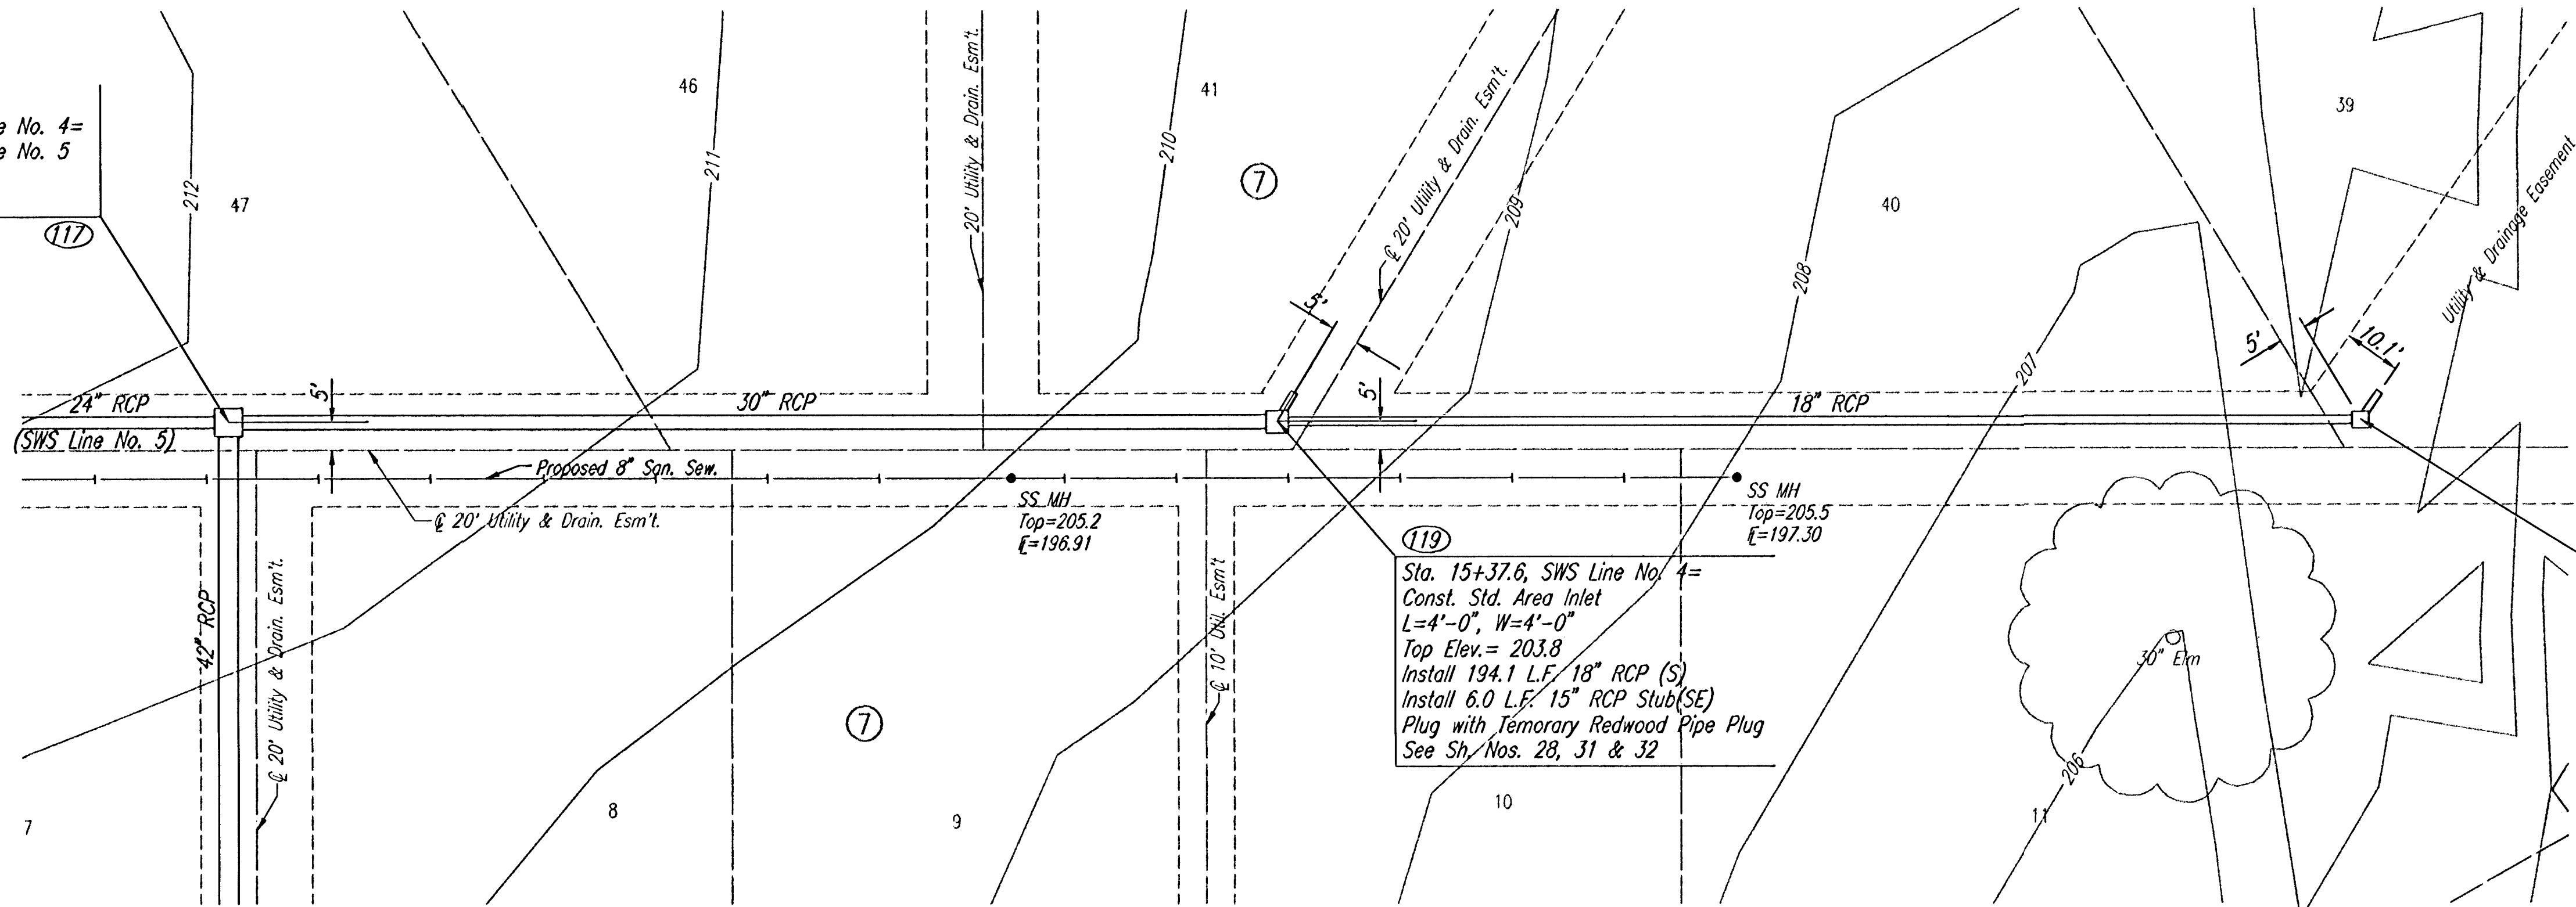

SCALE: 1"=20'


COORDINATE LIST		
POINT	NORTH	EAST
117	385,434.1721	2,370,909.8188
119	385,246.5164	2,370,911.8809
121	385,052.3687	2,370,914.0143

(121) = COORDINATE POINT NO.

Sta. 15+37.6, SWS Line No. 4=
Const. Std. Area Inlet
L=4'-0", W=4'-0"
Top Elev. = 203.8
Install 194.1 L.F. 18" RCP (S)
Install 6.0 L.F. 15" RCP Stub(SE)
Plug with Temporary Redwood Pipe Plug
See Sh. Nos. 28, 31 & 32

Sta. 17+31.7, SWS Line No. 4=
Const. Std. Area Inlet
L=3'-0", W=3'-0"
Top Elev. = 204.9
Install 6.0 L.F. 15" RCP Stub(SE)
Plug with Temporary Redwood Pipe Plug
See Sh. Nos. 28, 31 & 32

RECORD DRAWING
24-Nov-03

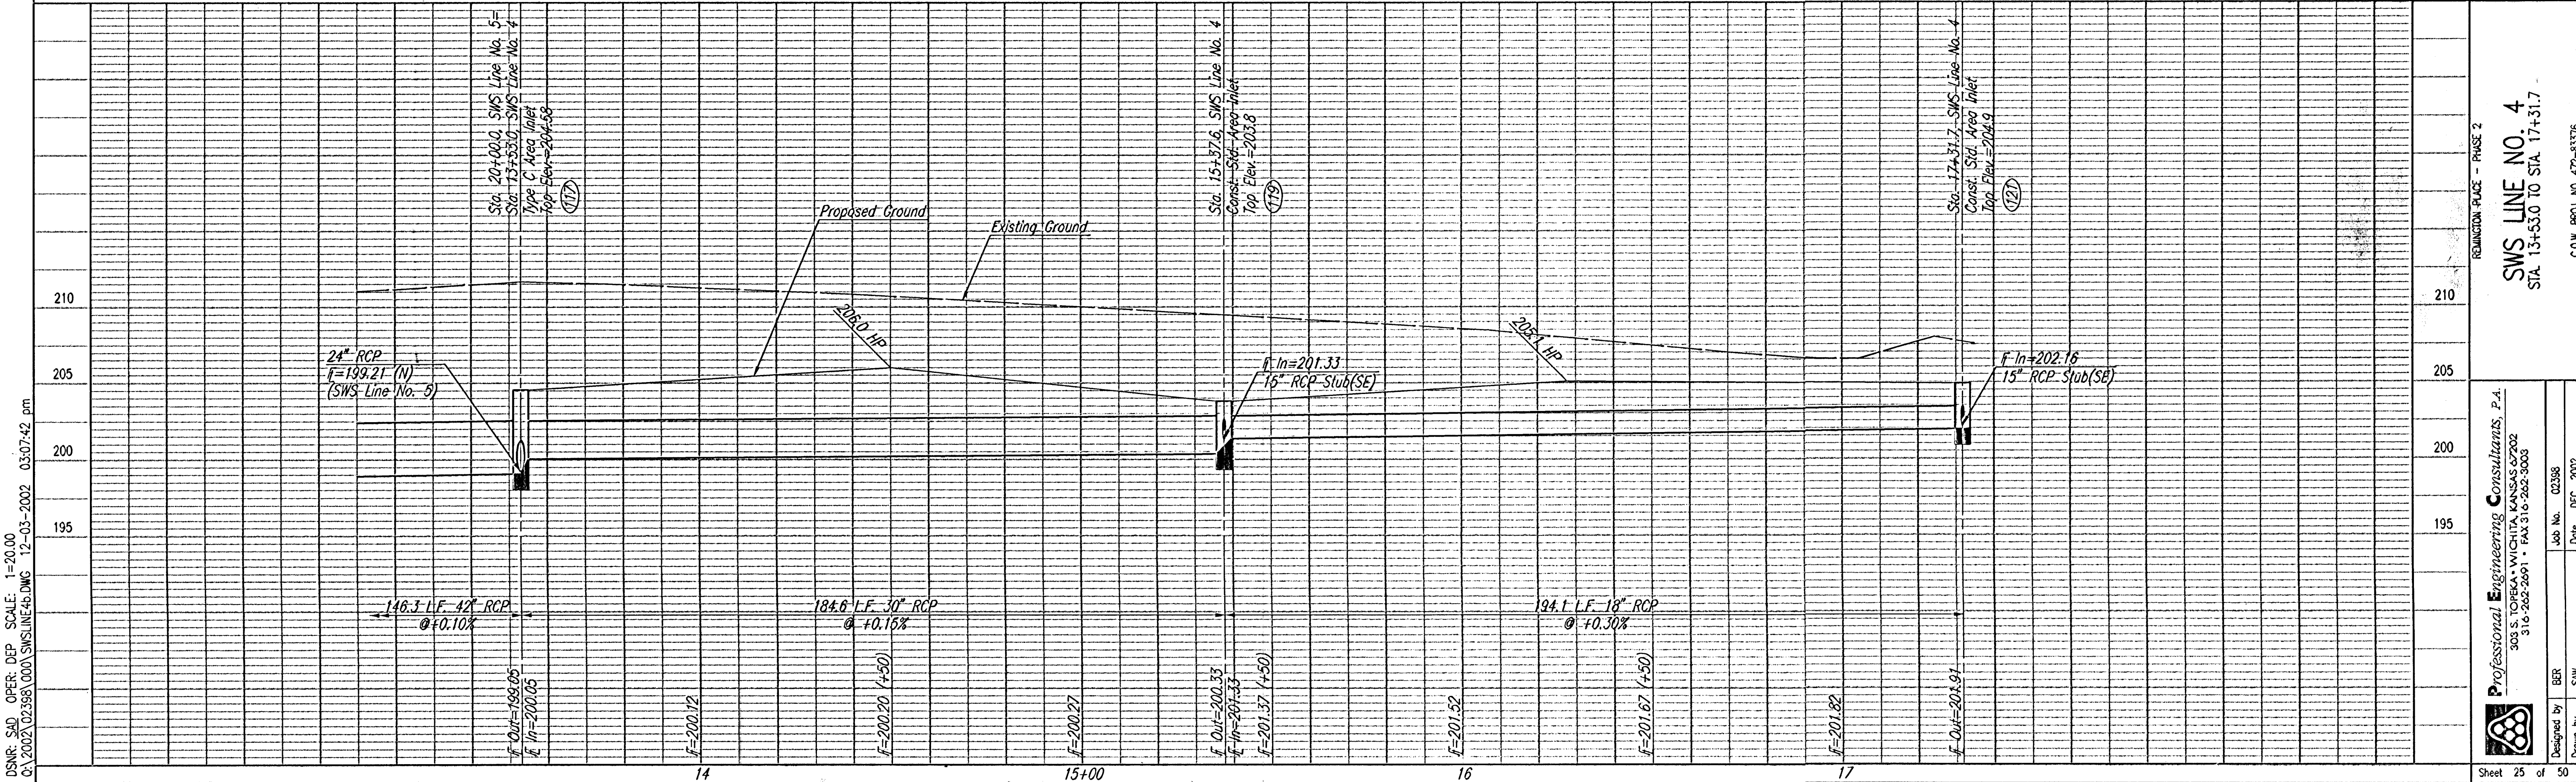

DSNR: SAO OPER: DEP SCALE: 1"=20.00
Q:\2002\02398\000\SWLINE46.DWG 12-03-2002 03:07:42 pm