


DSNR: SAW OPER. ILS SCALE: 1"=100.00
Q:\2002\02398\000\CHANGE ORDER\05-13-03\4CORNER 11-21-2003 08:21:38 am

SCALE: 1" = 100'

REMINGTON PLACE






AN ADDITION TO WICHITA, SEDGWICK COUNTY, KANSAS

PROJECT NO.	SHEET NO.	TOTAL SHEETS
472-83376	30	50

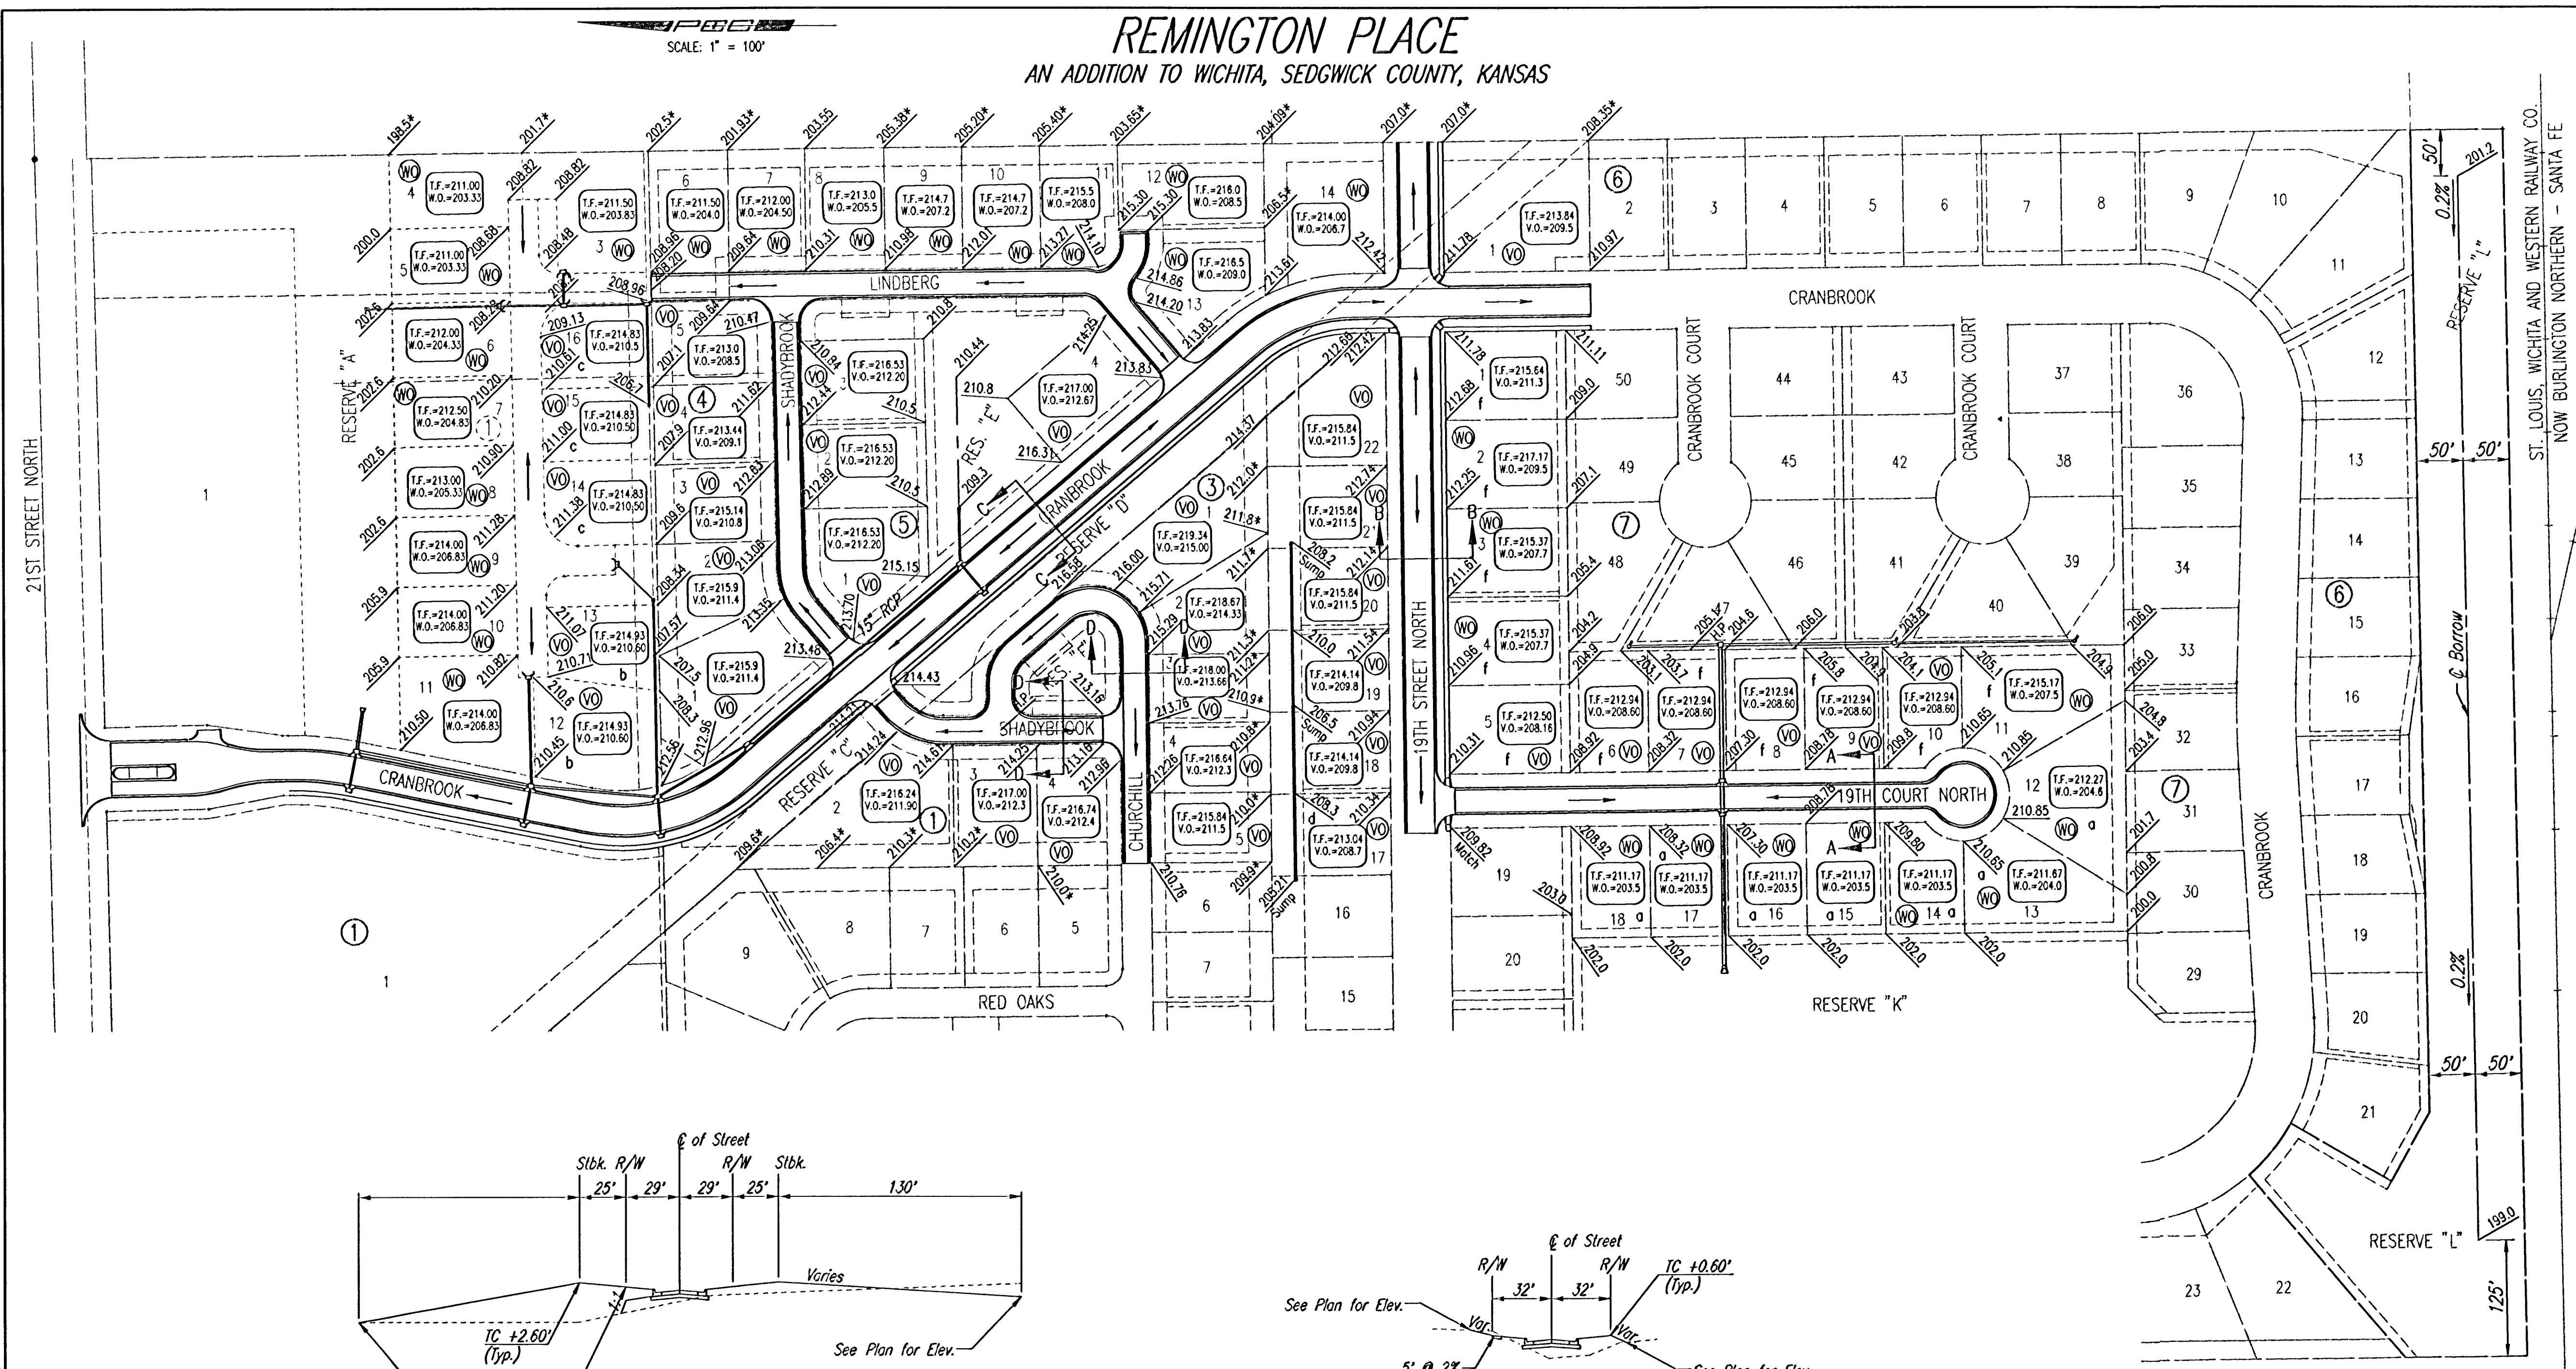

- a MINIMUM OPENING= 203.5
- b MINIMUM OPENING= 210.6
- c MINIMUM OPENING= 210.5
- d MINIMUM OPENING= 208.7
- f MINIMUM OPENING= 207.5

- (X) STD. BASEMENT
- (VO) VIEW-OUT BASEMENT
- (WO) WALK-OUT BASEMENT
- * MATCH EXISTING

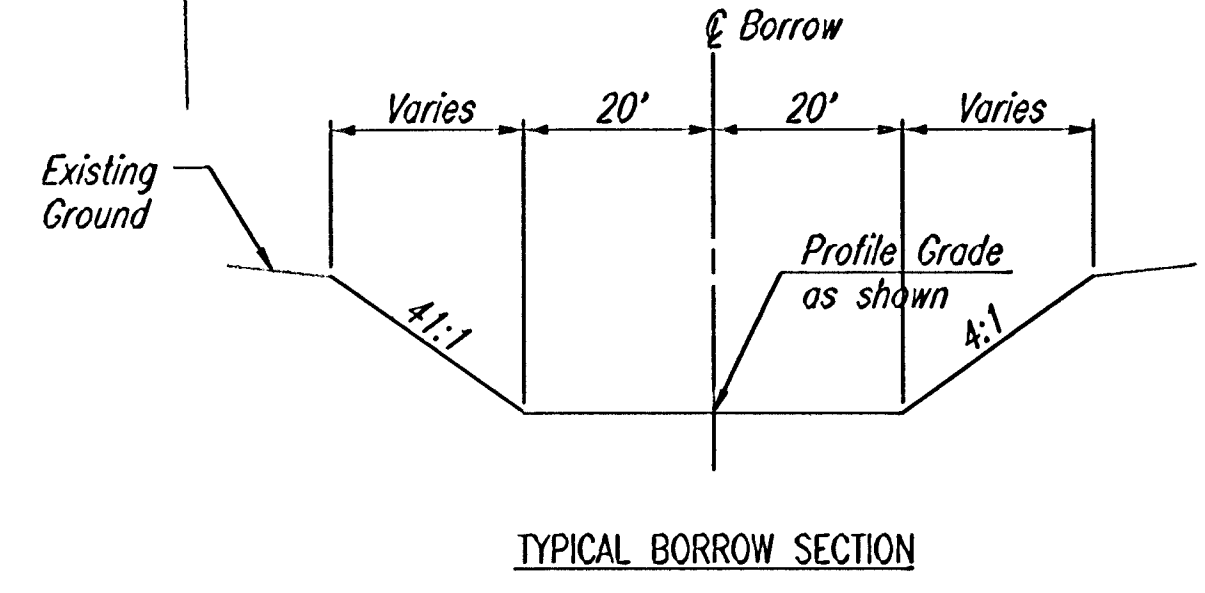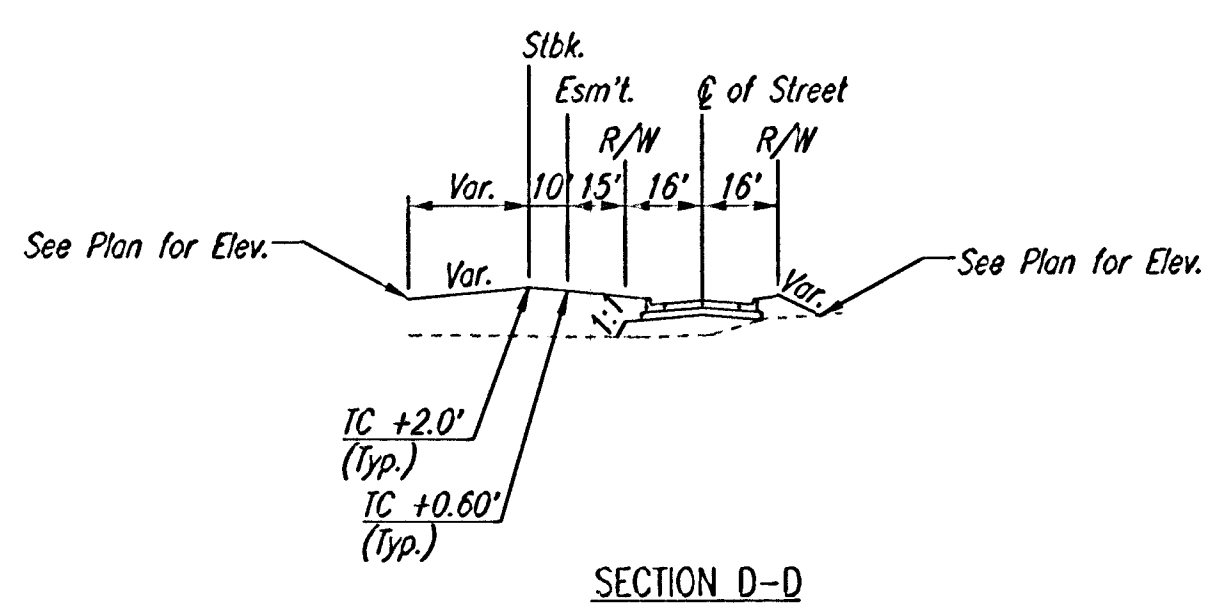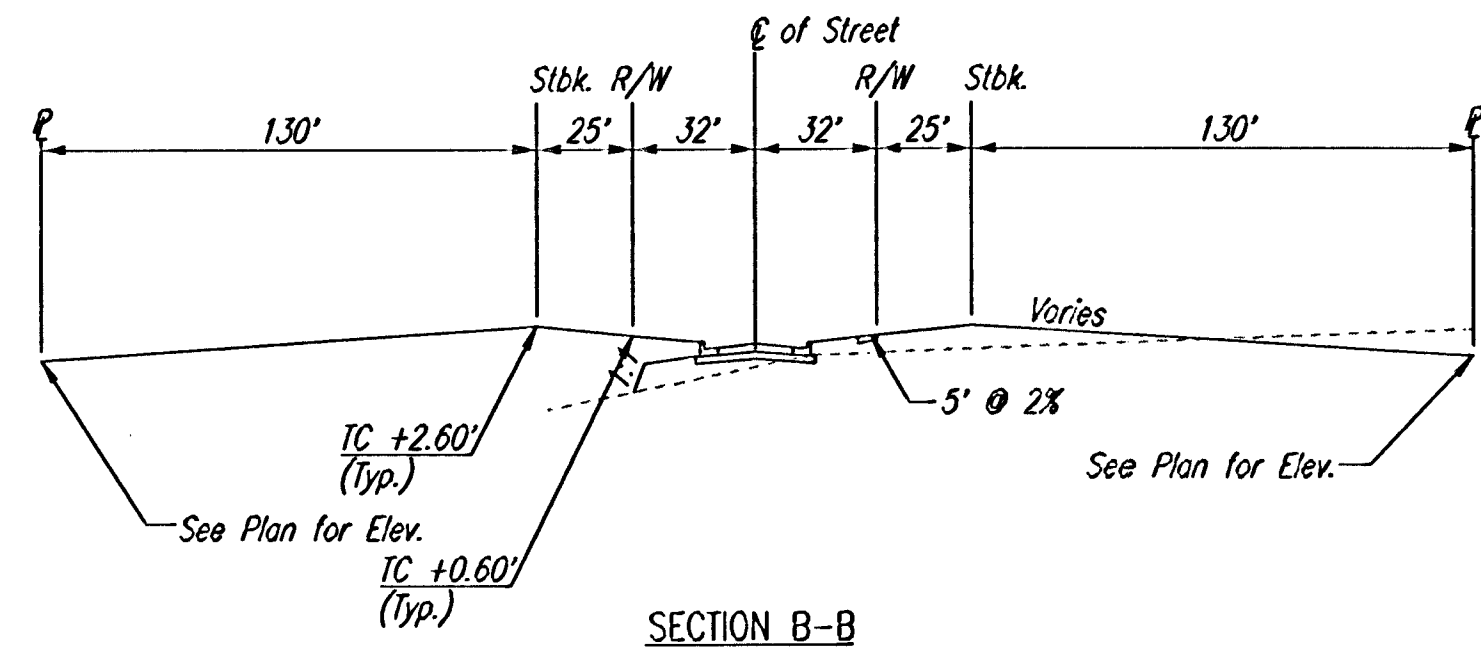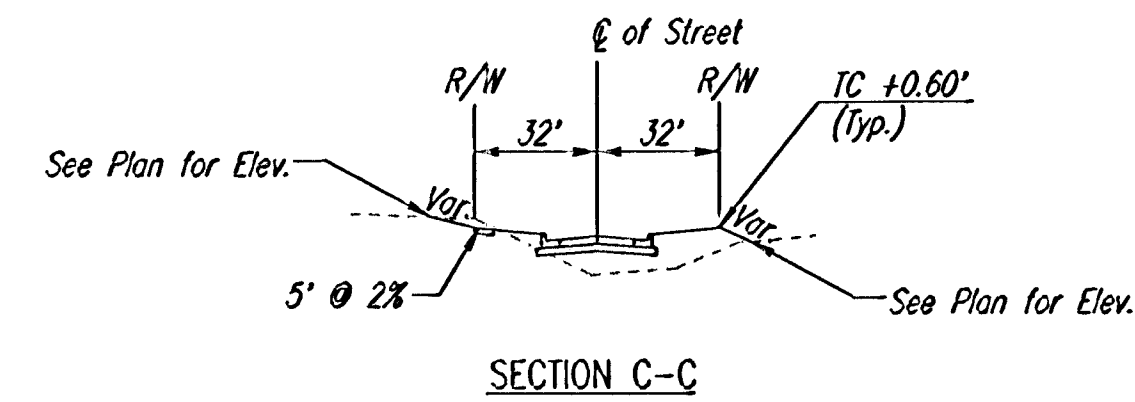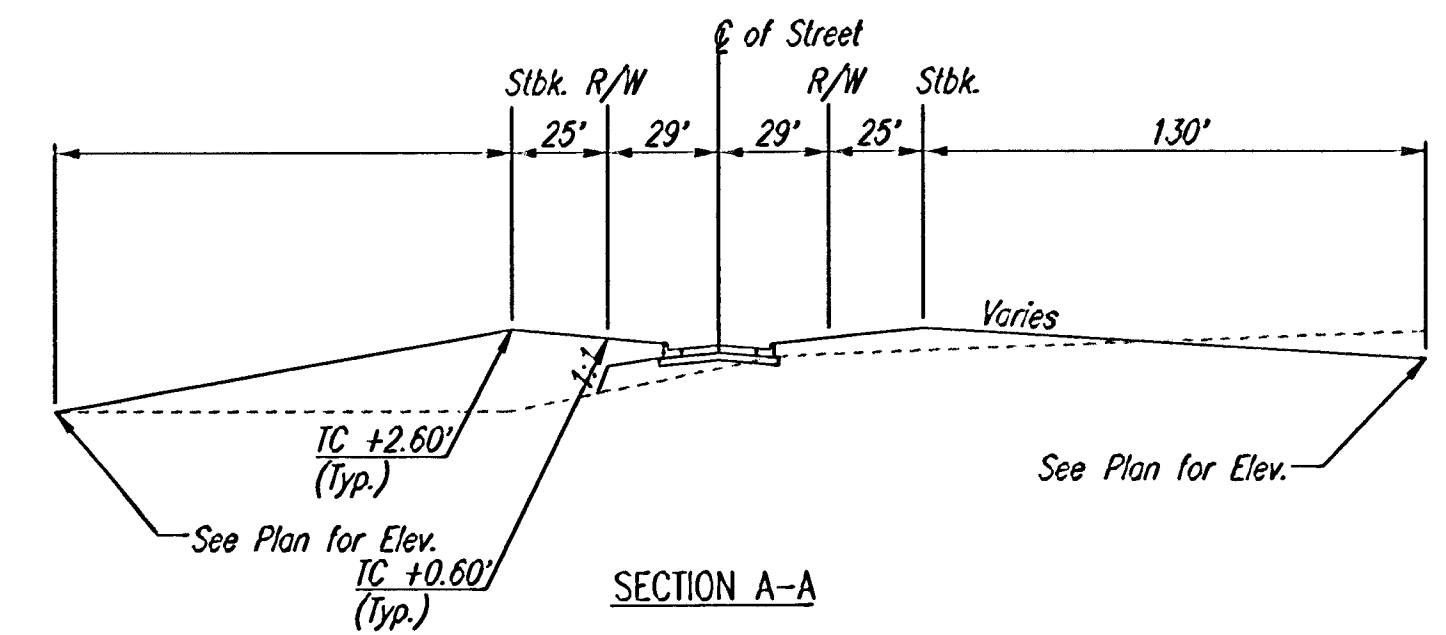

RECORD DRAWING
Professional Engineering Consultants, P.A.
24 NOV 03
REVISED 05/13/03

FOUR CORNER LOT GRADING

Professional Engineering Consultants, P.A. 303 S. TOPEKA • WICHITA, KANSAS 67202 316-262-2691 • FAX 316-262-3003			
Designed by	BER	Checked by	
Drawn by	SAW	Date	DEC., 2002
		Job No.	02398