


NOTE BOOK TEMPLATE
AREAS
AREAS CHECKED
NO.

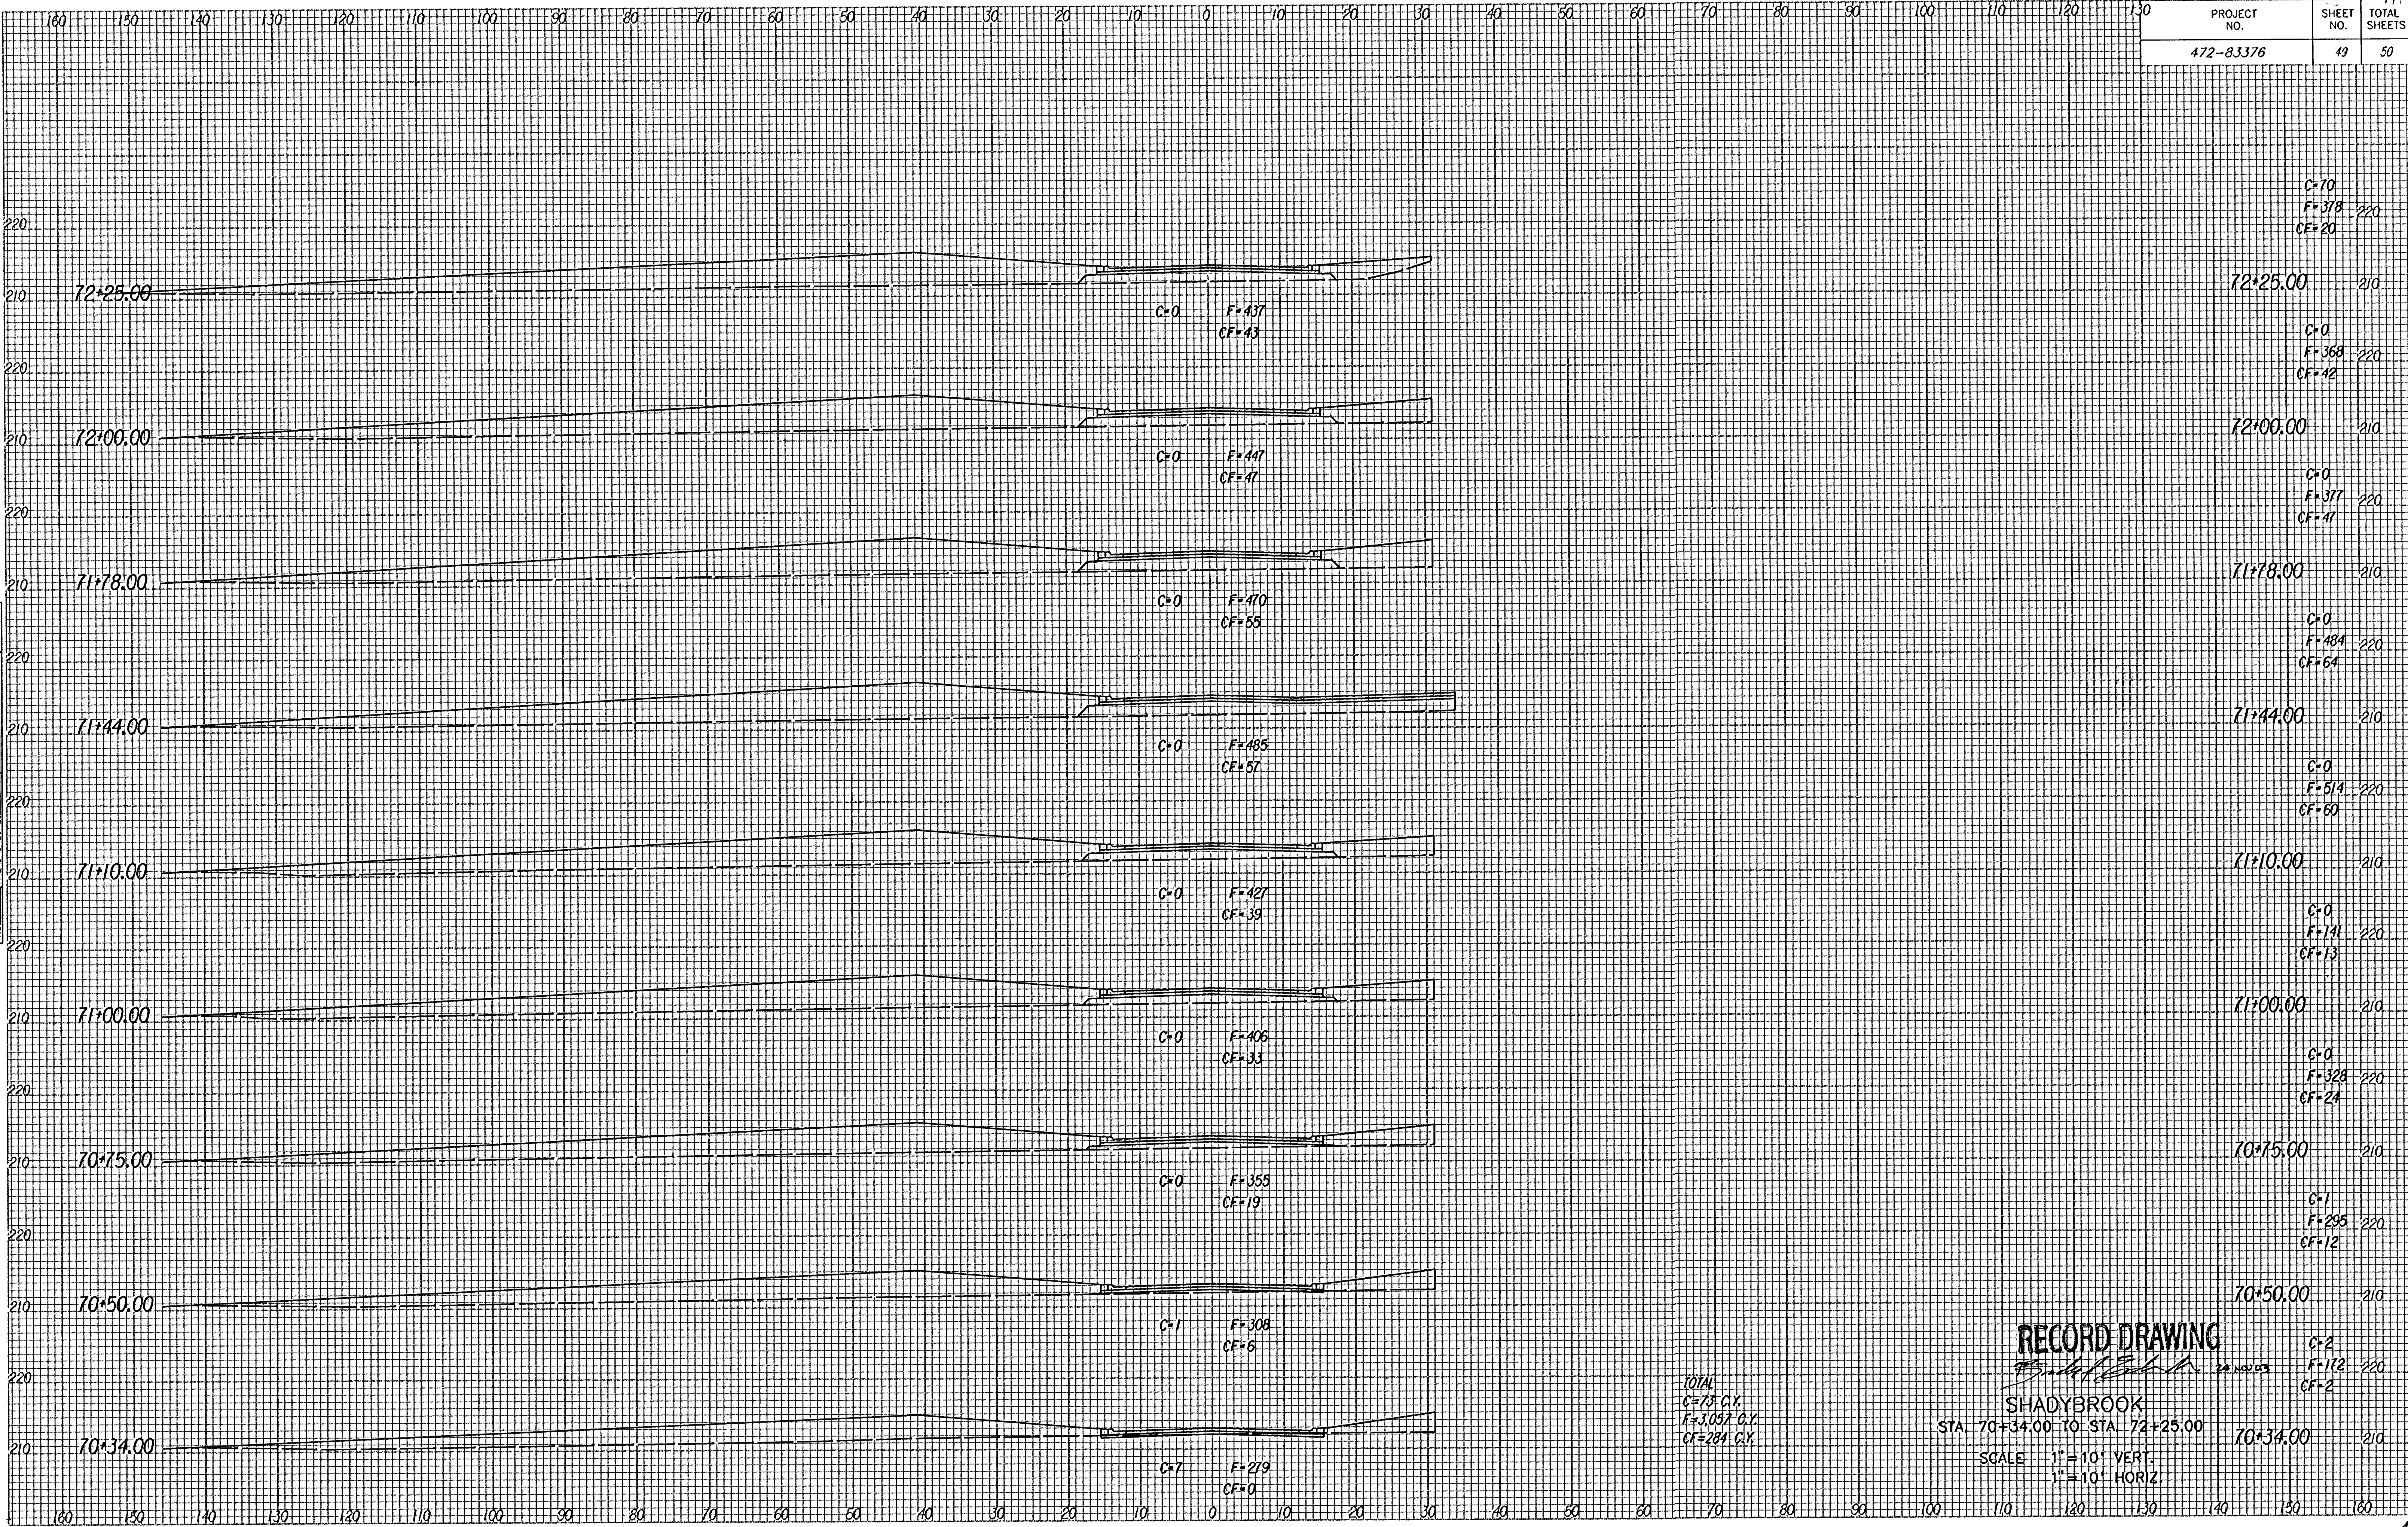

PROJECT NO.	SHEET NO.	TOTAL SHEETS
472-83376	49	50

TOTAL
C=73 G.Y.
F=3,037 G.Y.
CF=284 G.Y.

RECORD DRAWING
[Signature] 24 NOV 93
SHADYBROOK
STA 70+34.00 TO STA 72+25.00
SCALE 1"=10' VERT.
1"=10' HORIZ