

REMINGTON PLACE
AN ADDITION TO WICHITA, SEDGWICK COUNTY, KANSAS

SCALE: 1" = 100'


PROJECT NO.	SHEET NO.	TOTAL SHEETS
472-83377	12	23

- a MINIMUM OPENING= 203.5
b MINIMUM OPENING= 210.6
c MINIMUM OPENING= 210.5
d MINIMUM OPENING= 208.7
f MINIMUM OPENING= 207.5

- (X) STD. BASEMENT
(VO) VIEW-OUT BASEMENT
(WO) WALK-OUT BASEMENT

* Match existing

ST. LOUIS, WICHITA AND WESTERN RAILWAY CO.
NOW BURLINGTON NORTHERN - SANTA FE

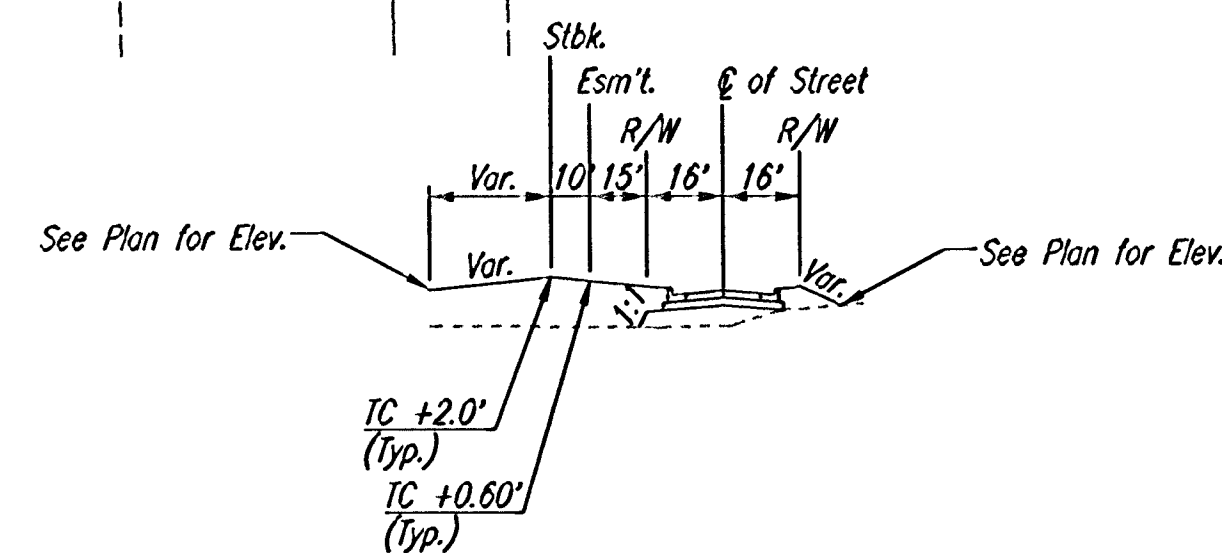

SECTION D-D

REMINGTON PLACE - PHASE 3

RECORD DRAWING
B. J. [Signature]
24 NOV 03

FOUR CORNER LOT GRADING



Professional Engineering Consultants, P.A.
303 S. TOPEKA • WICHITA, KANSAS 67202
316-262-2691 • FAX 316-262-3003

Designed by	Checked by	
BER		
Drawn by	Date	Job No.
SAW	DEC, 2002	02398-004

DSNR: SAD OPER: DEP SCALE: 1"=100.00
CA: 2002102398004140CORNER 12-03-2002 03:44:38 pm