


NOTE BOOK	TEMPLATE	AREAS	CHECKED
NO.			

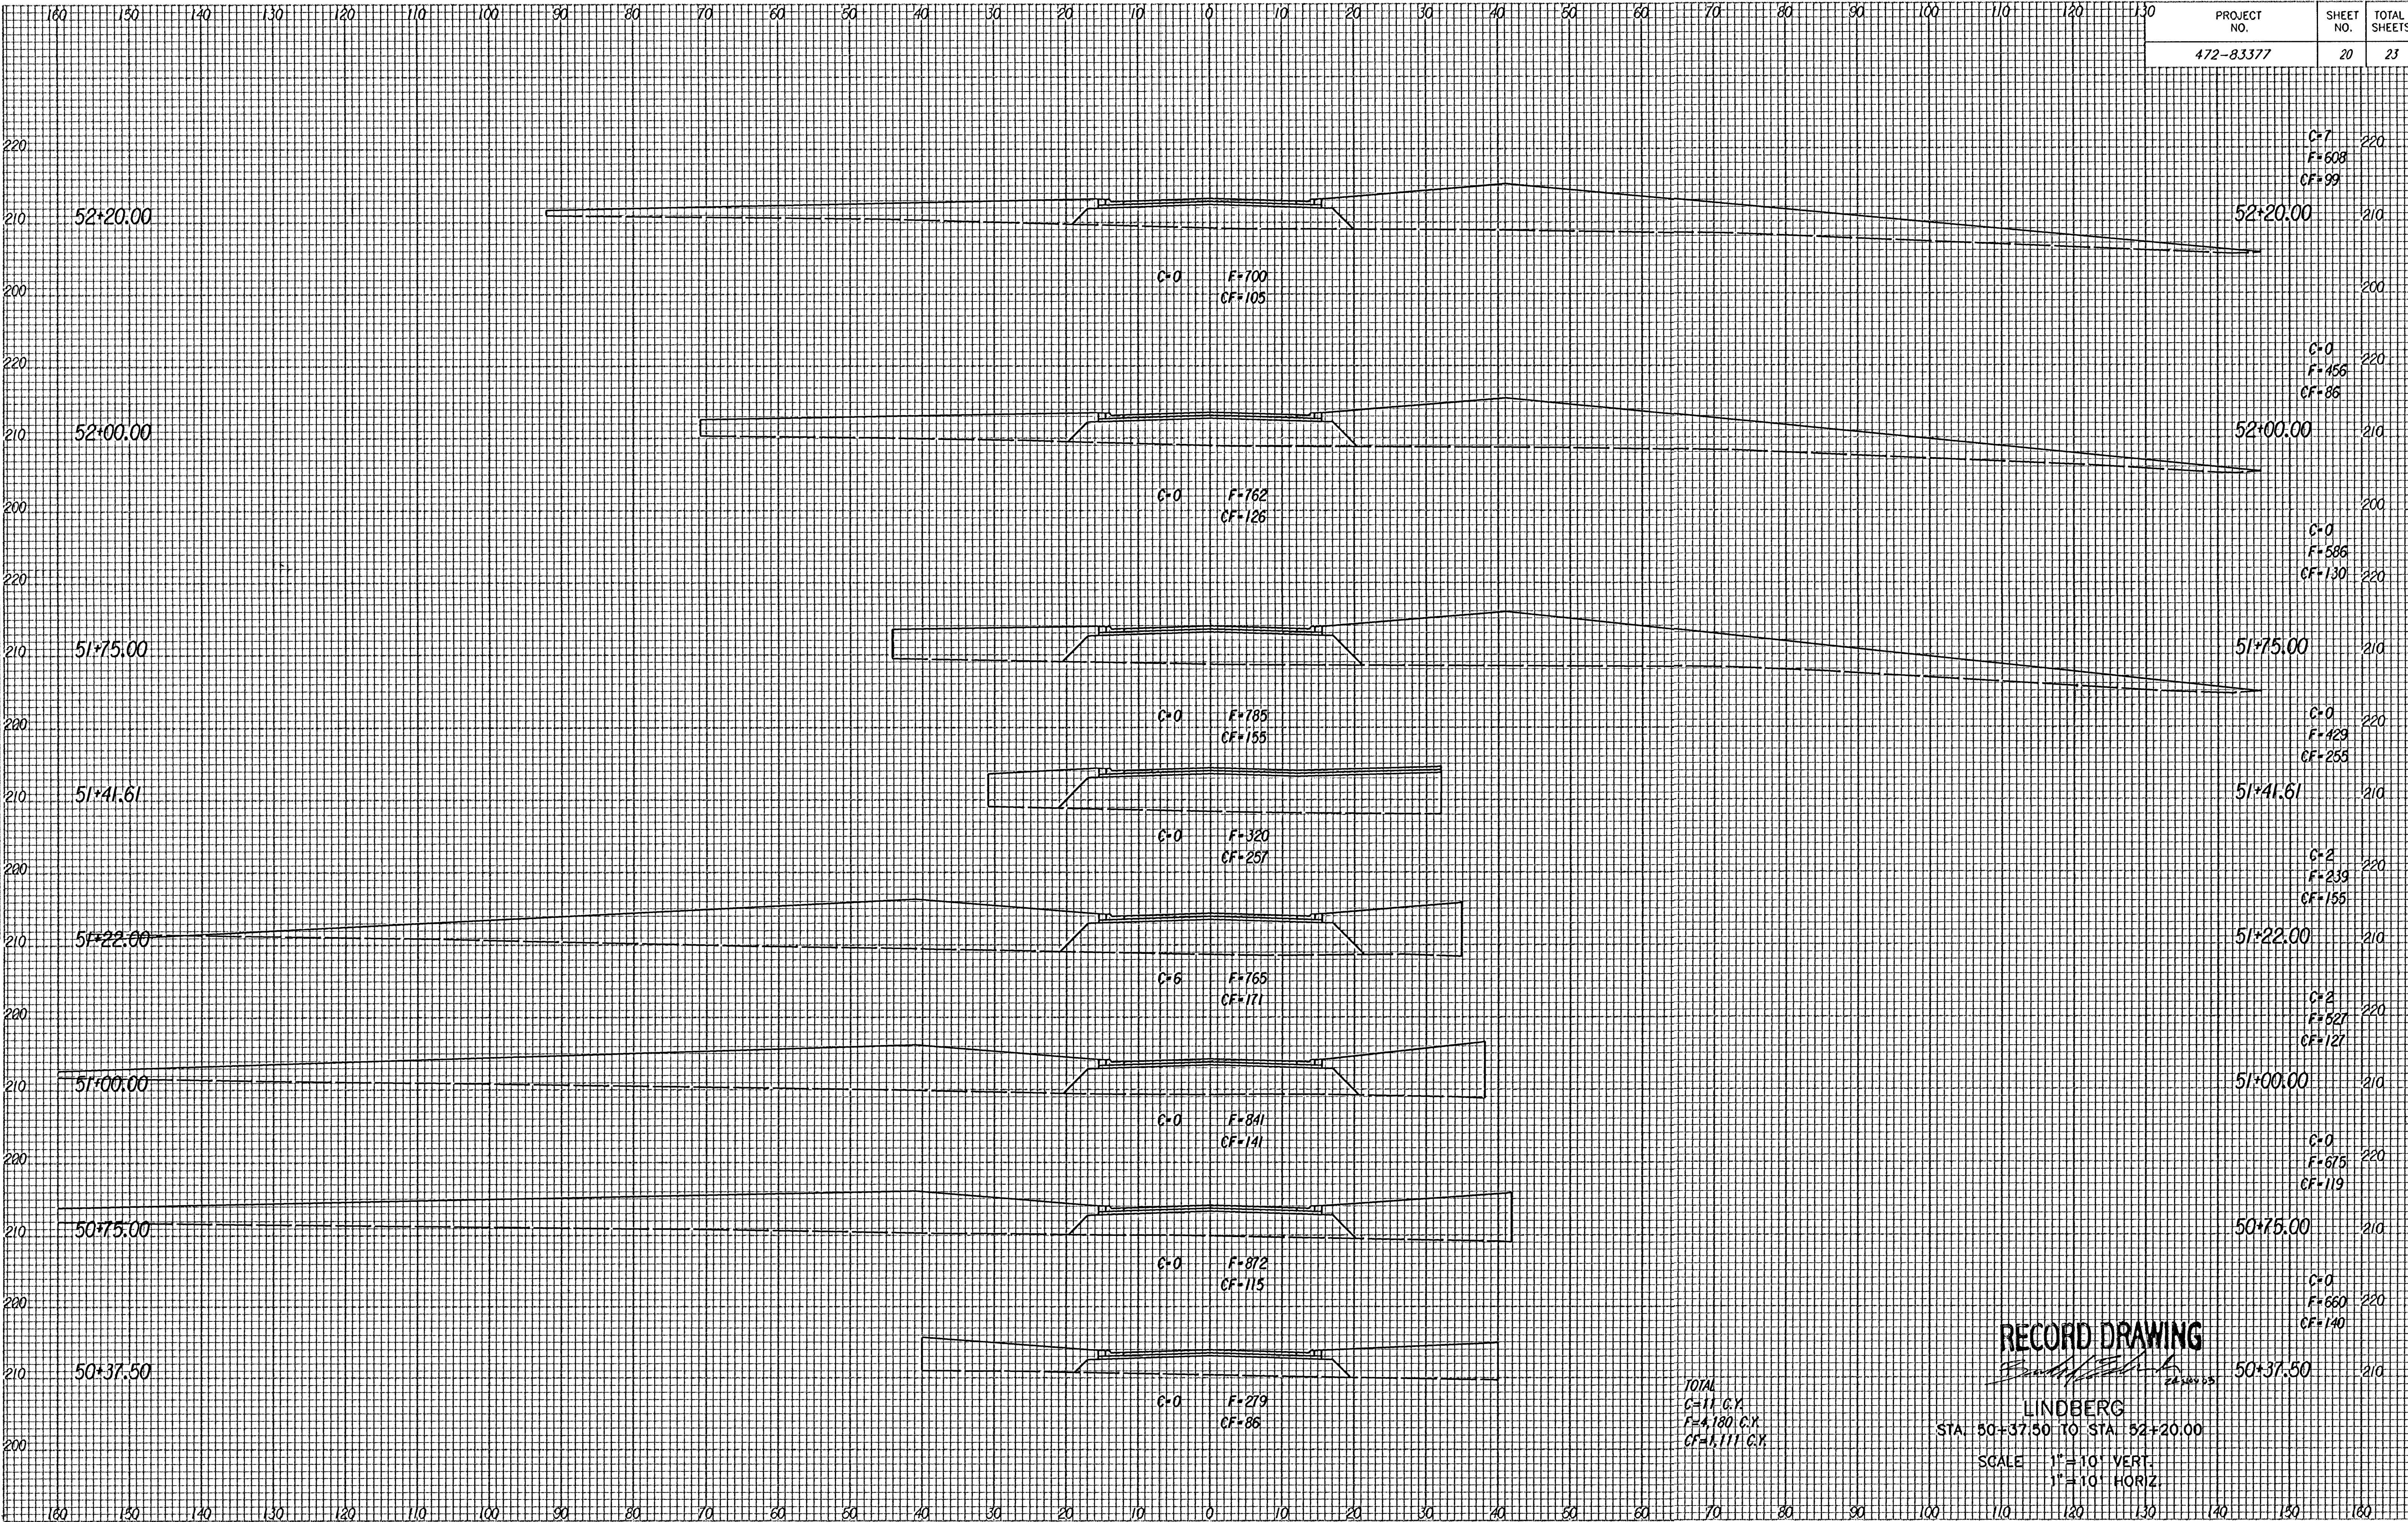

PROJECT NO.	SHEET NO.	TOTAL SHEETS
472-83377	20	23

TOTAL
C=11 C.Y.
F=4,180 C.Y.
CF=1,111 C.Y.

RECORD DRAWING

LINDBERG

STA. 50+37.50 TO STA. 52+20.00

SCALE 1"=10' VERT.
1"=10' HORIZ.

50+37.50 210

C+0
F=660
CF=140 220

C+0
F=675
CF=119 220

C+2
F=527
CF=127 220

C+2
F=239
CF=155 220

C+0
F=429
CF=255 220

C+0
F=585
CF=130 220

C+0
F=456
CF=86 220

C+0
F=700
CF=105 200

C+7
F=608
CF=99 220