



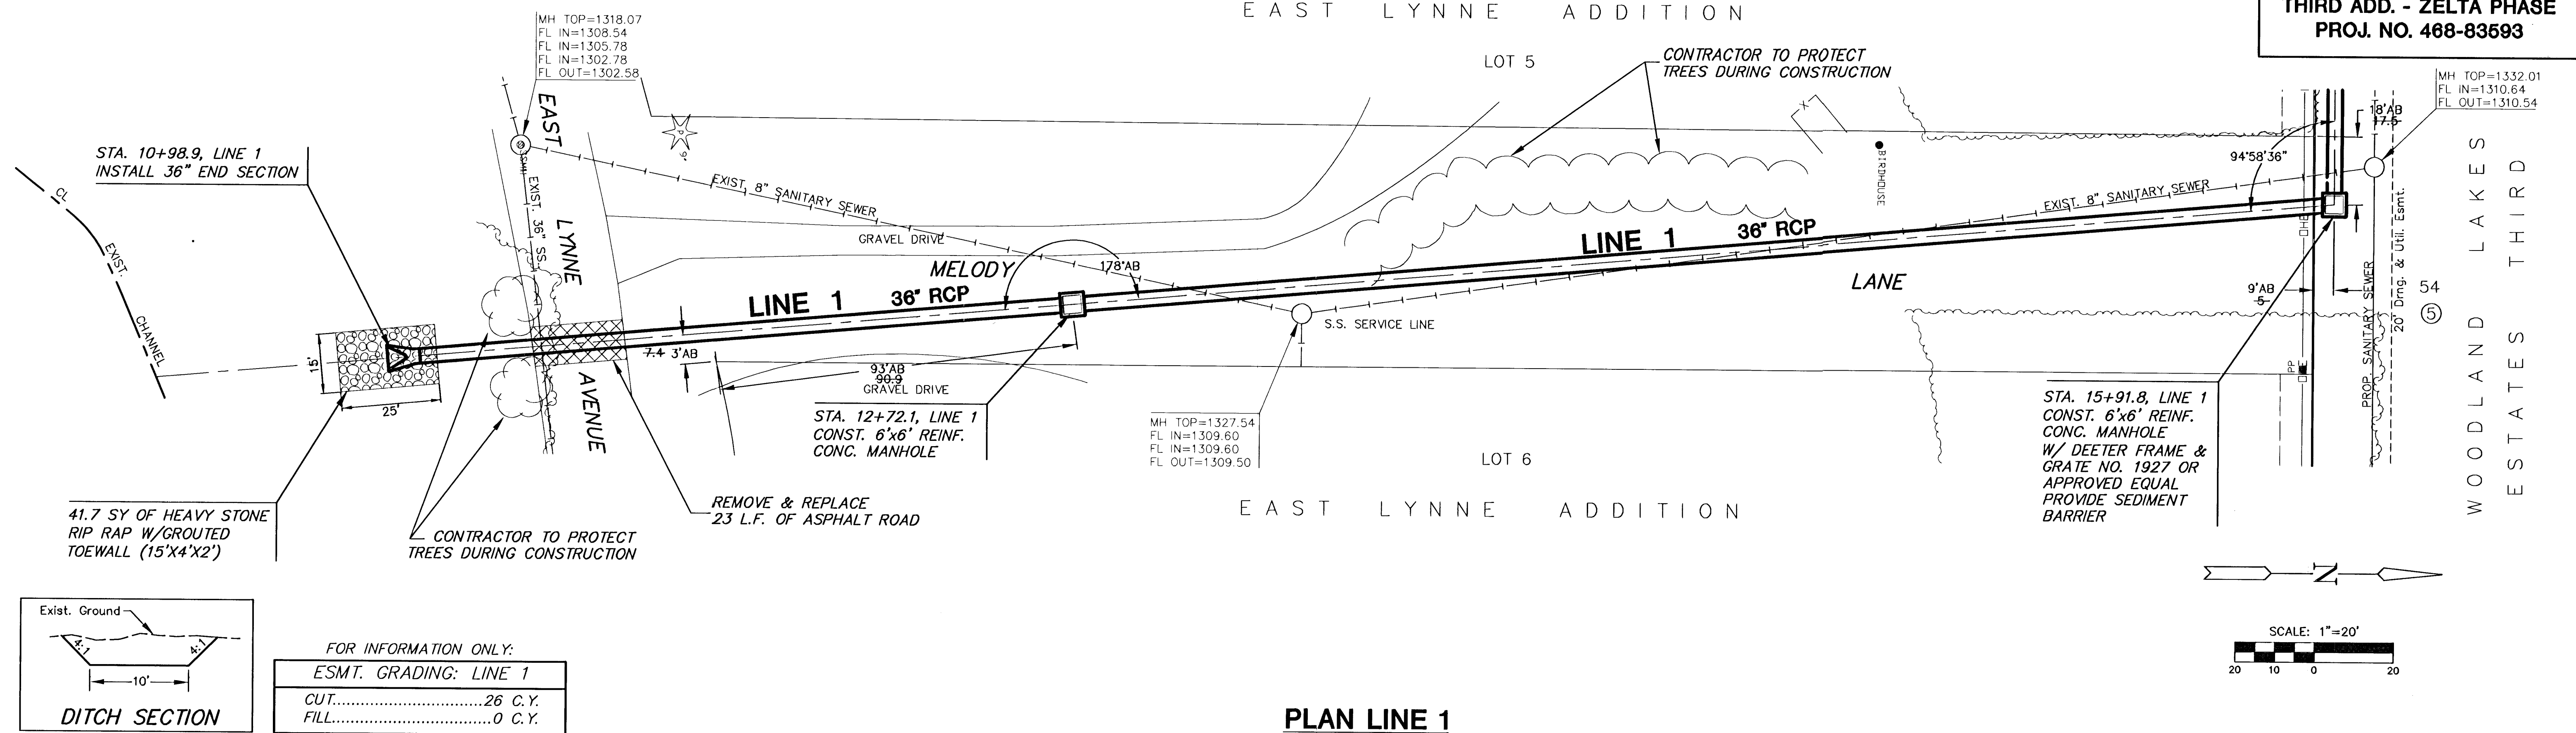

PLAN LINE 1

PROFILE LINE 1

SCALE: HORIZ. 1"=20'
SCALE: VERT. 1"=5'

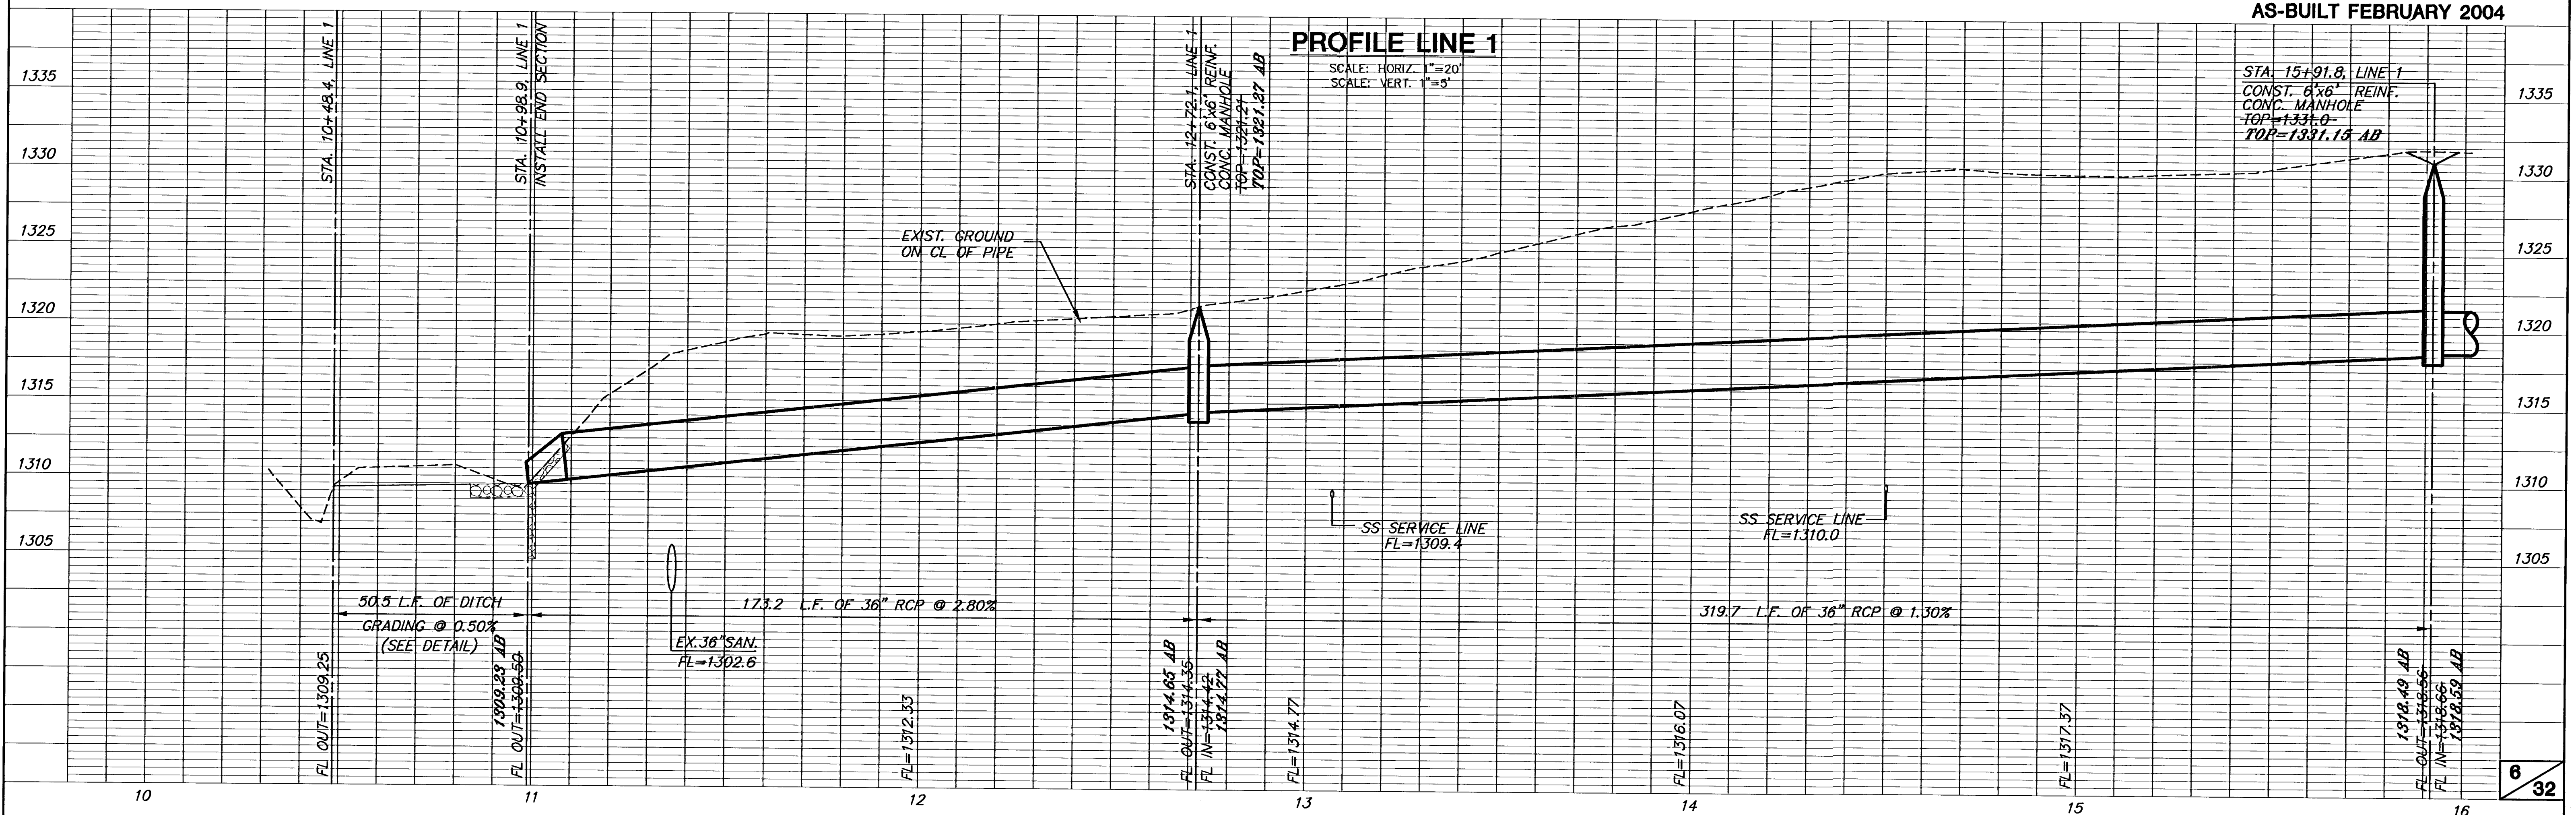

AS-BUILT FEBRUARY 2004

STA. 15+91.8, LINE 1
CONST. 6"x6" REINF.
CONC. MANHOLE
TOP=1331.0
TOP=1331.15 AB