




AS-BUILT FEBRUARY 2004

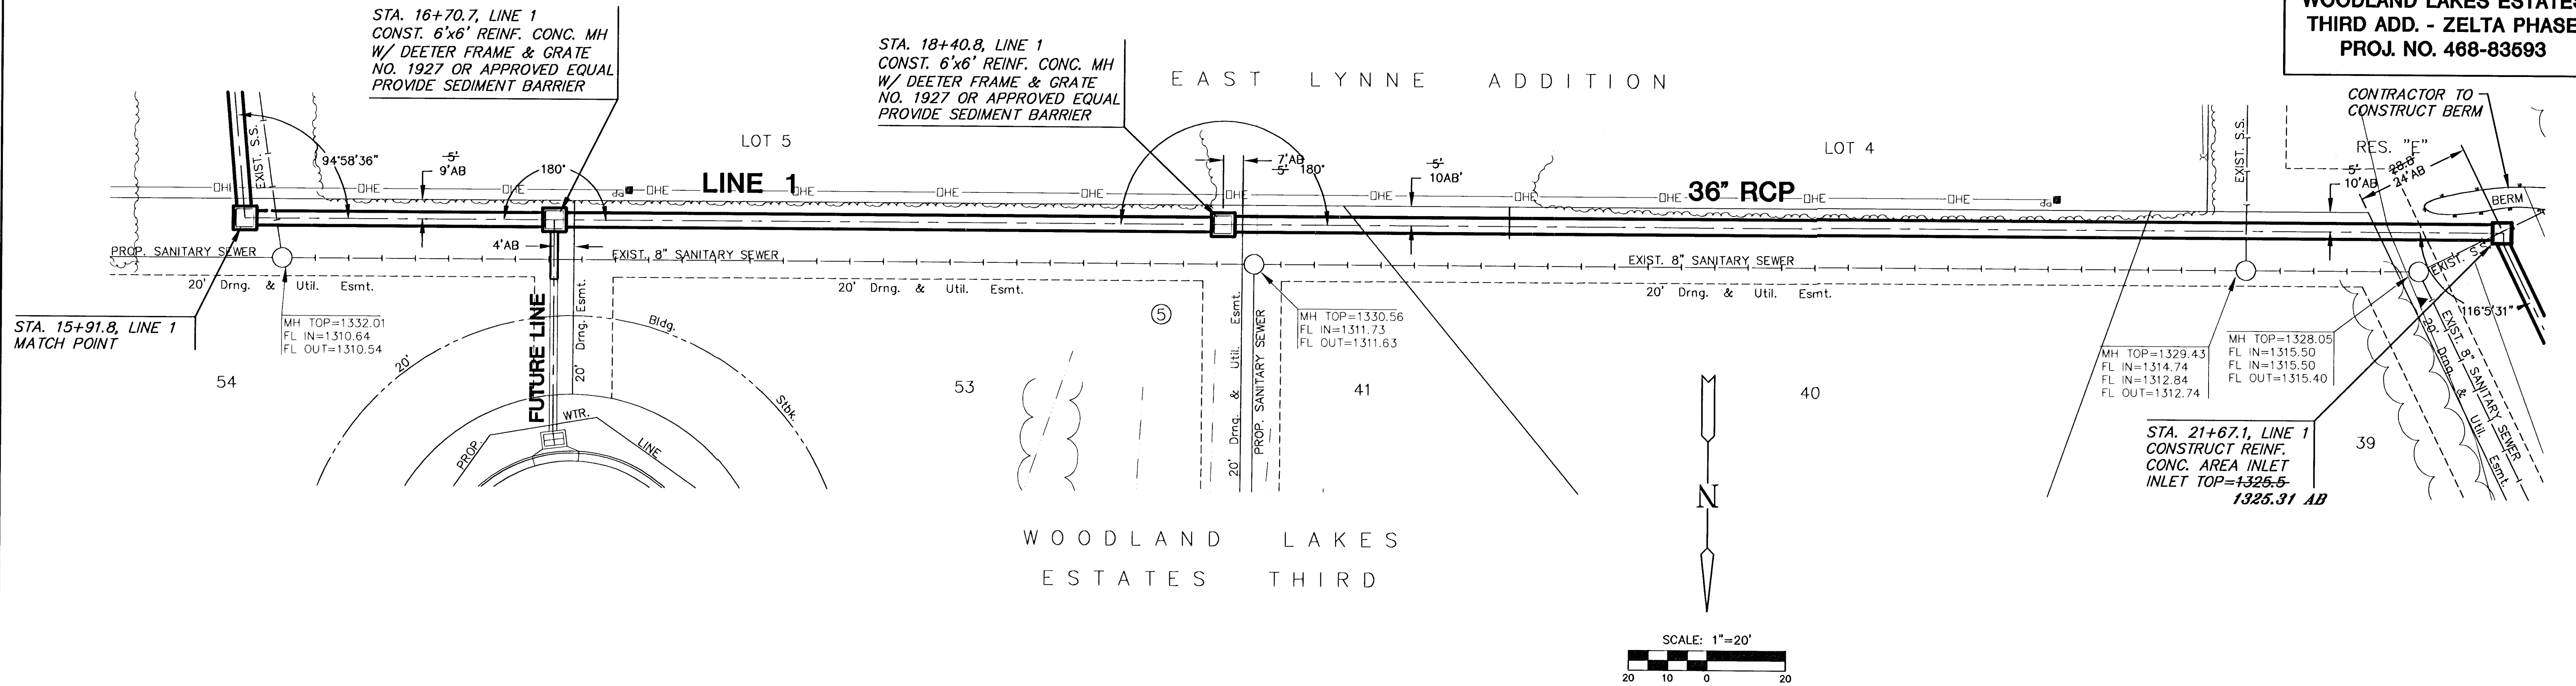