


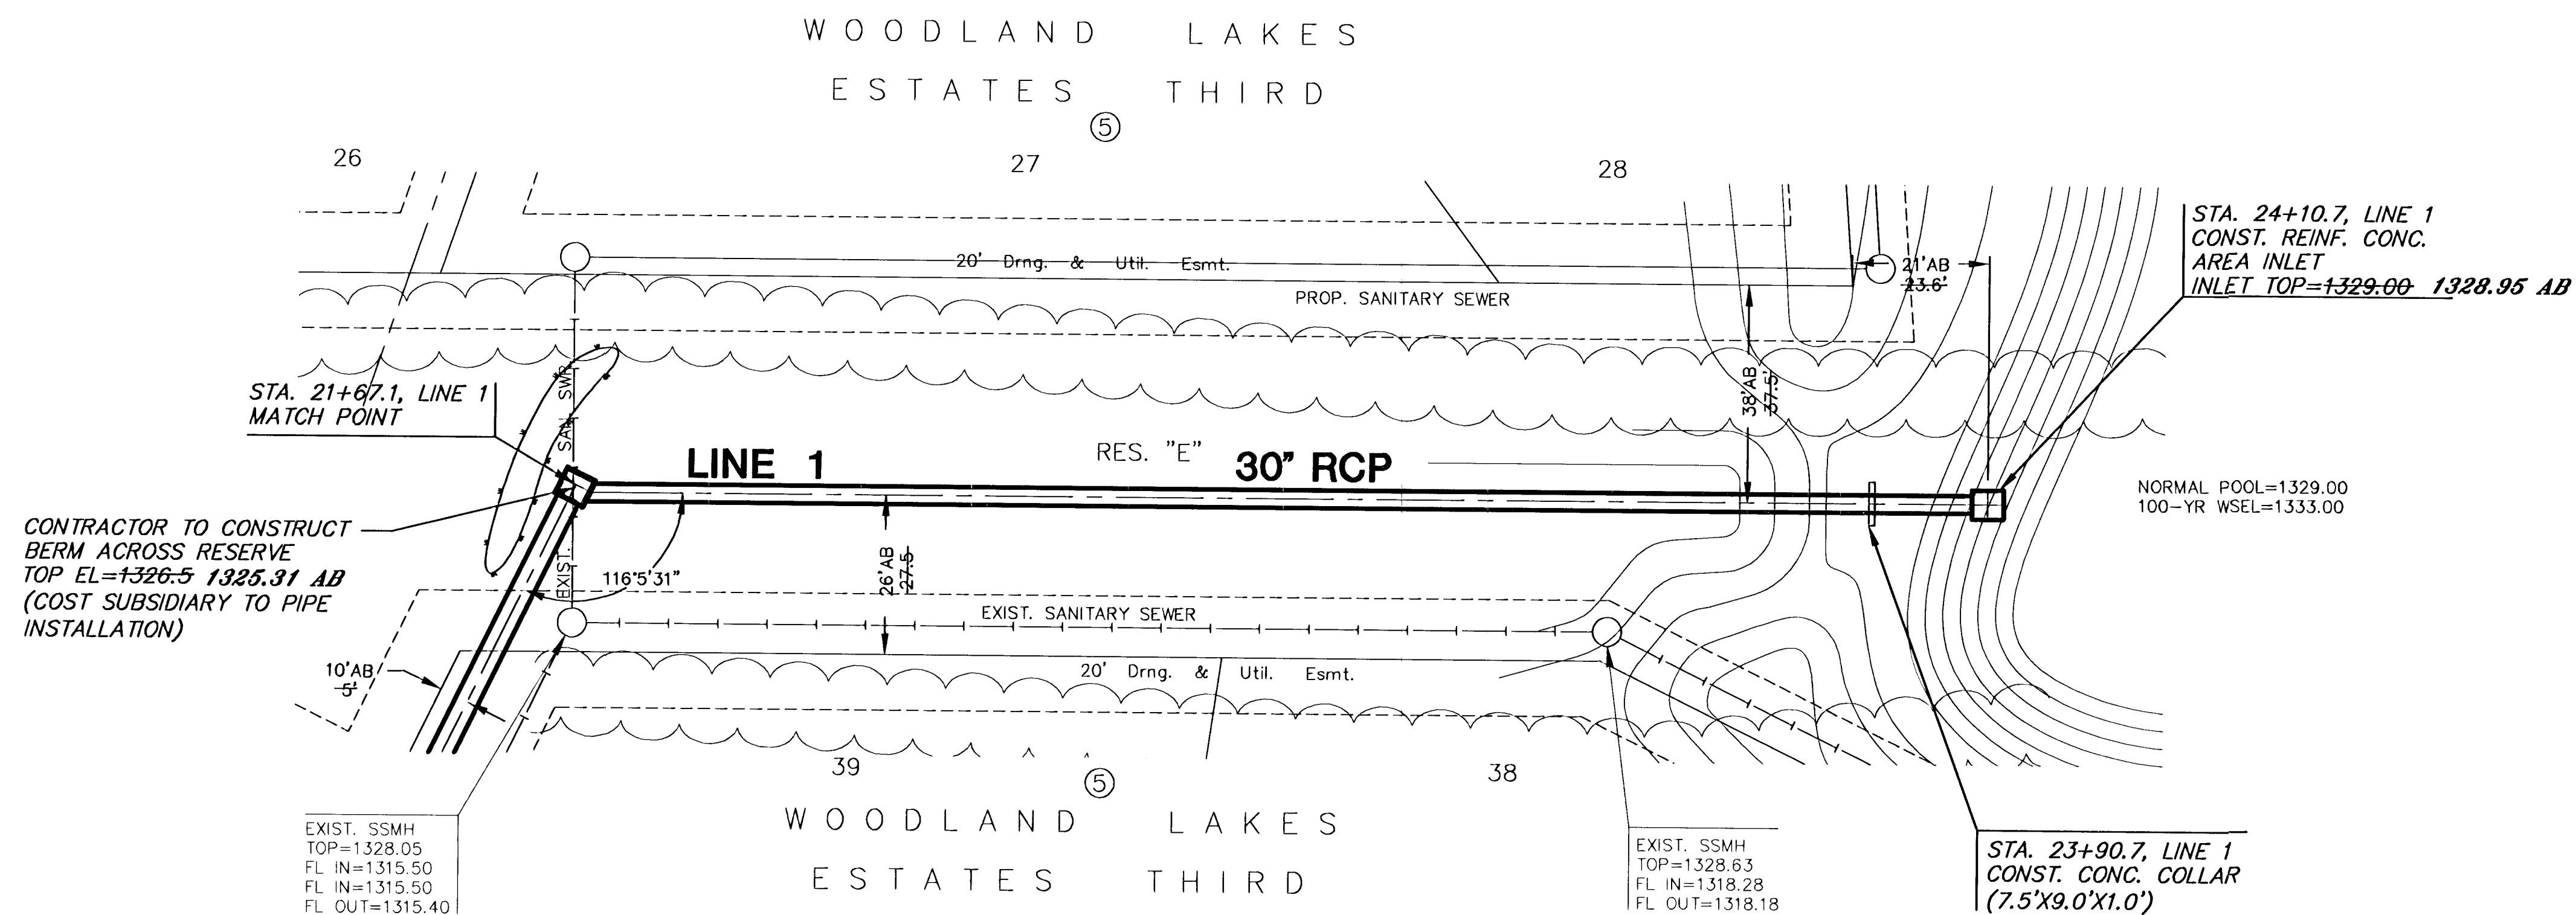

PLAN LINE 1

AS-BUILT FEBRUARY 2004

PROFILE LINE 1

SCALE: HORIZ. 1"=20'
SCALE: VERT. 1"=5'

