



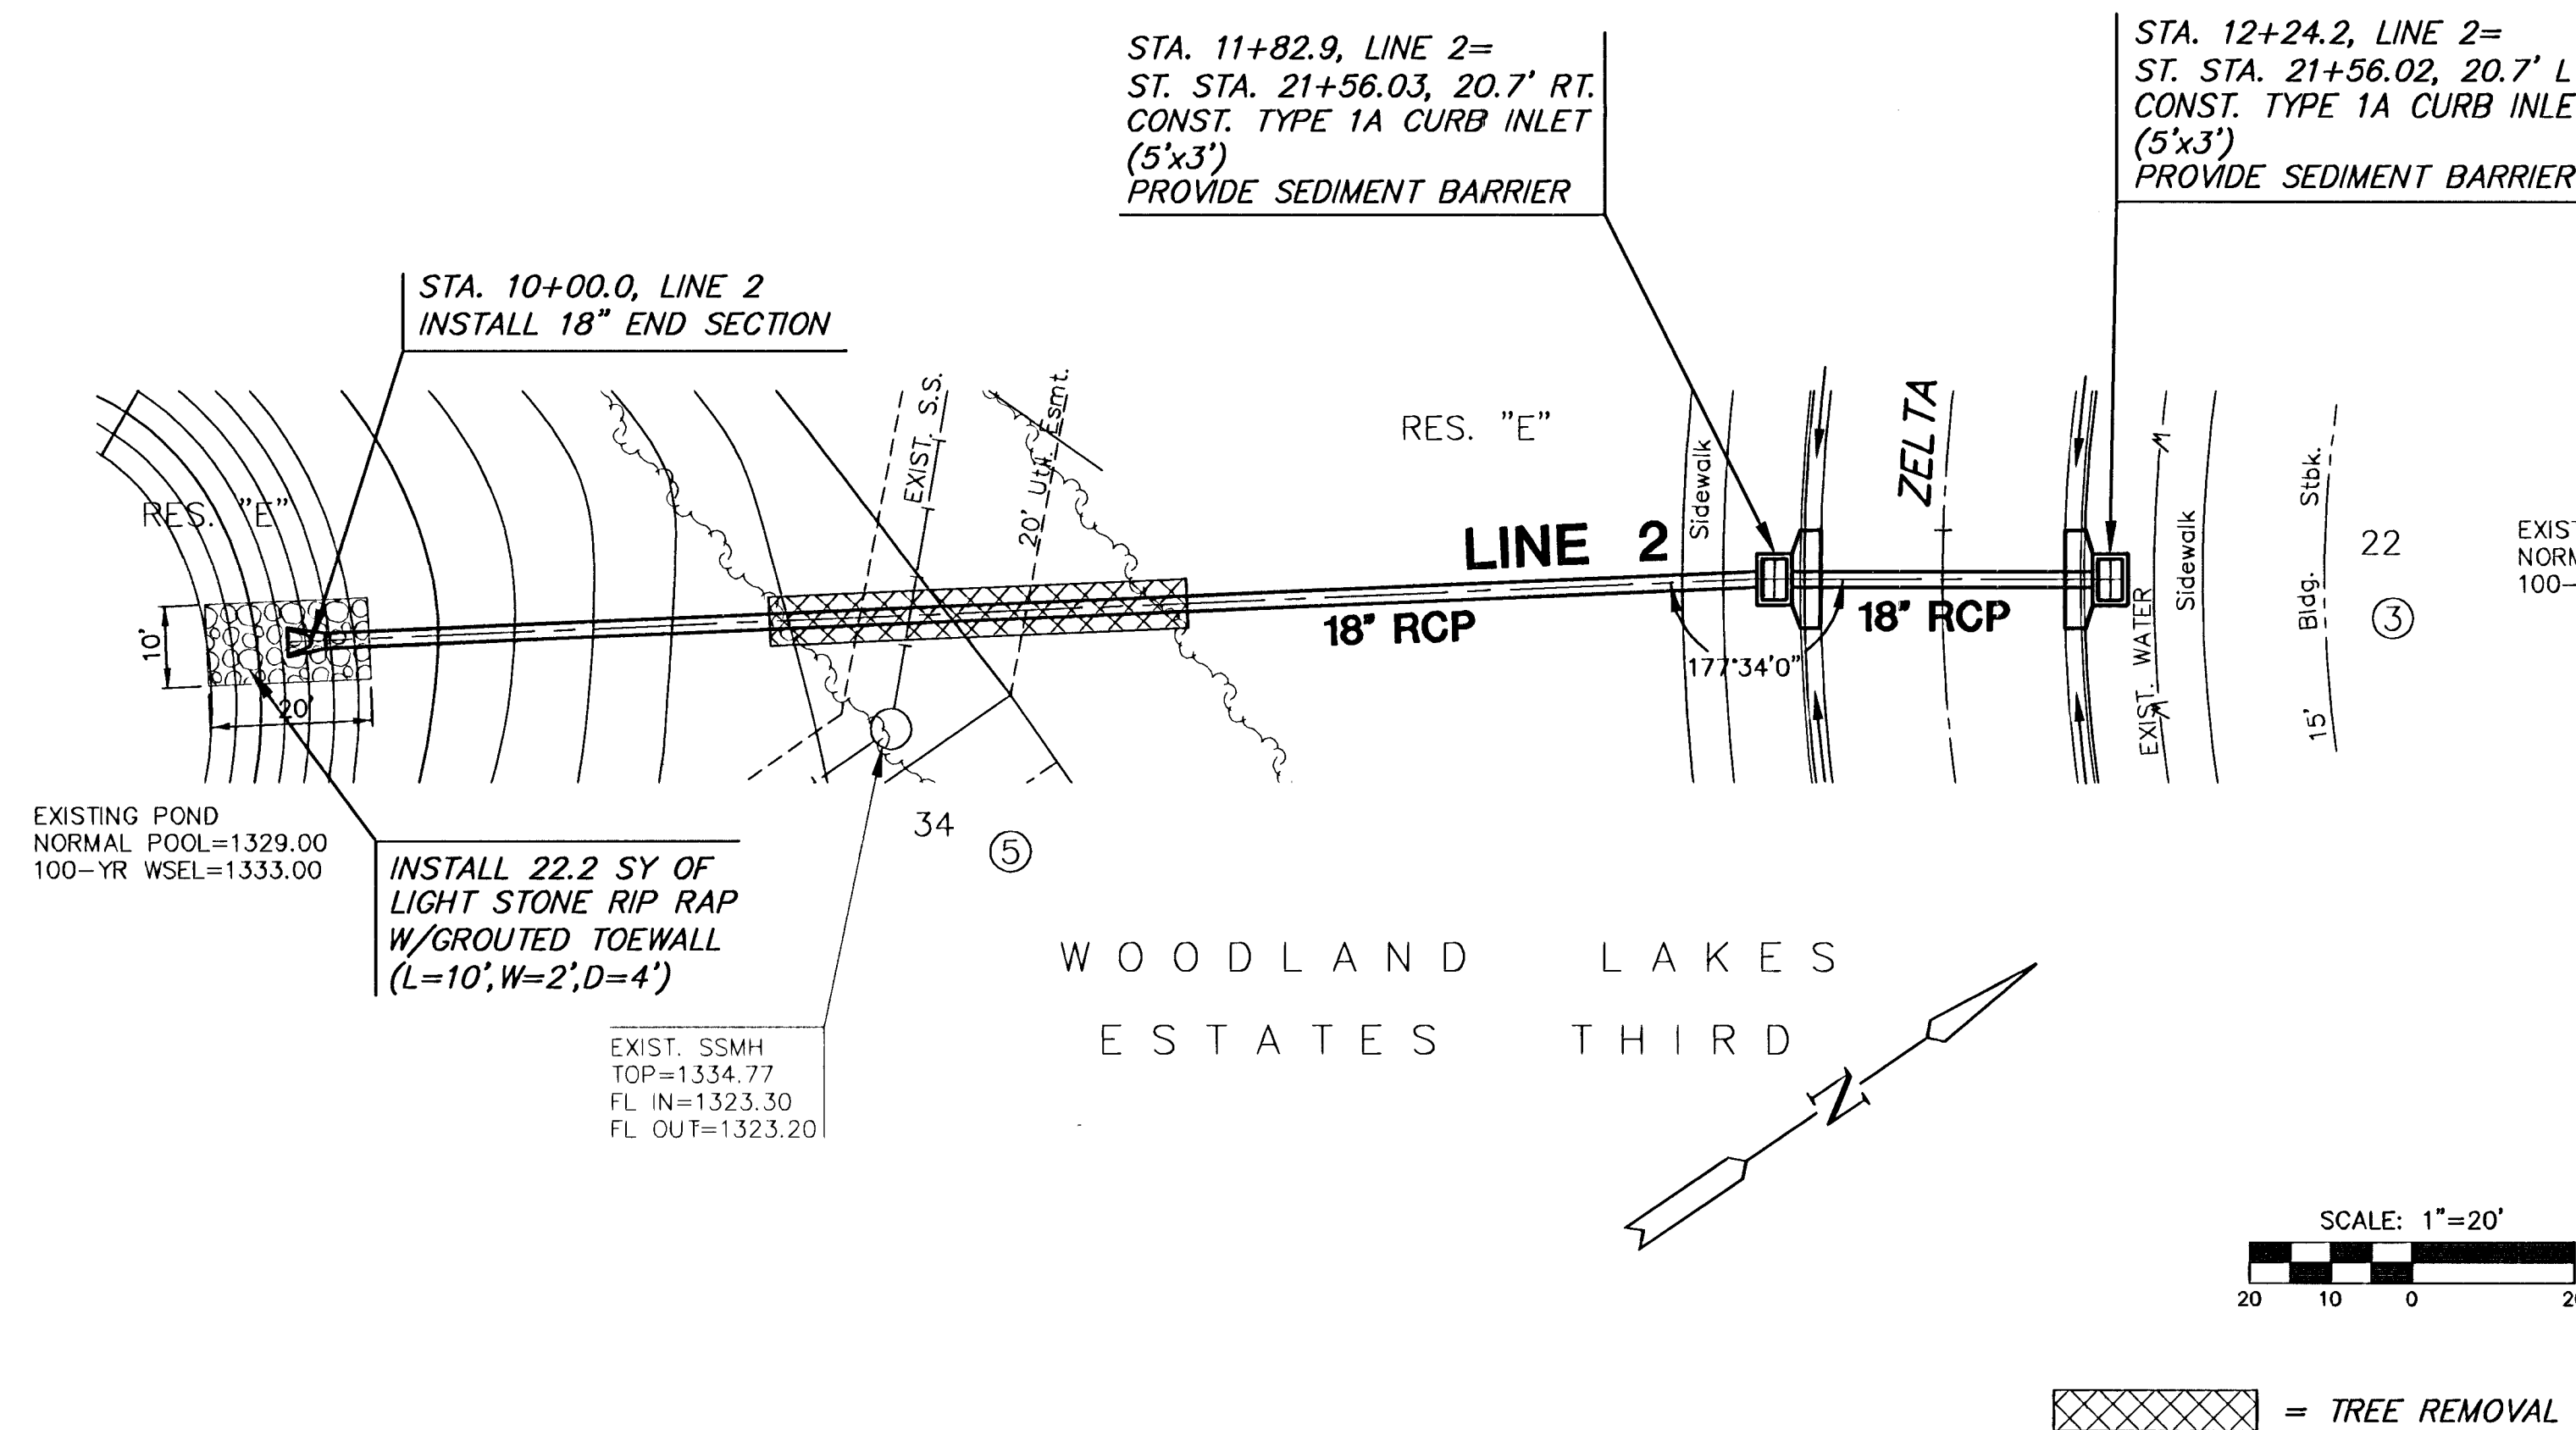

PLAN LINE 2

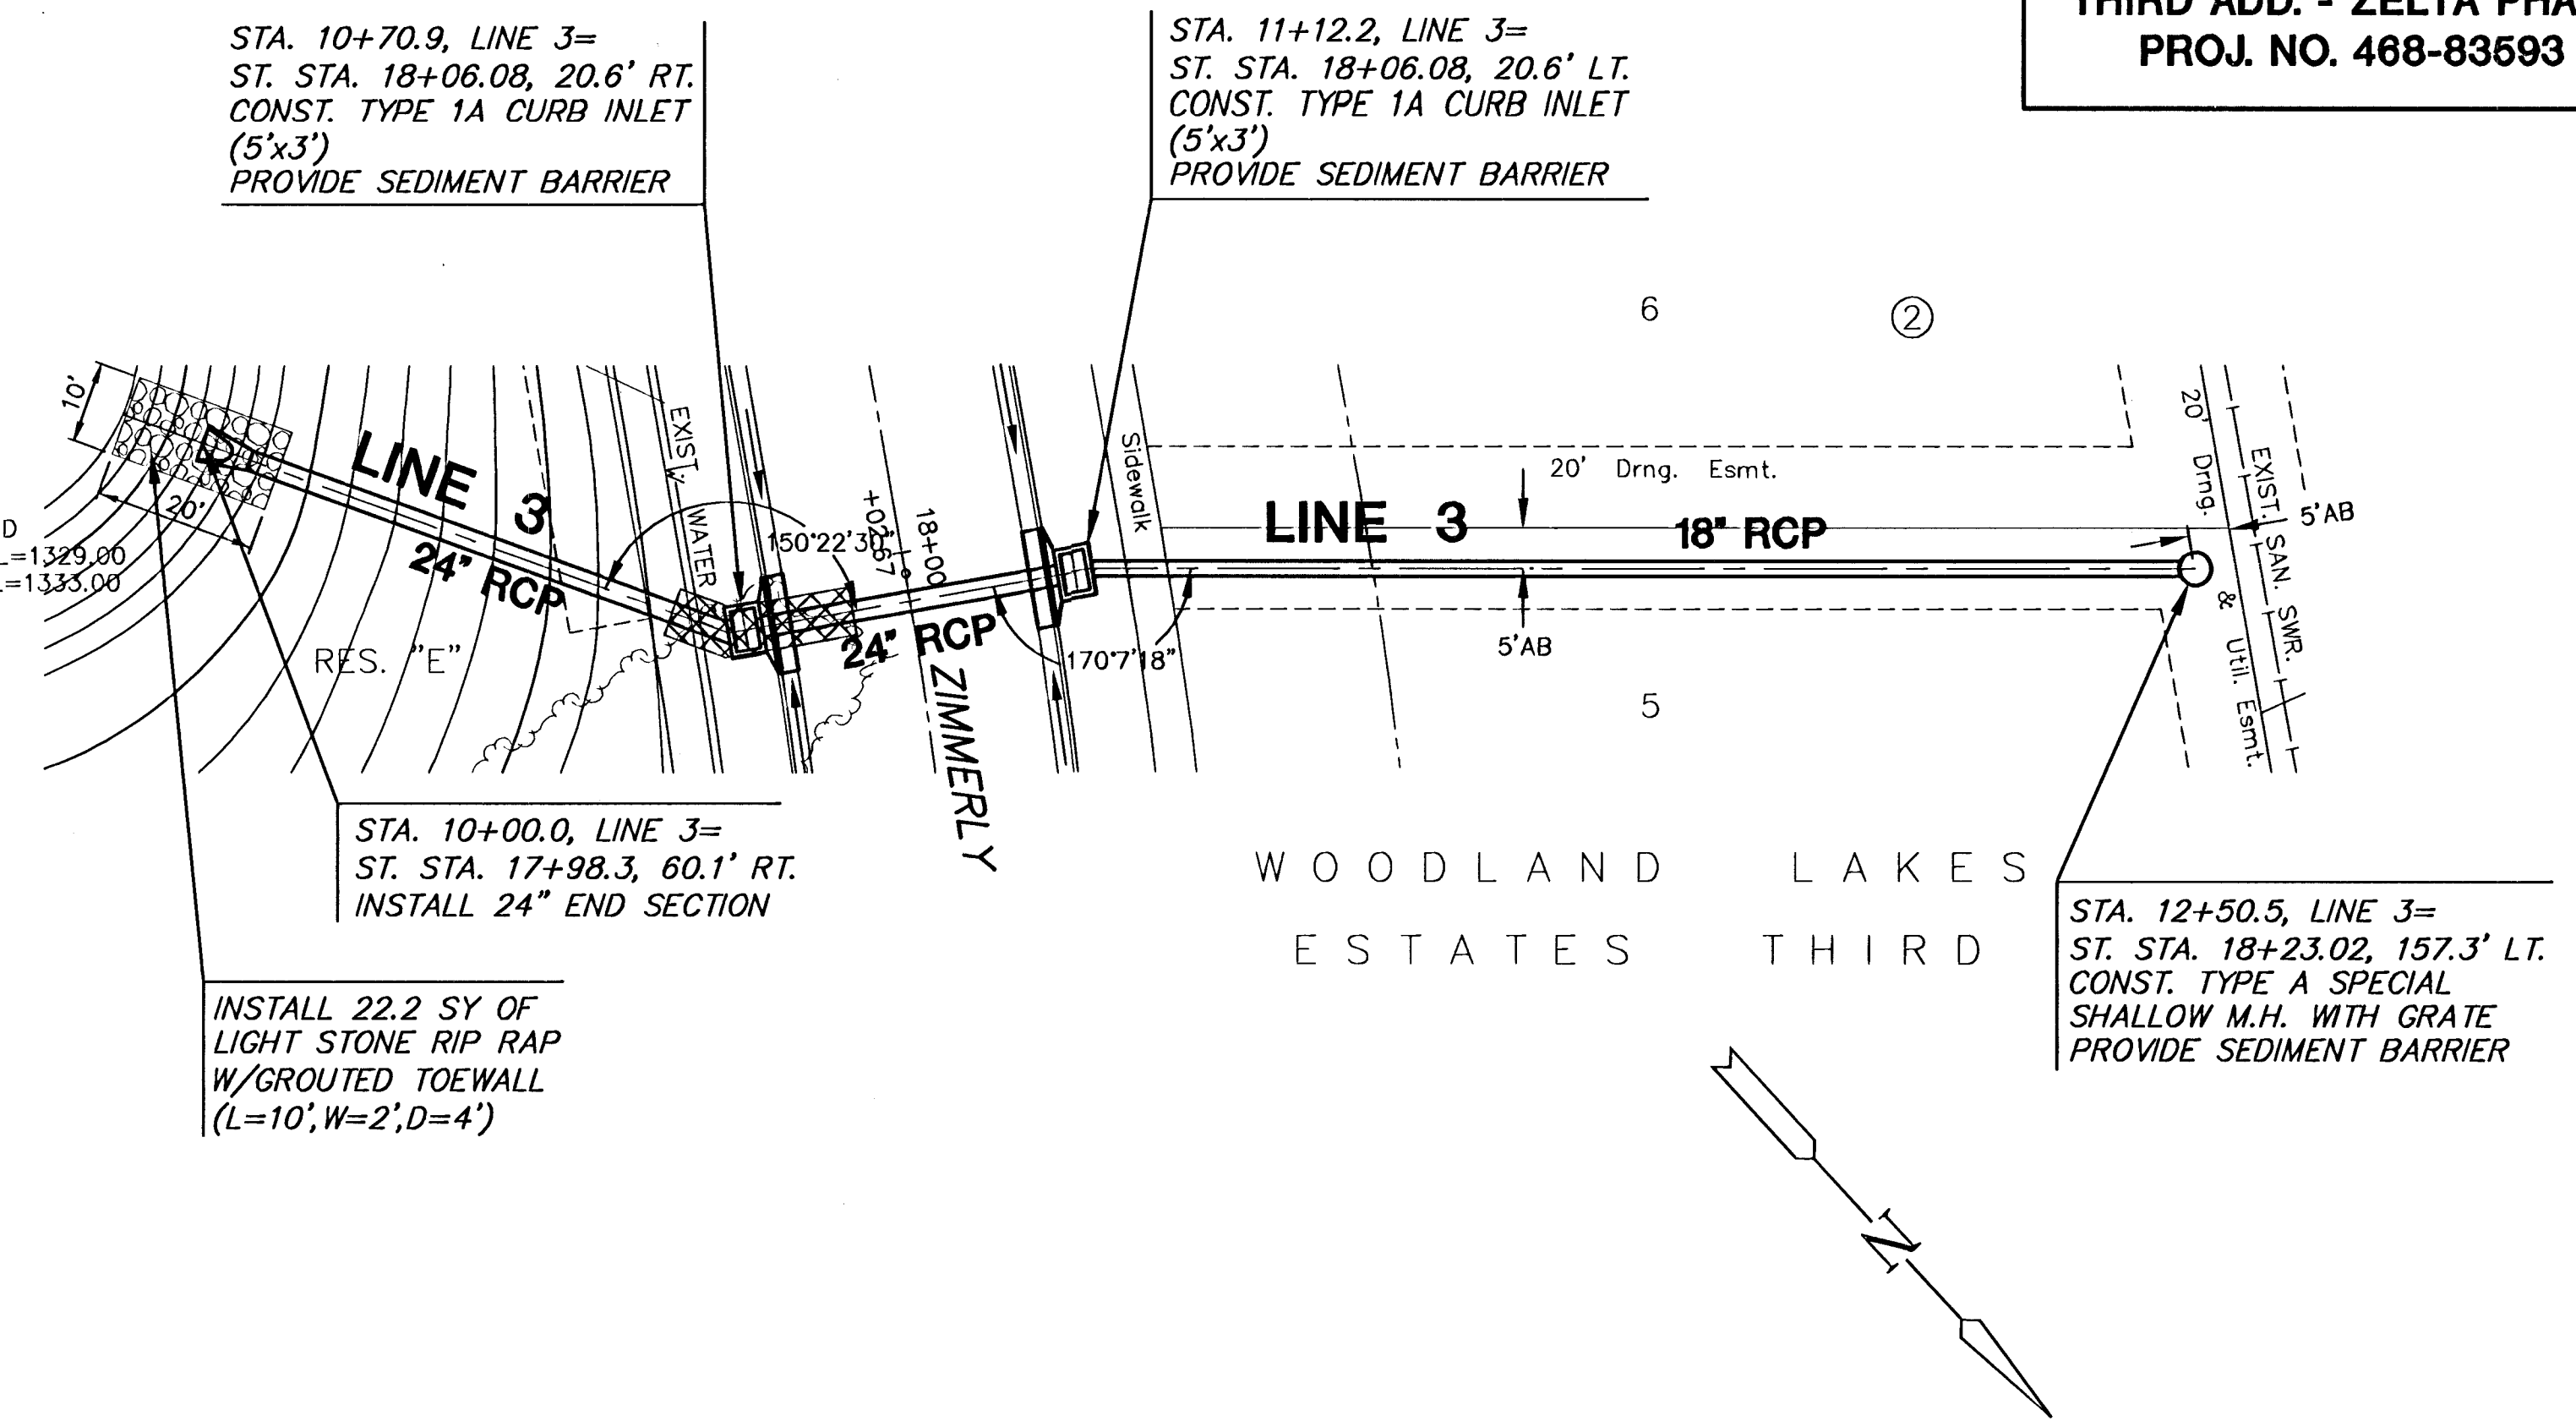

PLAN LINE 3

AS-BUILT FEBRUARY 2004

