

MH TOP=1334.77
FL IN=1323.30
FL OUT=1323.20


MH TOP=1328.63
FL IN=1318.28
FL OUT=1318.18

MH TOP=13XX.XX
FL IN=
FL OUT=

Install 55.5 S.Y. of North American
Green C-350 Erosion Mat (or
Approved Equal) (Install per
Manufacturer's Recommendations)

NORMAL POOL=1329.00
100 YR=1332.00

LEGEND

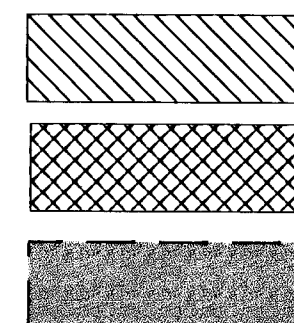

=LIMIT OF TREE REMOVAL

=PROPOSED WETLANDS MITIGATION
(SEE DETAIL ON SHEET 2)

=NORMAL POOL

--- = LIMITS OF GRADING


---1335--- = EXIST. CONTOUR

---1335--- = PROP. CONTOUR

---1335--- = AS-BUILT CONTOUR


---1335--- = AS-BUILT SPOT ELV.

PLAN VIEW

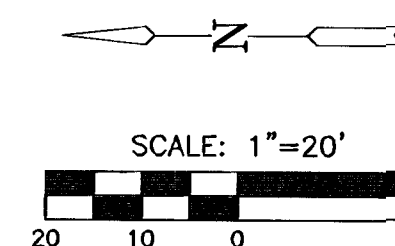

H:\CIVIL\95058\02172\DWG\SWS\Zelta\As-built\02172_DP.DWG

AS-BUILT FEBRUARY 2004

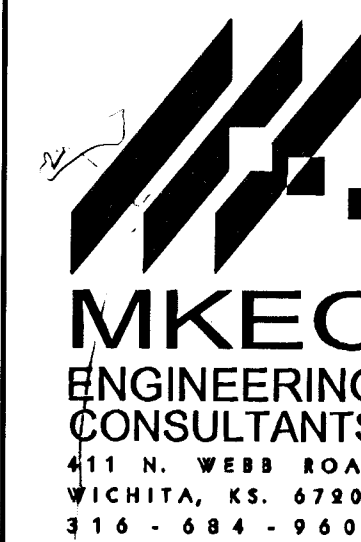

WOODLAND LAKES ESTATES
THIRD ADDITION - ZELTA PHASE
PROJECT NAME

POND GRADING
SHEET TITLE

BSH DESIGN BY:	JAS/DMU DRAWN BY:	ASH CHECKED BY:
JULY 2003 DATE	02172 JOB NO.	18 / 32 SHEET/OF