



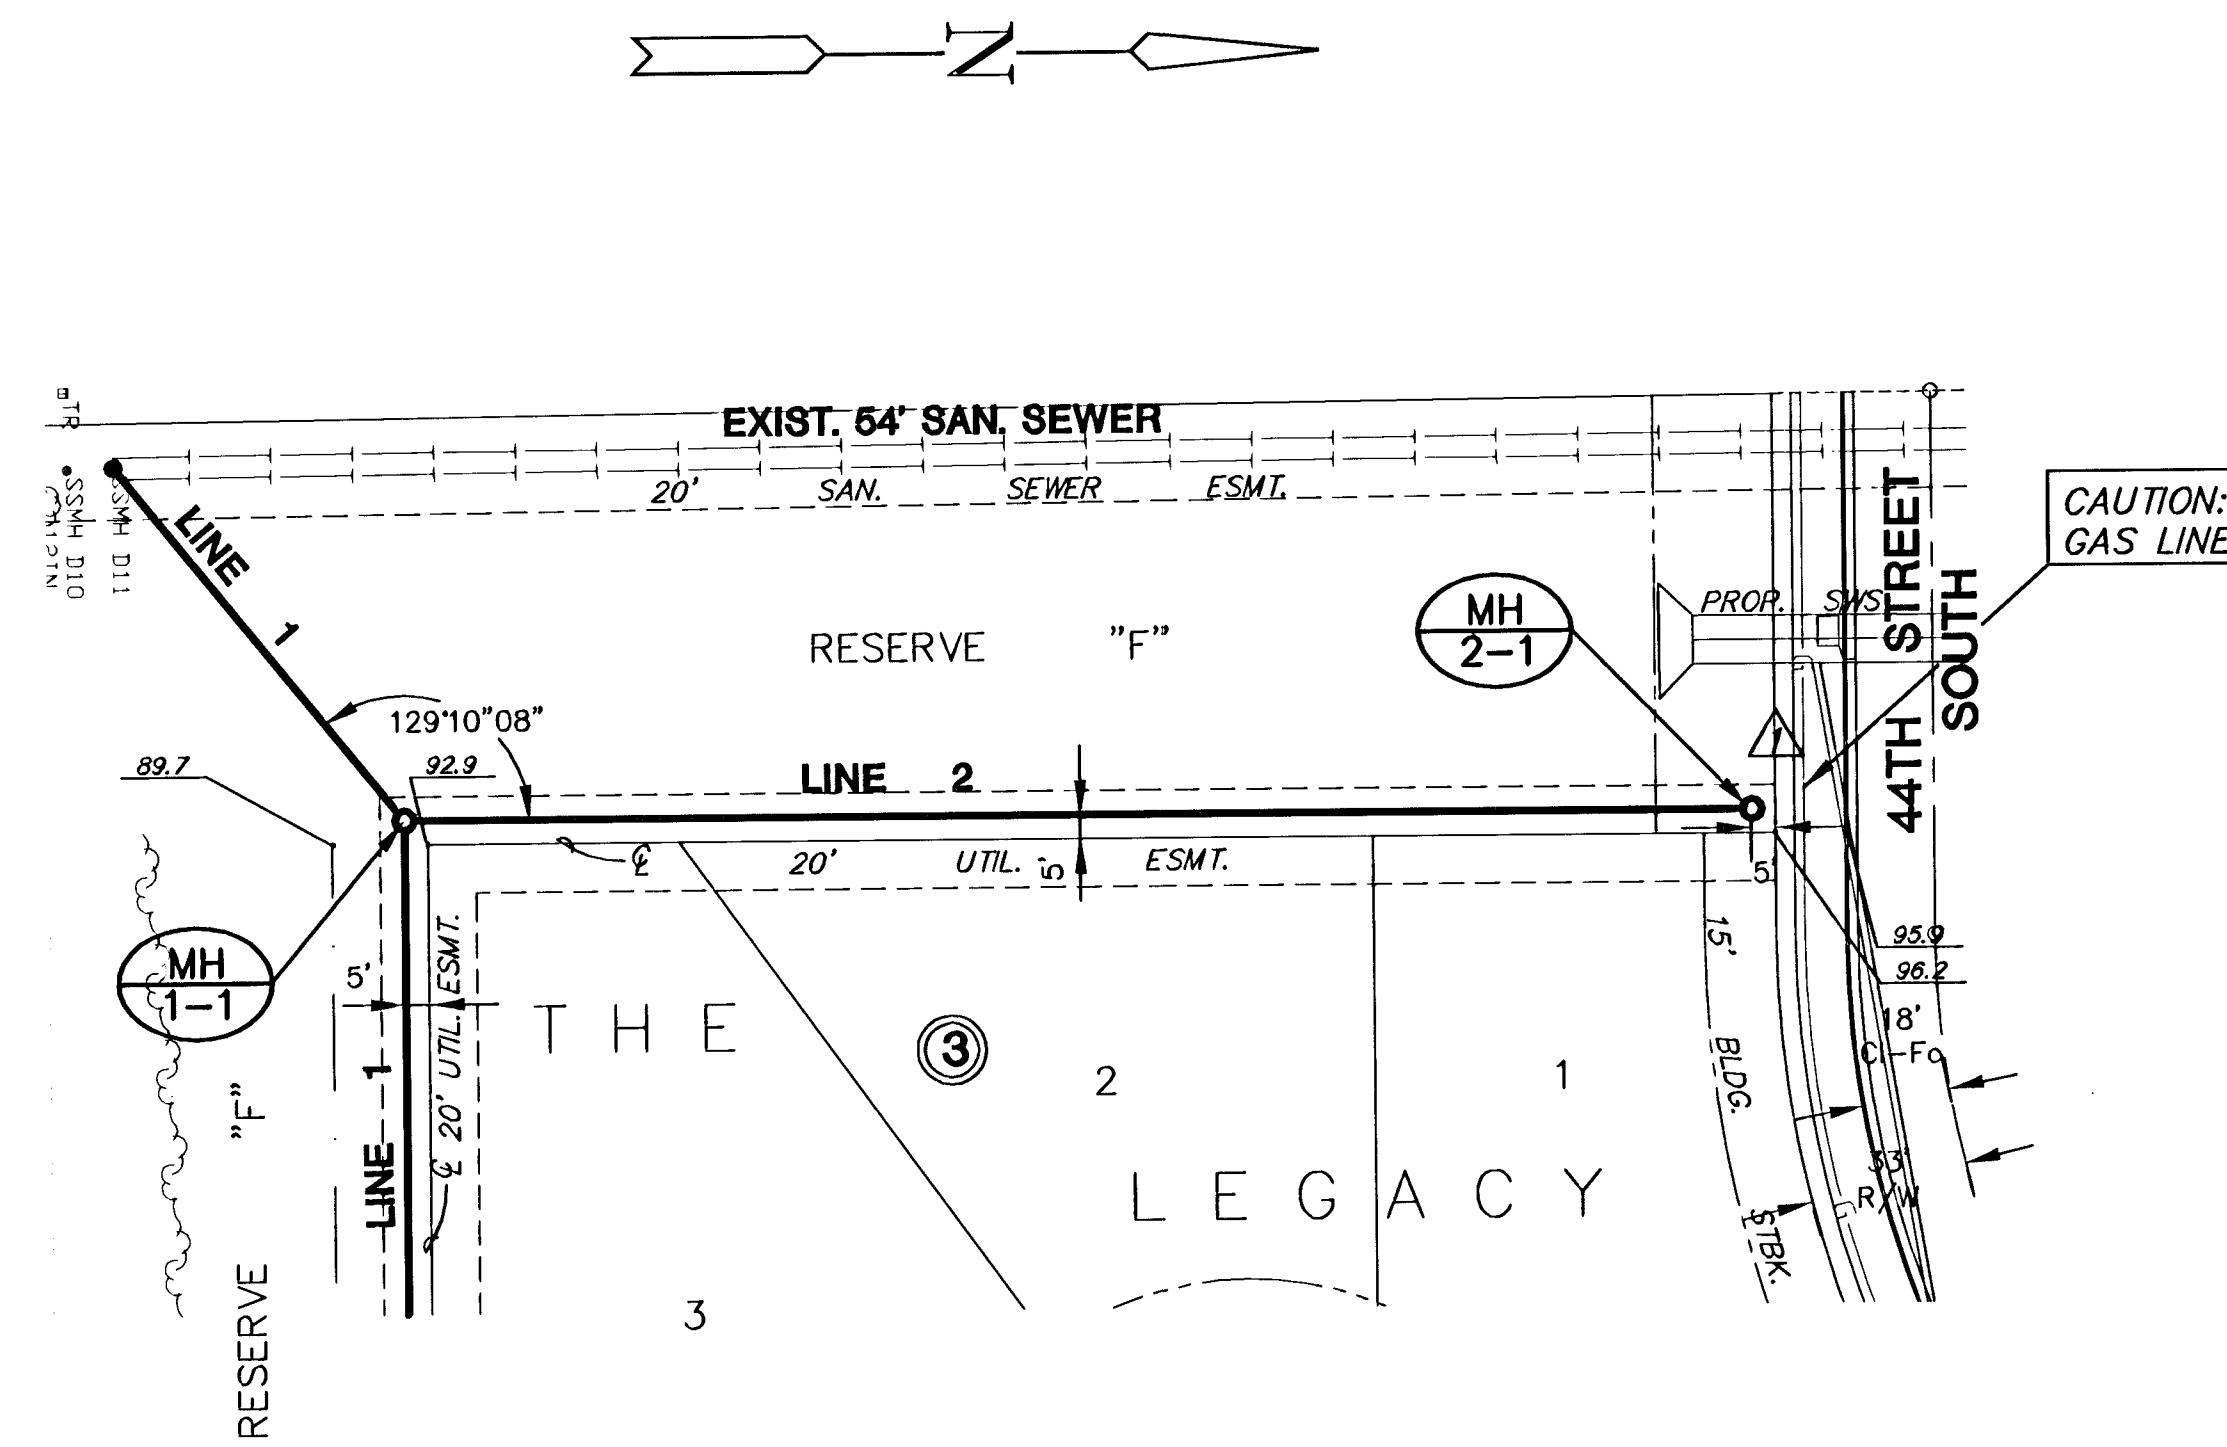


PLAN LINE 2

REVISED: 1-12-04
Due to gas line location

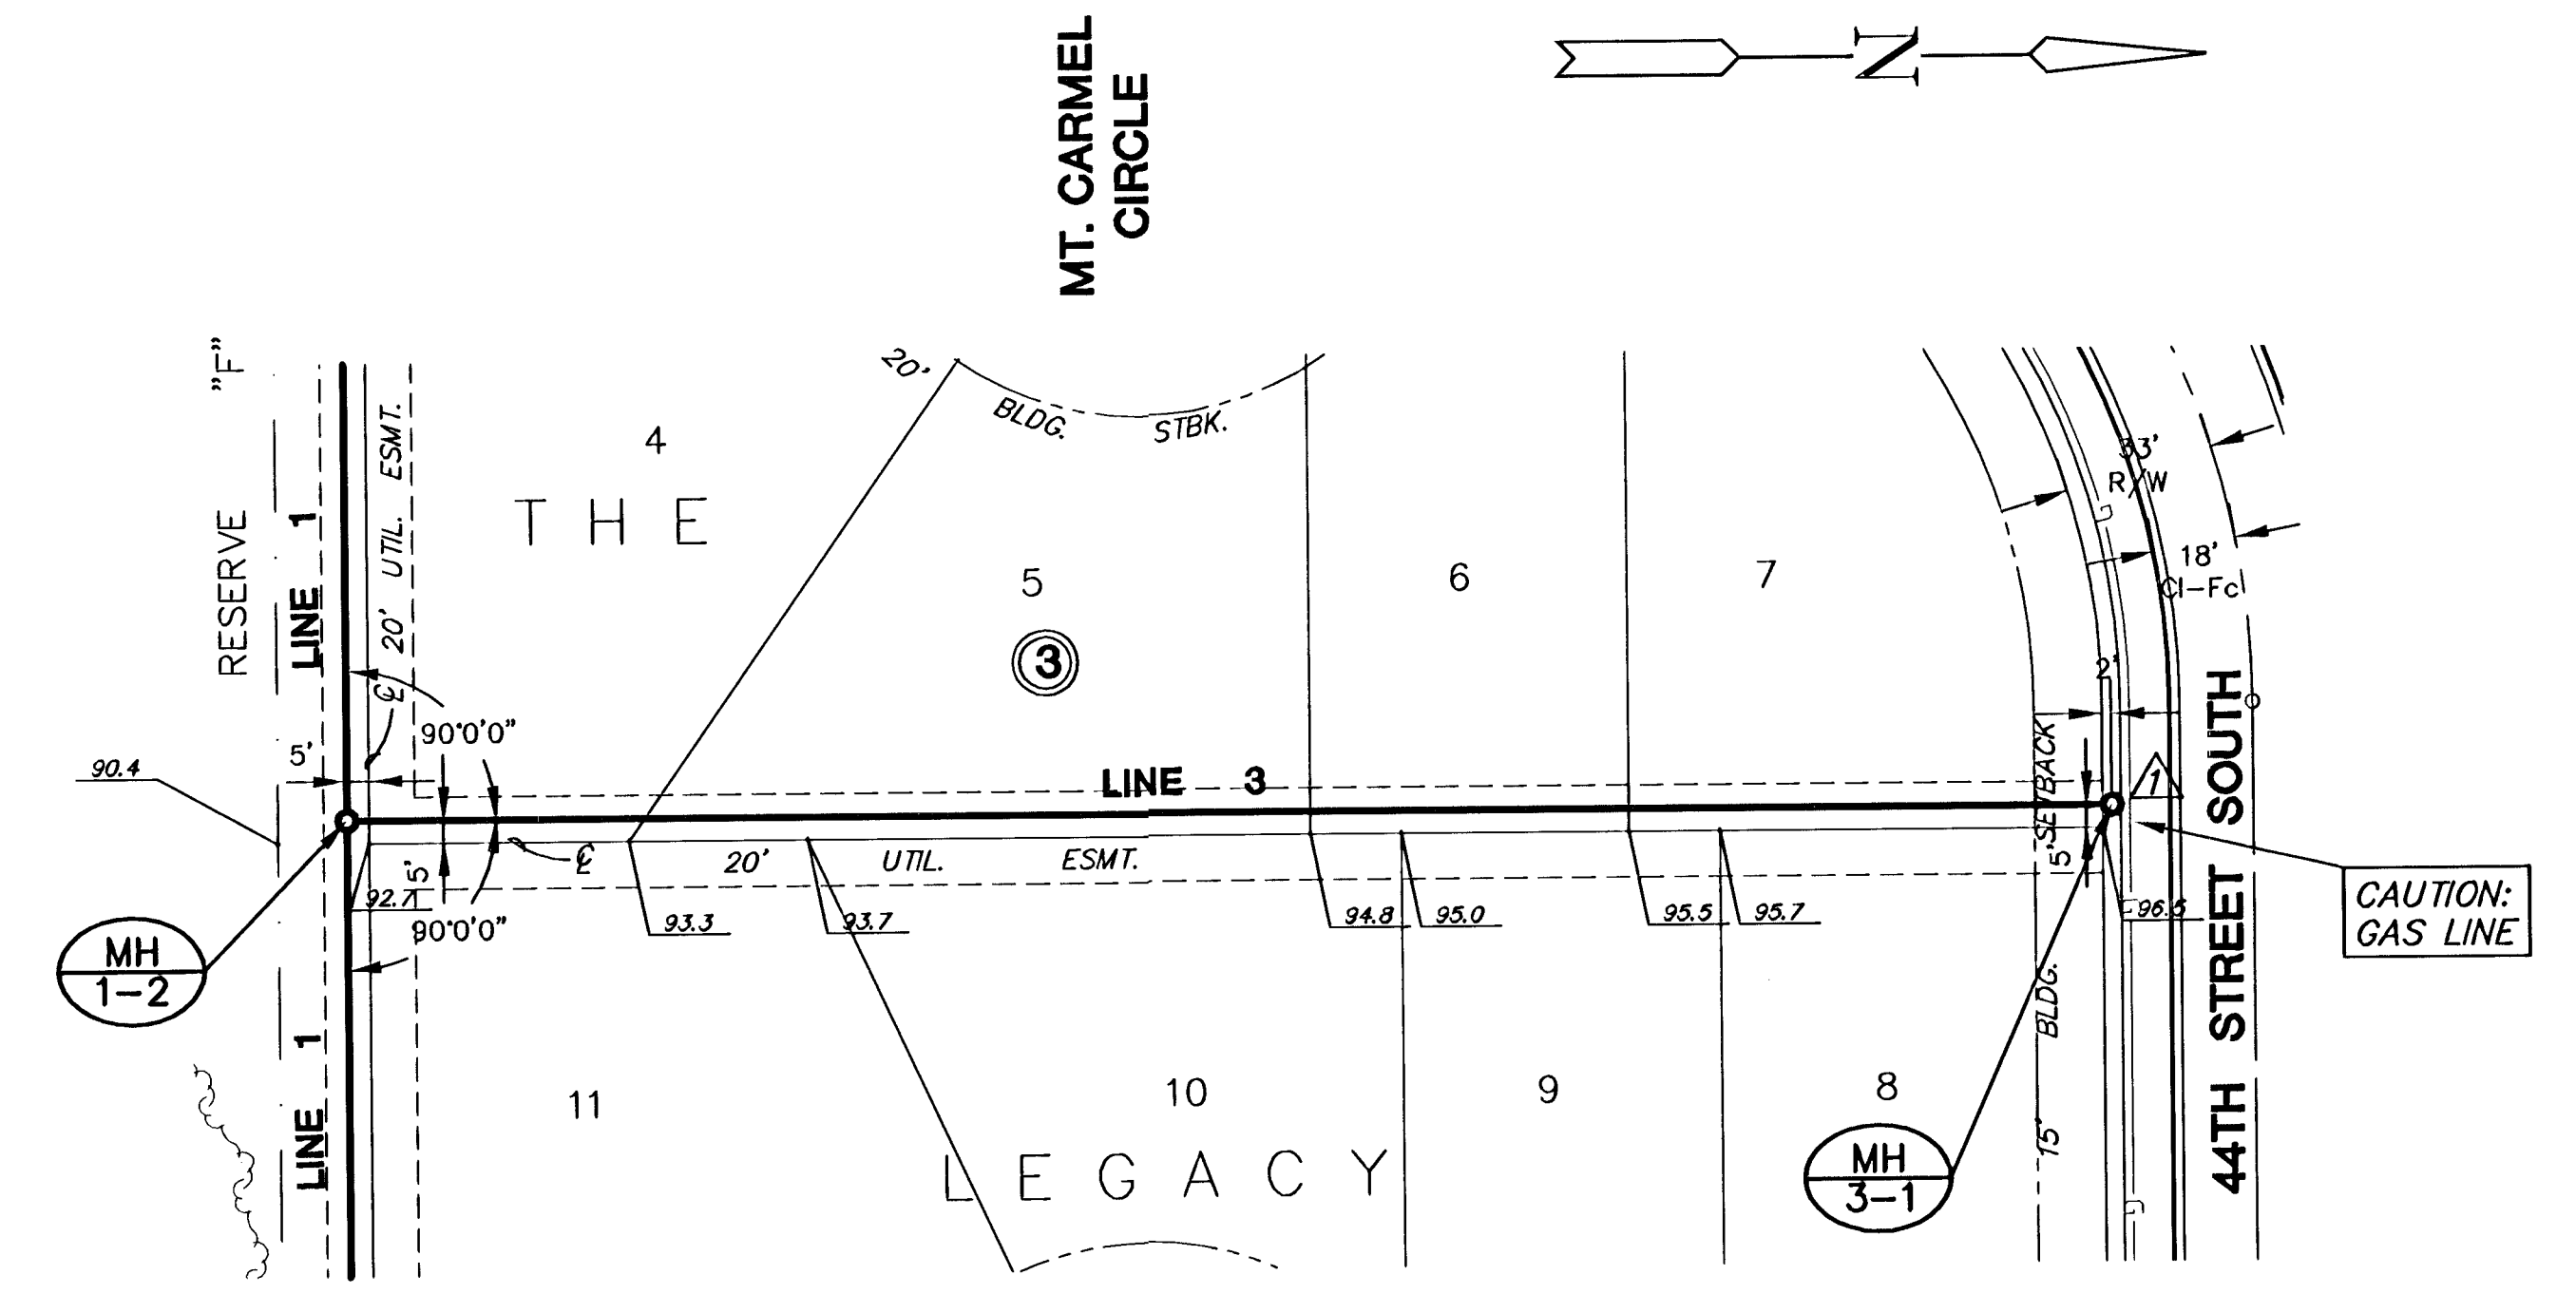

PLAN LINE 3

REVISED: 1-12-04
Due to gas line location

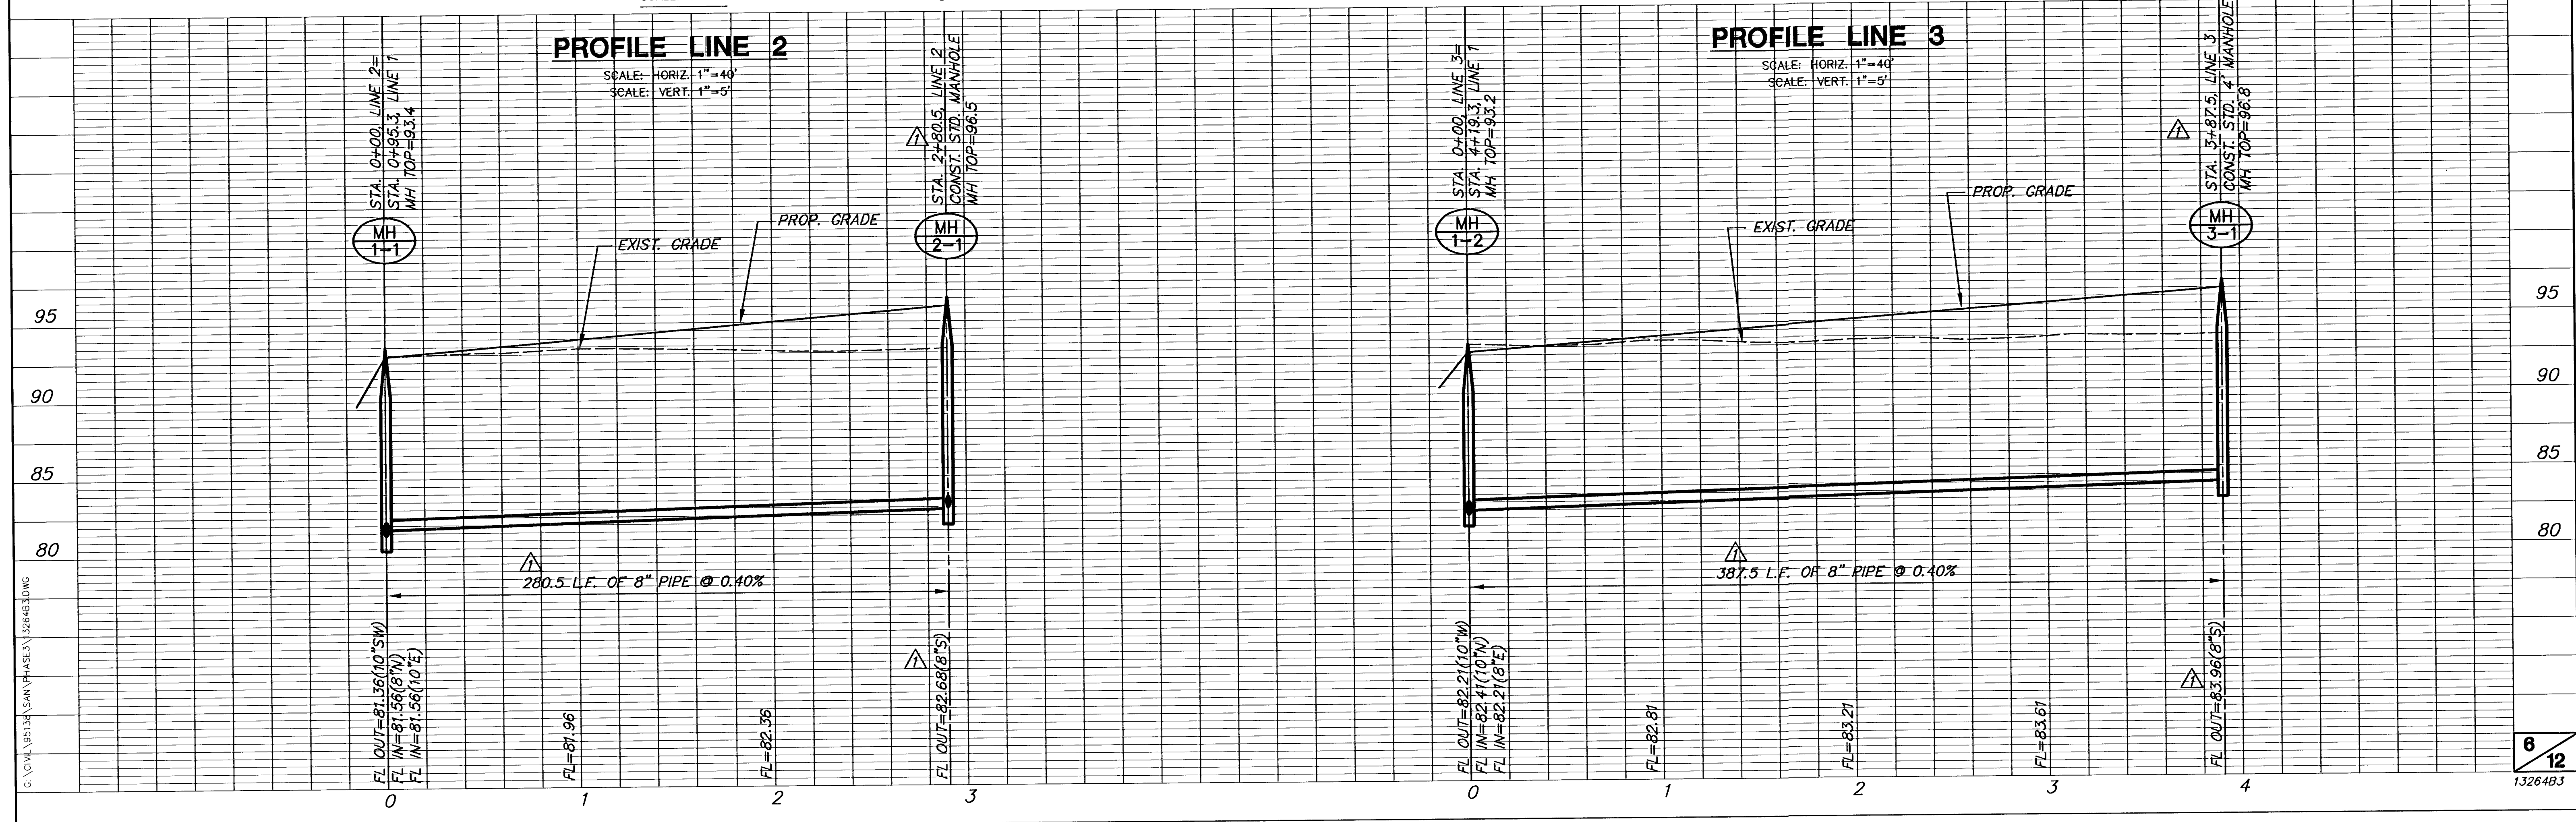

C:\DWG\195138\SAN\PHASE3\1264B3.DWG