


6: APPS\DC\A\1748\base.dwg Mon Apr 05 11:54:48 2004 Bernard Kulla, Poe & Associates Inc.

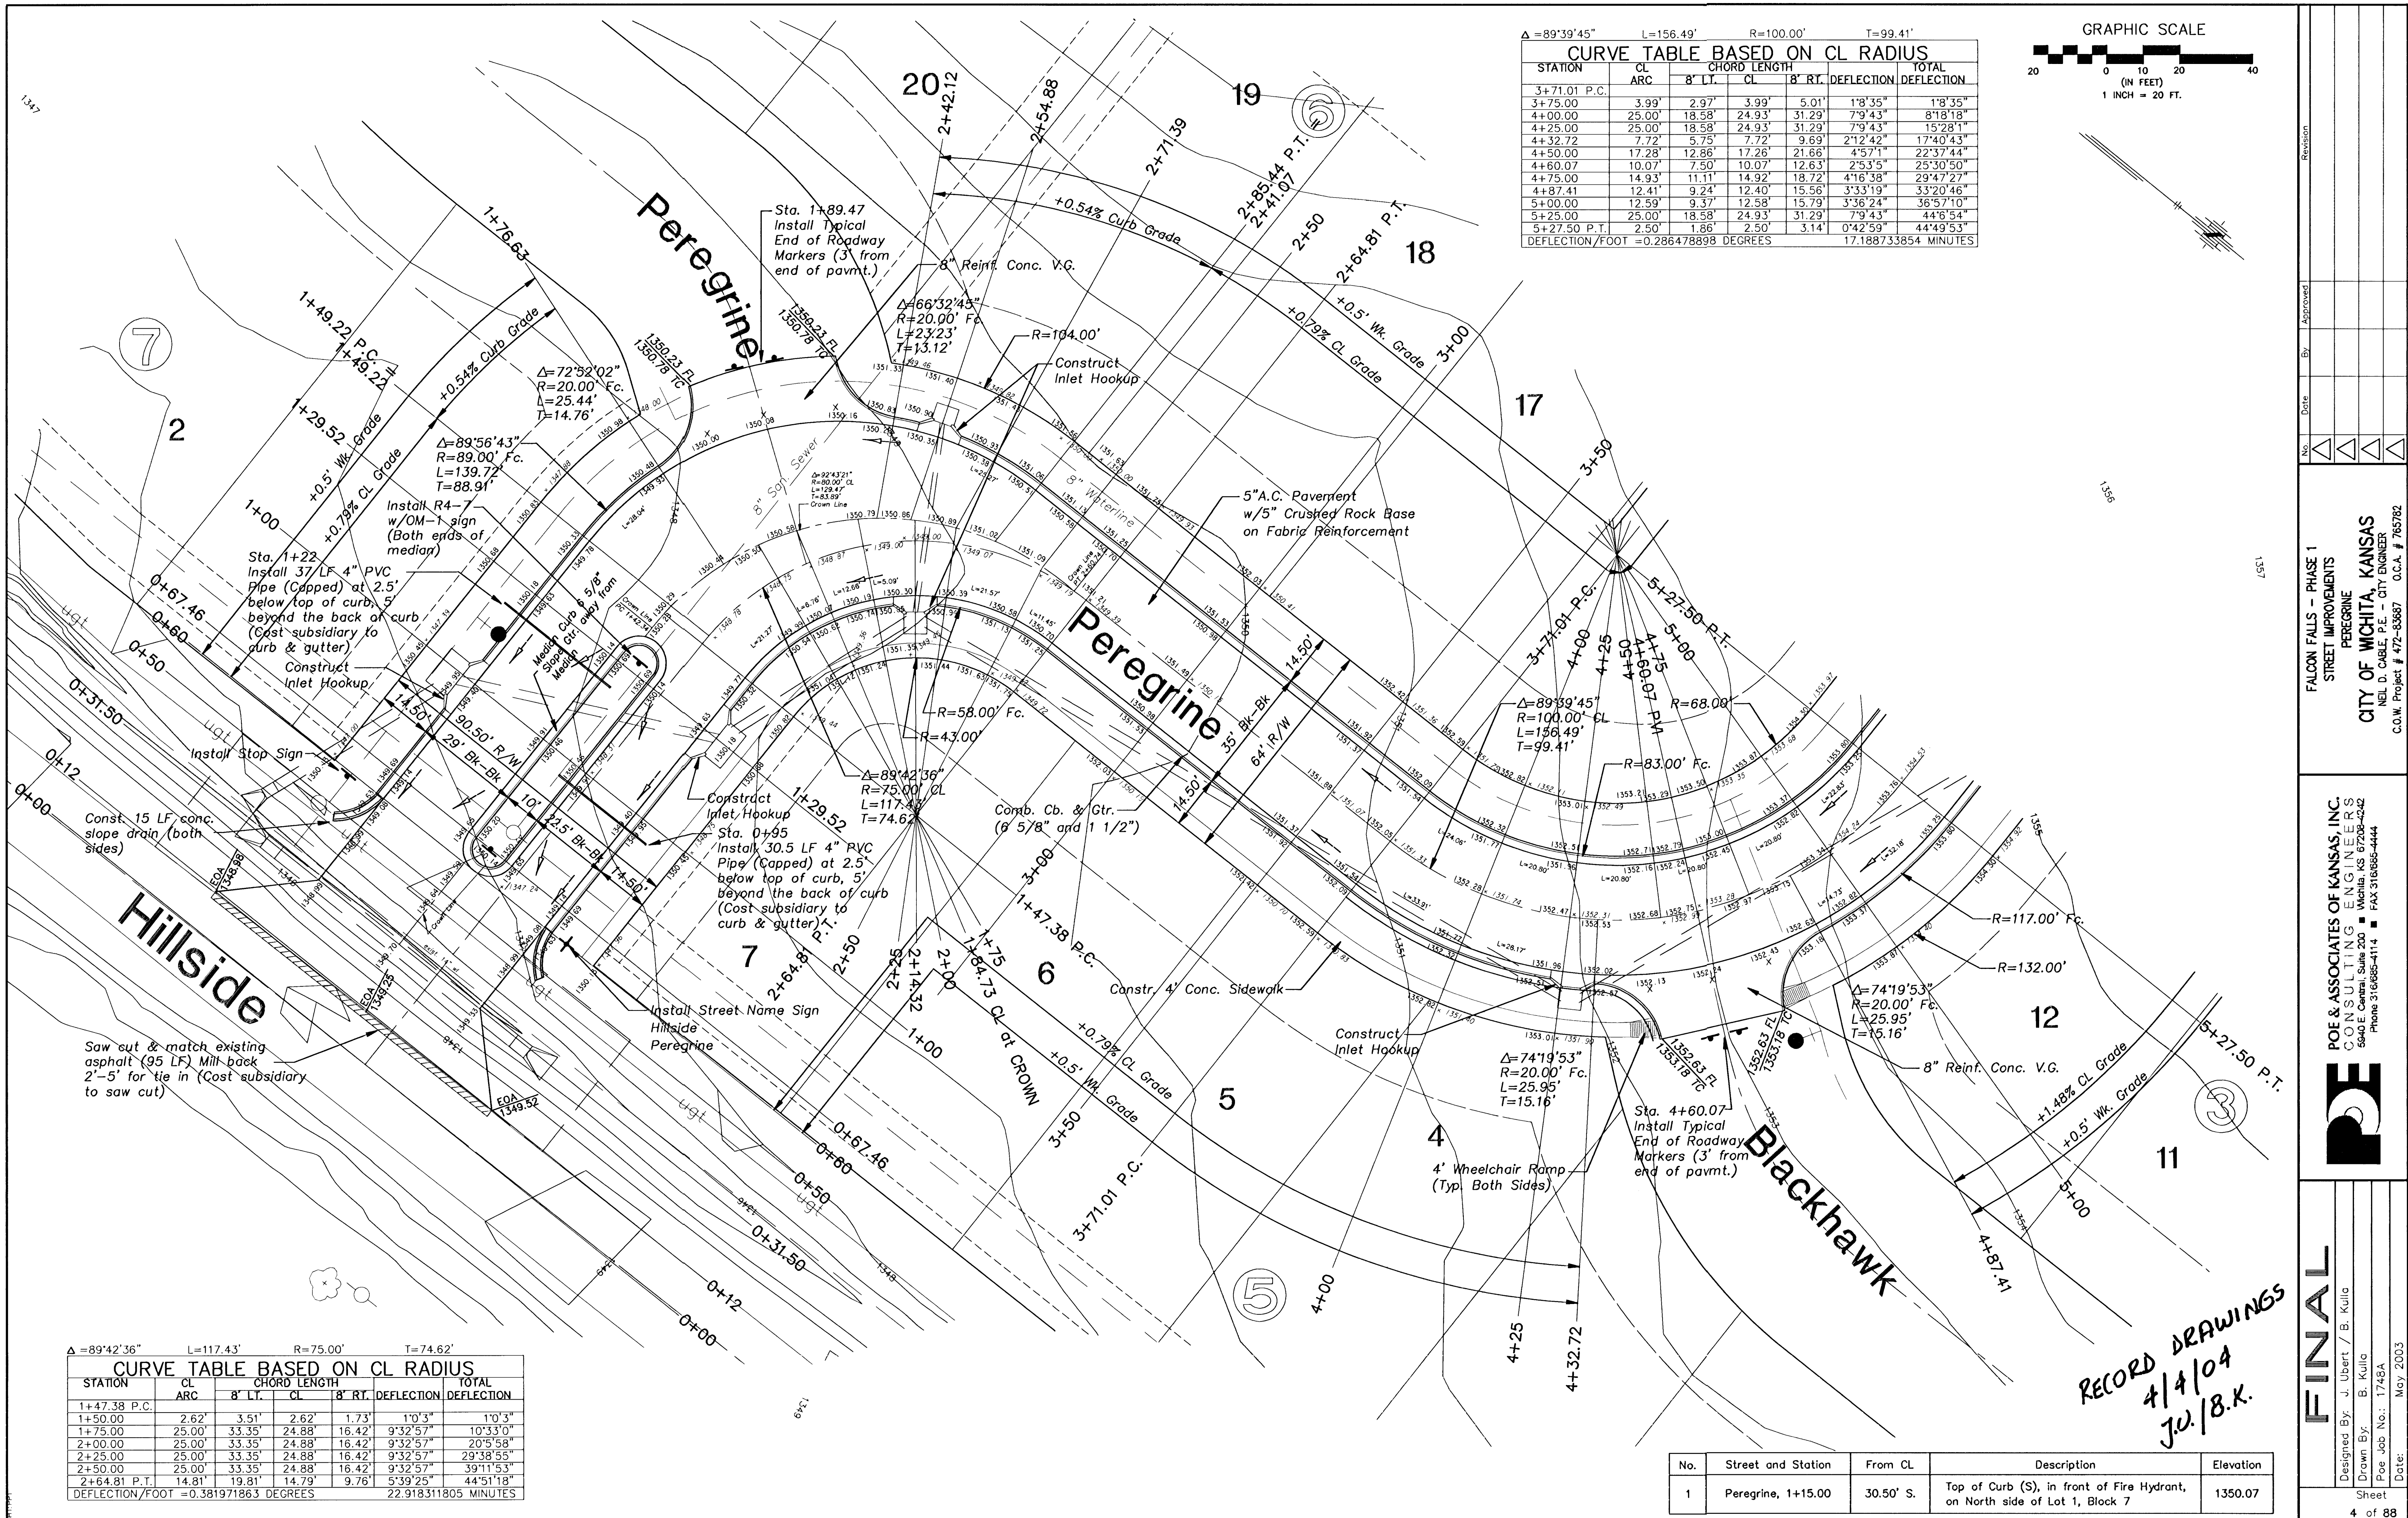

RECORD DRAWINGS
4/4/04
J.W./B.K.

No.	Street and Station	From CL	Description	Elevation
1	Peregrine, 1+15.00	30.50' S.	Top of Curb (S), in front of Fire Hydrant, on North side of Lot 1, Block 7	1350.07

FINAL

Designed By: J. Ubert / B. Kulla
Drawn By: B. Kulla
Poe Job No.: 1748A
Date: May 2003

POE & ASSOCIATES OF KANSAS, INC.
CONSULTING ENGINEERS
6040 E. Central Expressway, Suite 200
Wichita, KS 67208-4242
Phone 316/685-4114 • FAX 316/685-4444

POE & ASSOCIATES OF KANSAS, INC.
CONSULTING ENGINEERS
6040 E. Central Expressway, Suite 200
Wichita, KS 67208-4242
Phone 316/685-4114 • FAX 316/685-4444

FALCON FALLS - PHASE 1
STREET IMPROVEMENTS
PEREGRINE
CITY OF WICHITA, KANSAS
NEIL D. CABLE, P.E. - CITY ENGINEER
C.O.W. Project # 472-83687 O.C.A. # 765782

No. 1
Date
By
Approved

