

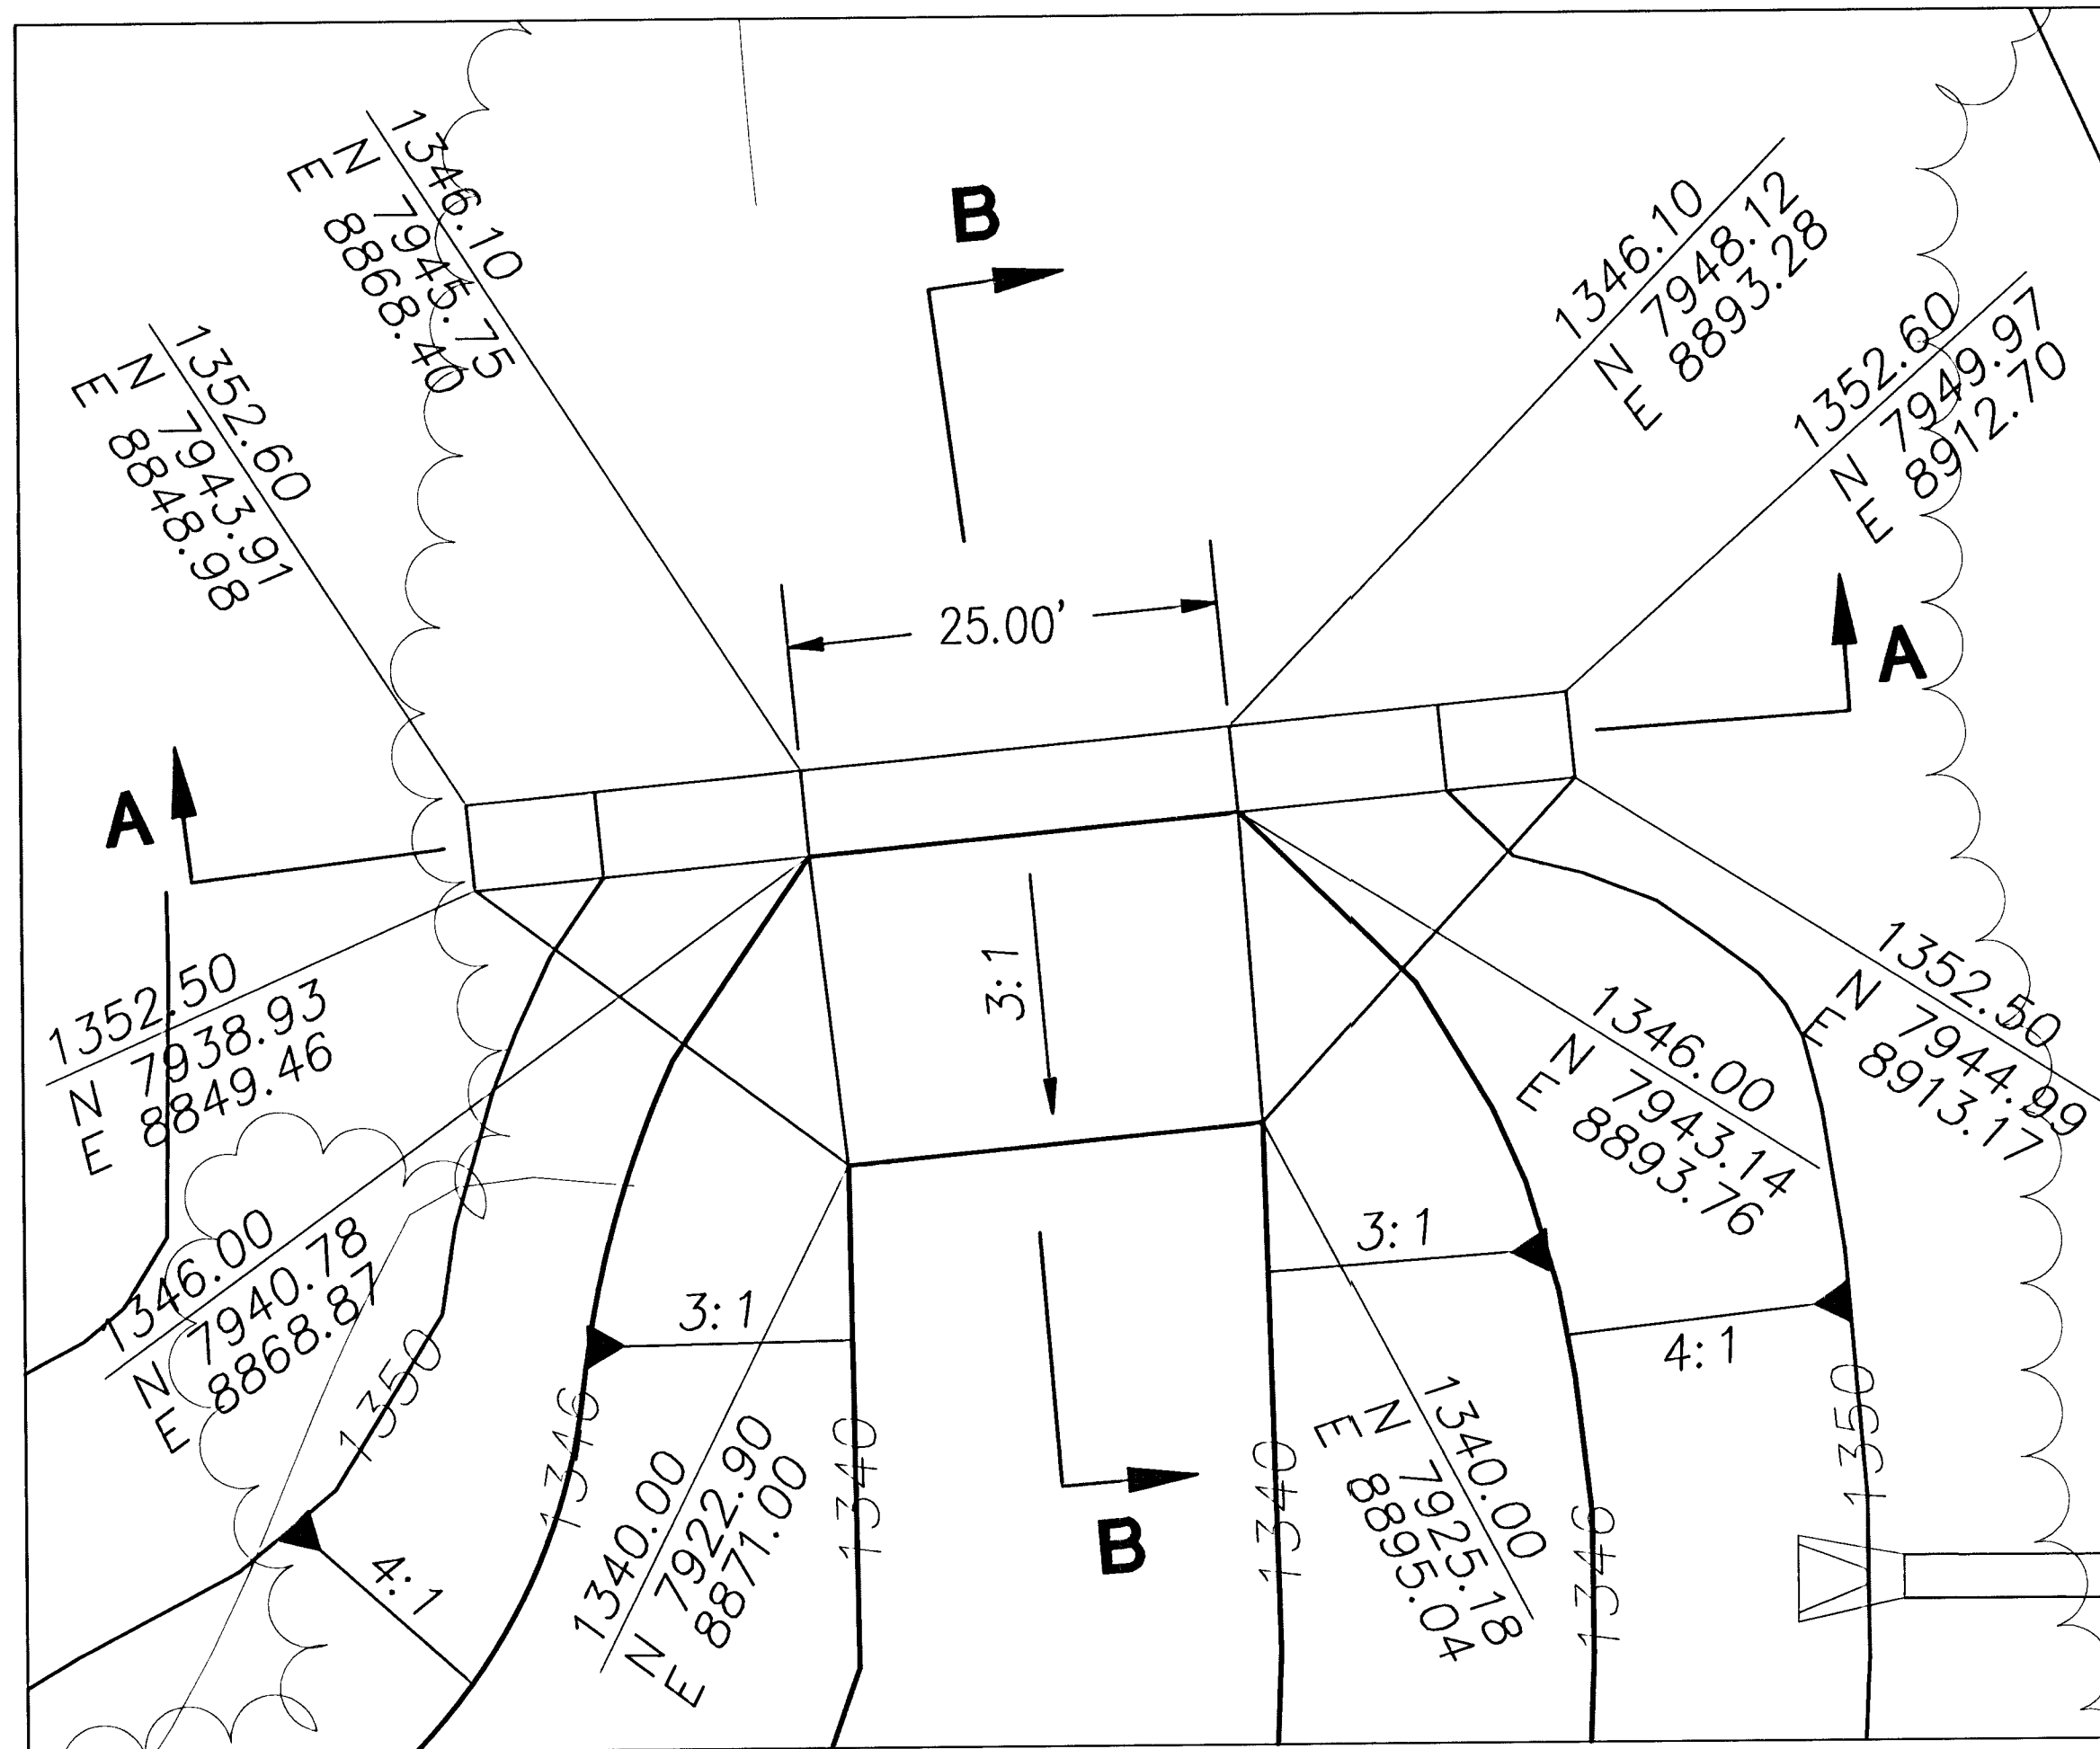


**Moved Drainage Structure
20 feet south and 10 feet west
to save trees
RECORD DRAWINGS
APRIL 12, 2004 by J.U./B.K.**

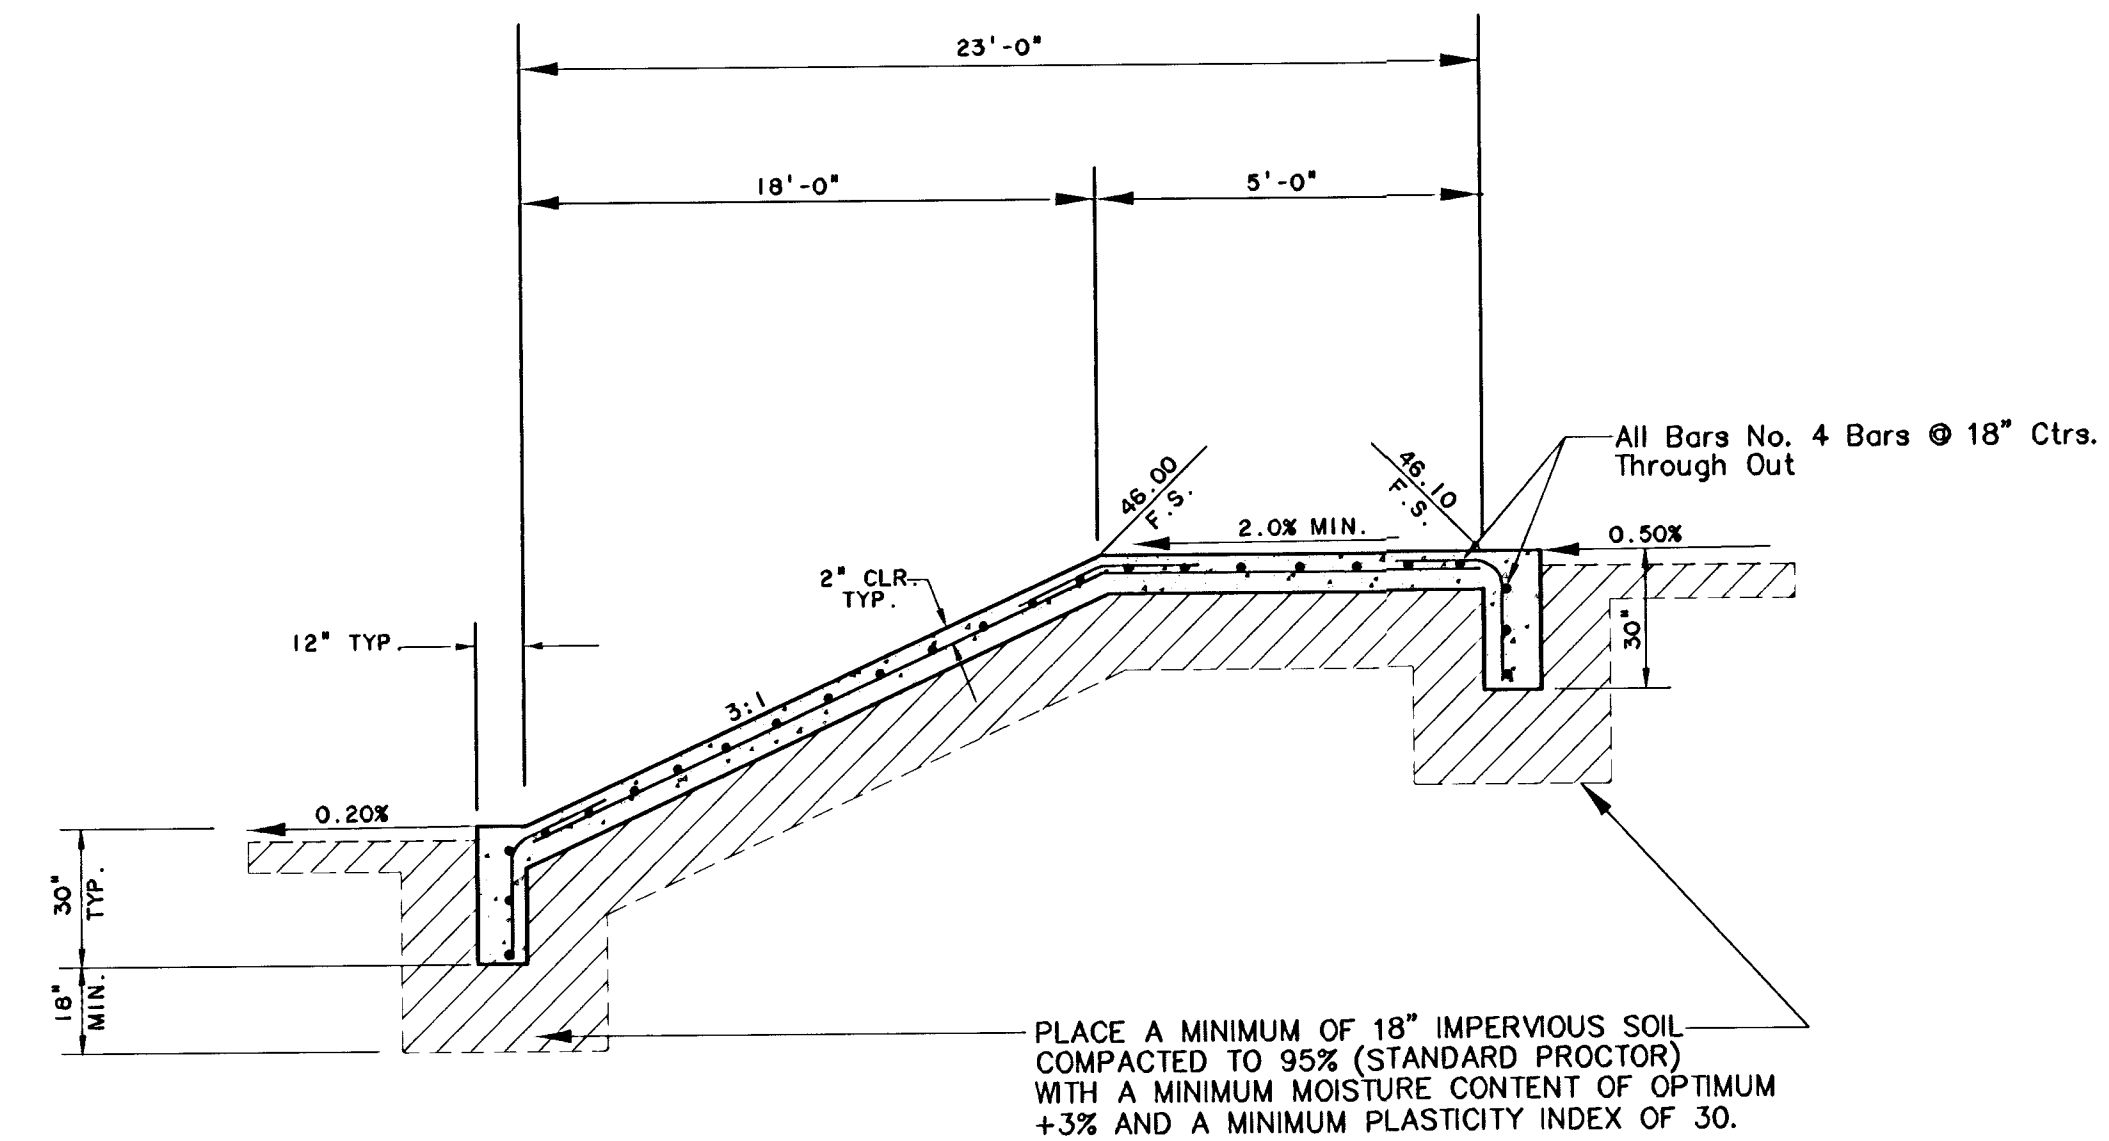

SCALE 1"=10'

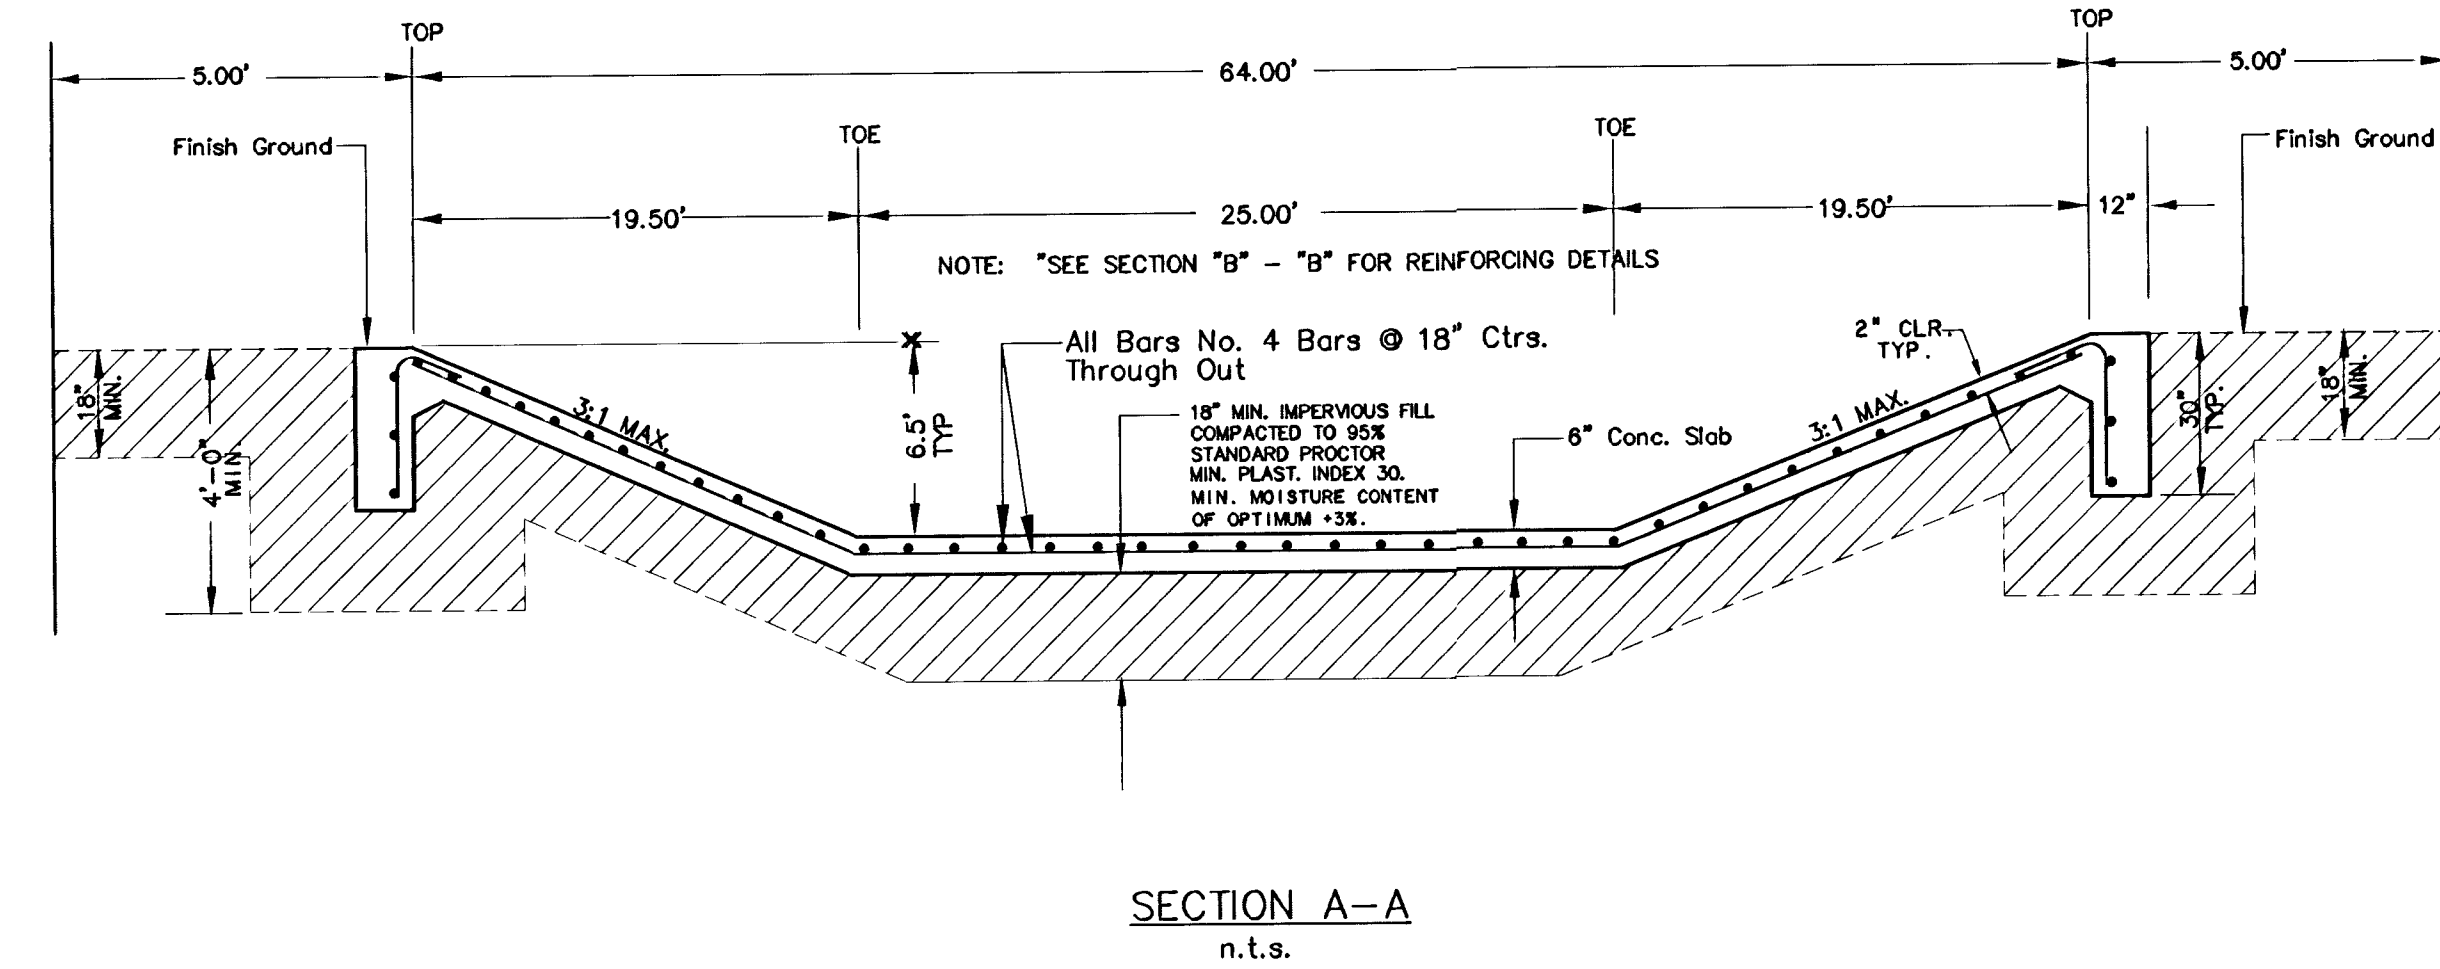

SECTION B-B
n.t.s.

- NOTE:
1. All Concrete to be 6 sack City Paving Mix.
 2. All Exposed Concrete Edges To Have 3/4" - 45° Chamfer.
 3. All Exposed Concrete Surfaces To Be Hand Rubbed.
 4. All steel bars to be #4 bars @ 18" ctrs unless noted otherwise.
 5. All reinforcing splices shall be with #4 bars and minimum overlap of reinforcing steel shall be 24 inches.