
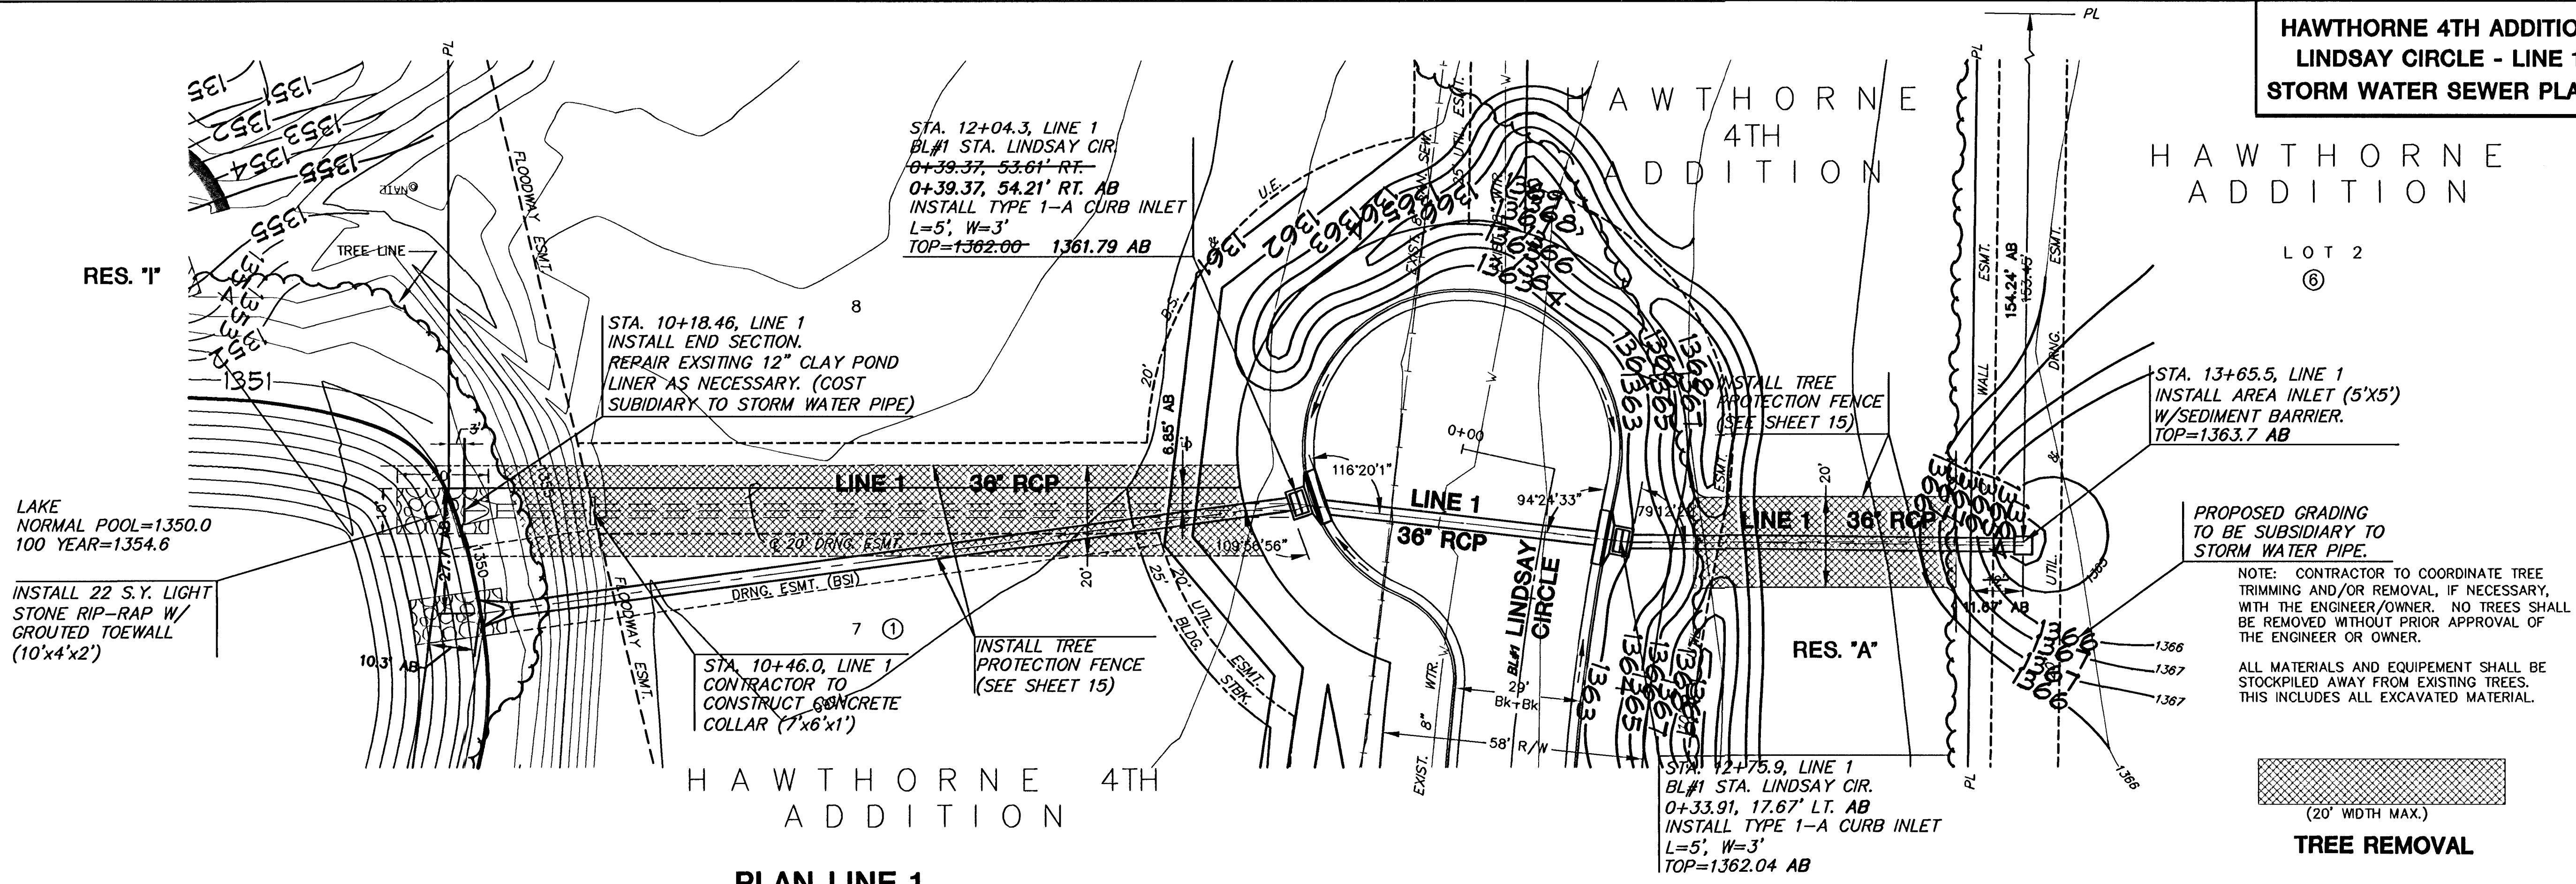


HAWTHORNE 4TH ADDITION
LINDSAY CIRCLE - LINE 1
STORM WATER SEWER PLANS

HAWTHORNE
ADDITION

LOT 2
⑥

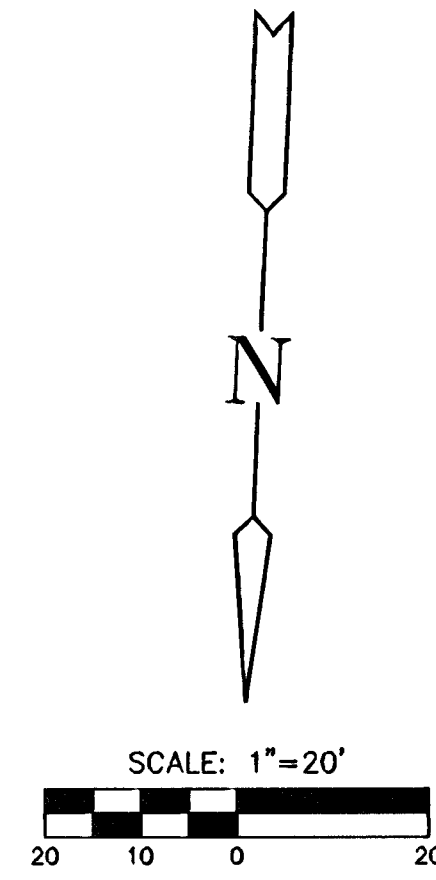


PLAN LINE 1

SCALE: 1"=20'

PROFILE LINE 1

SCALE: HORIZ. 1"=20'
SCALE: VERT. 1"=5'

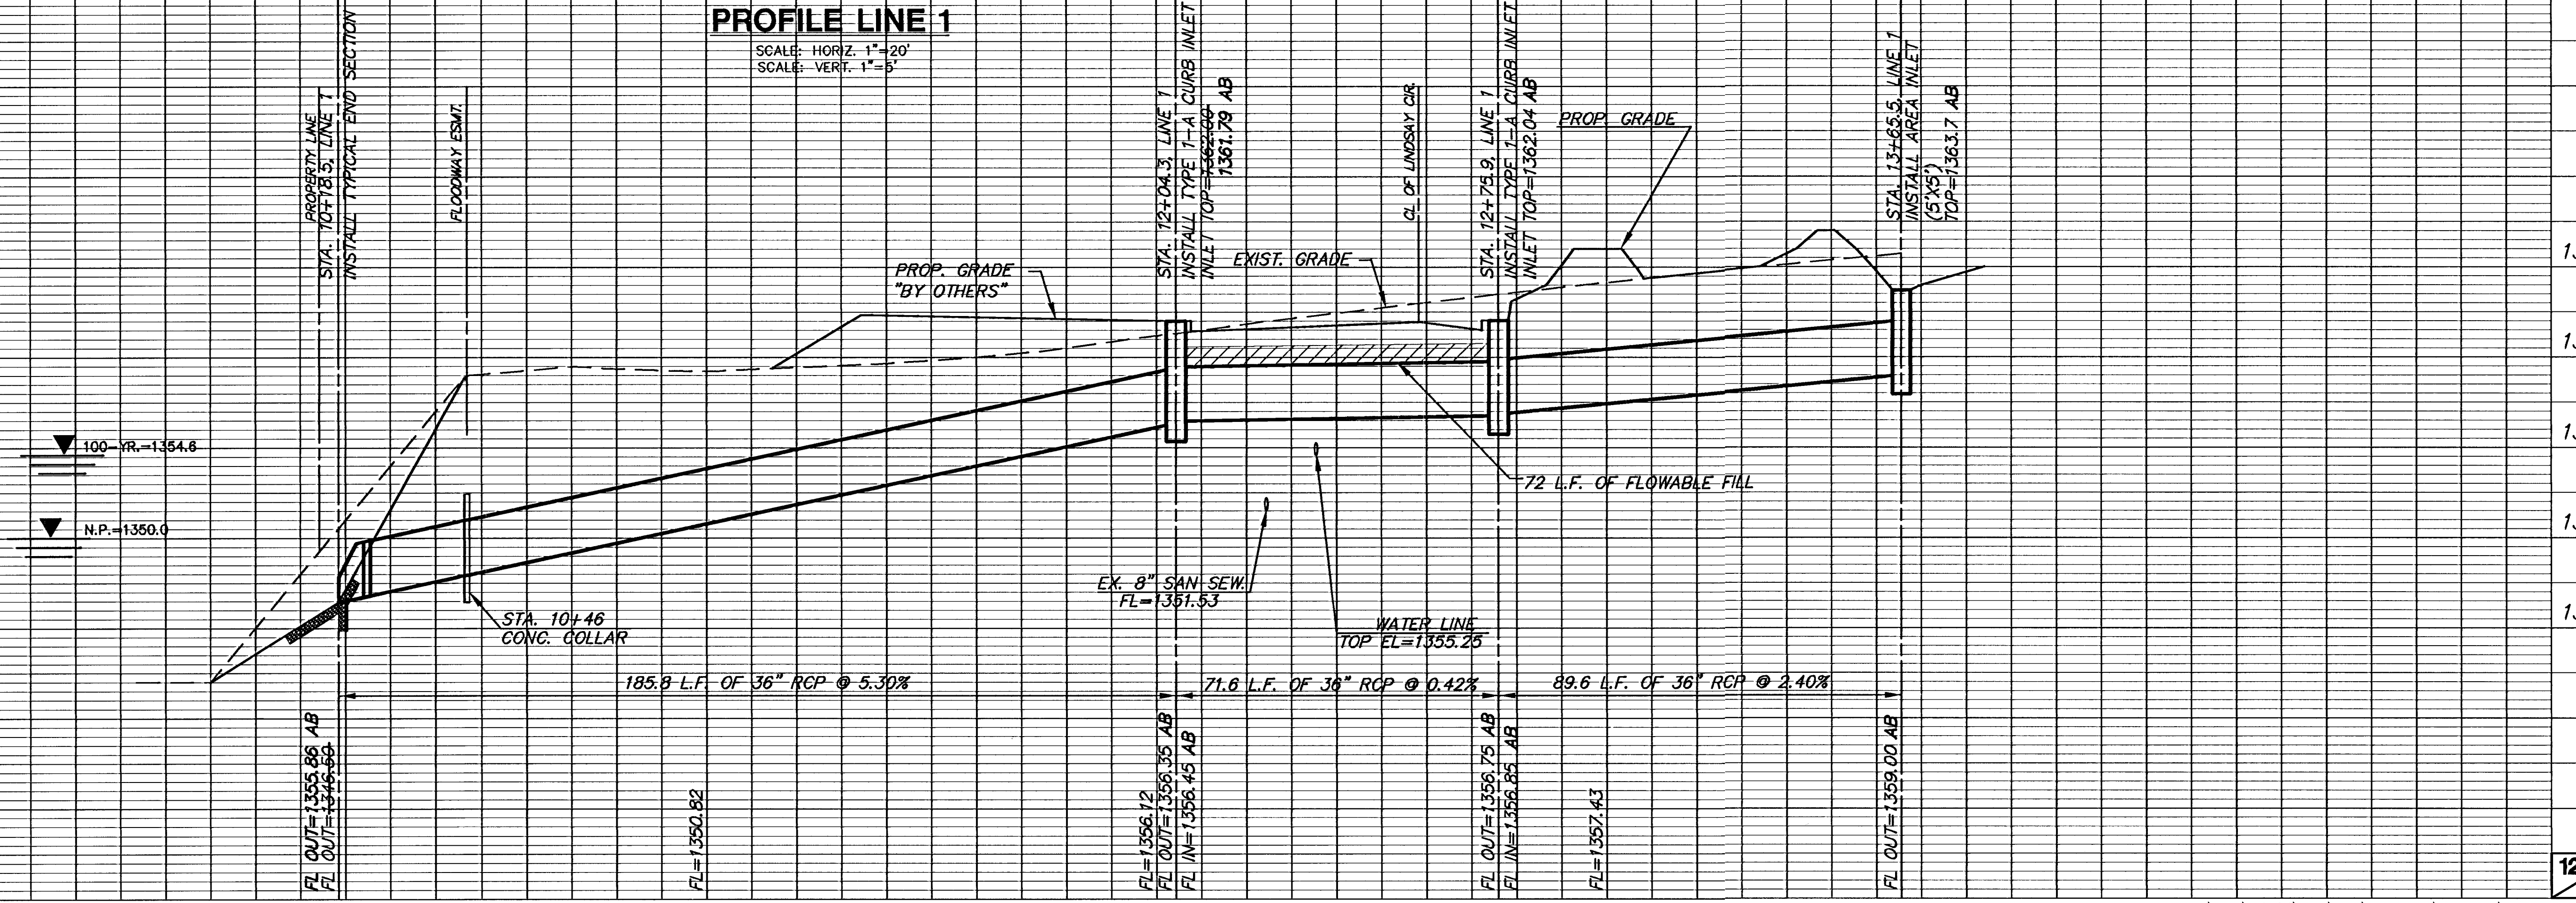

AS-BUILT NOVEMBER 2005

TREE REMOVAL
(20' WIDTH MAX.)

NOTE: CONTRACTOR TO COORDINATE TREE TRIMMING AND/OR REMOVAL, IF NECESSARY, WITH THE ENGINEER/OWNER. NO TREES SHALL BE REMOVED WITHOUT PRIOR APPROVAL OF THE ENGINEER OR OWNER.

ALL MATERIALS AND EQUIPMENT SHALL BE STOCKPILED AWAY FROM EXISTING TREES. THIS INCLUDES ALL EXCAVATED MATERIAL.