



**HAWTHORNE 4TH ADDITION
LINDSAY CIRCLE - LINE 2
STORM WATER SEWER PLANS**

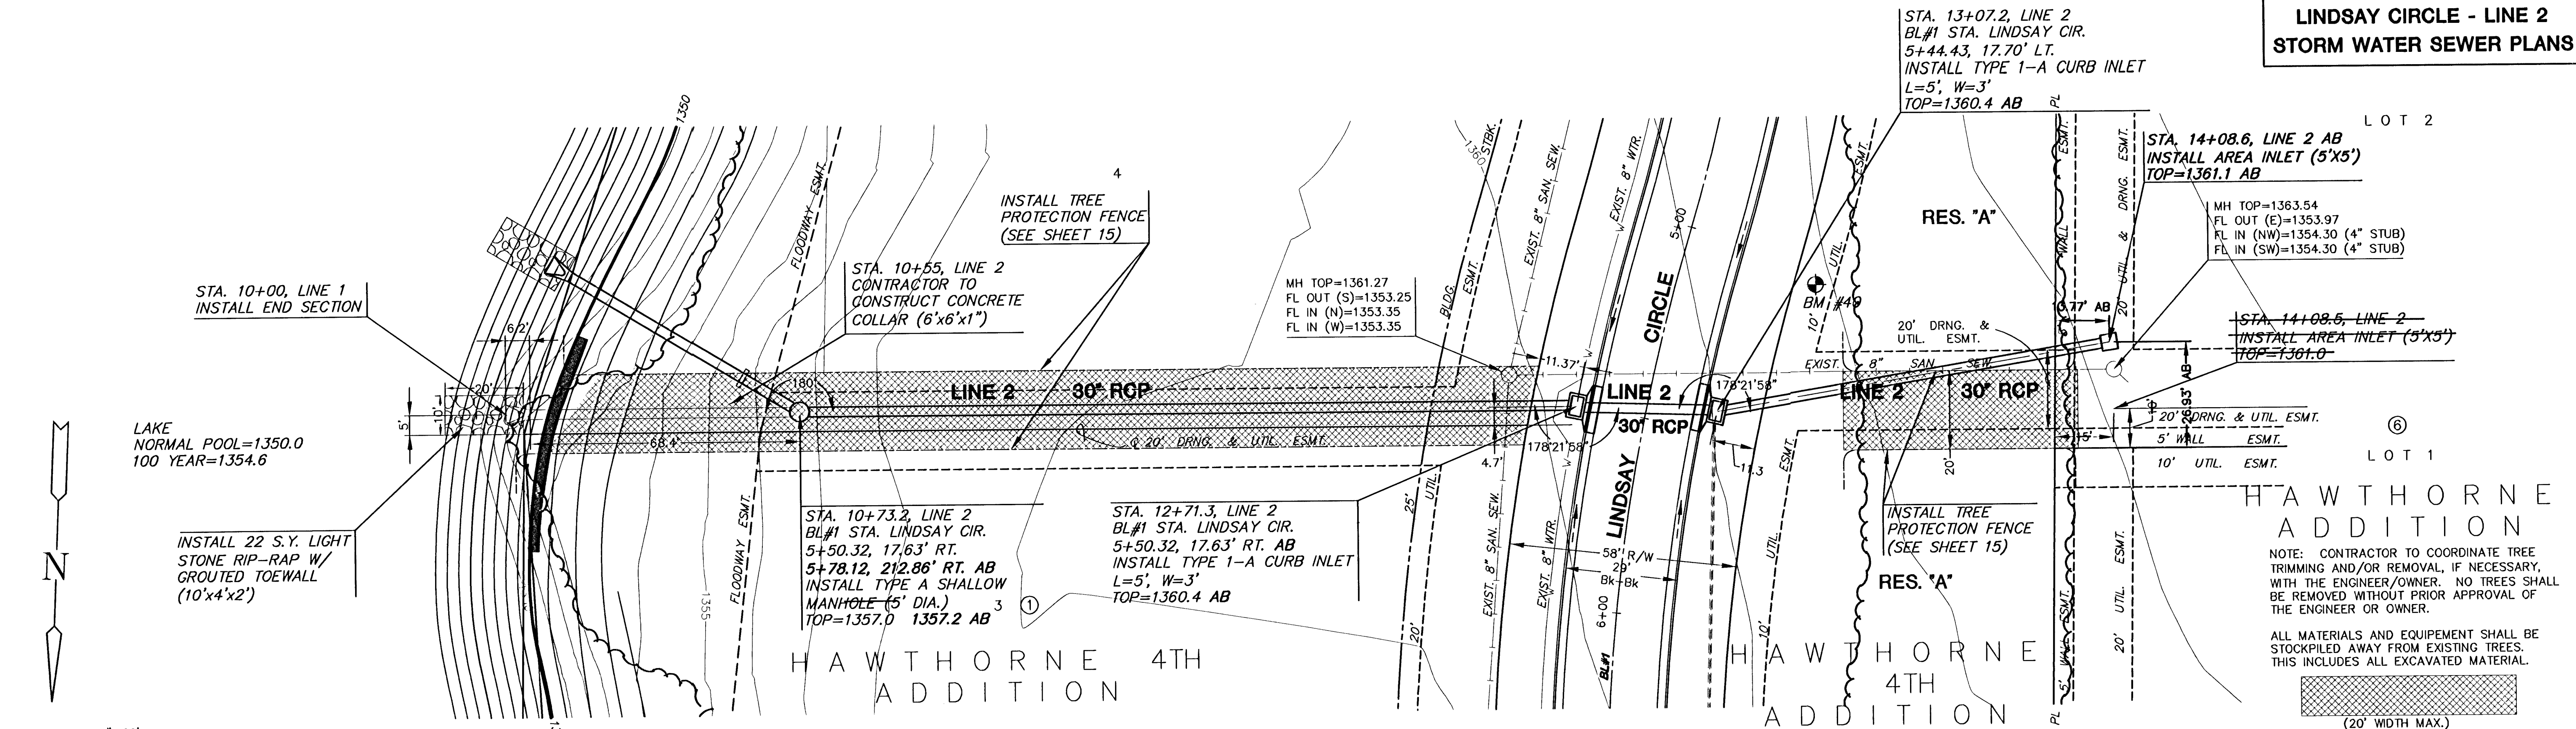

PLAN LINE 2

PROFILE LINE 2

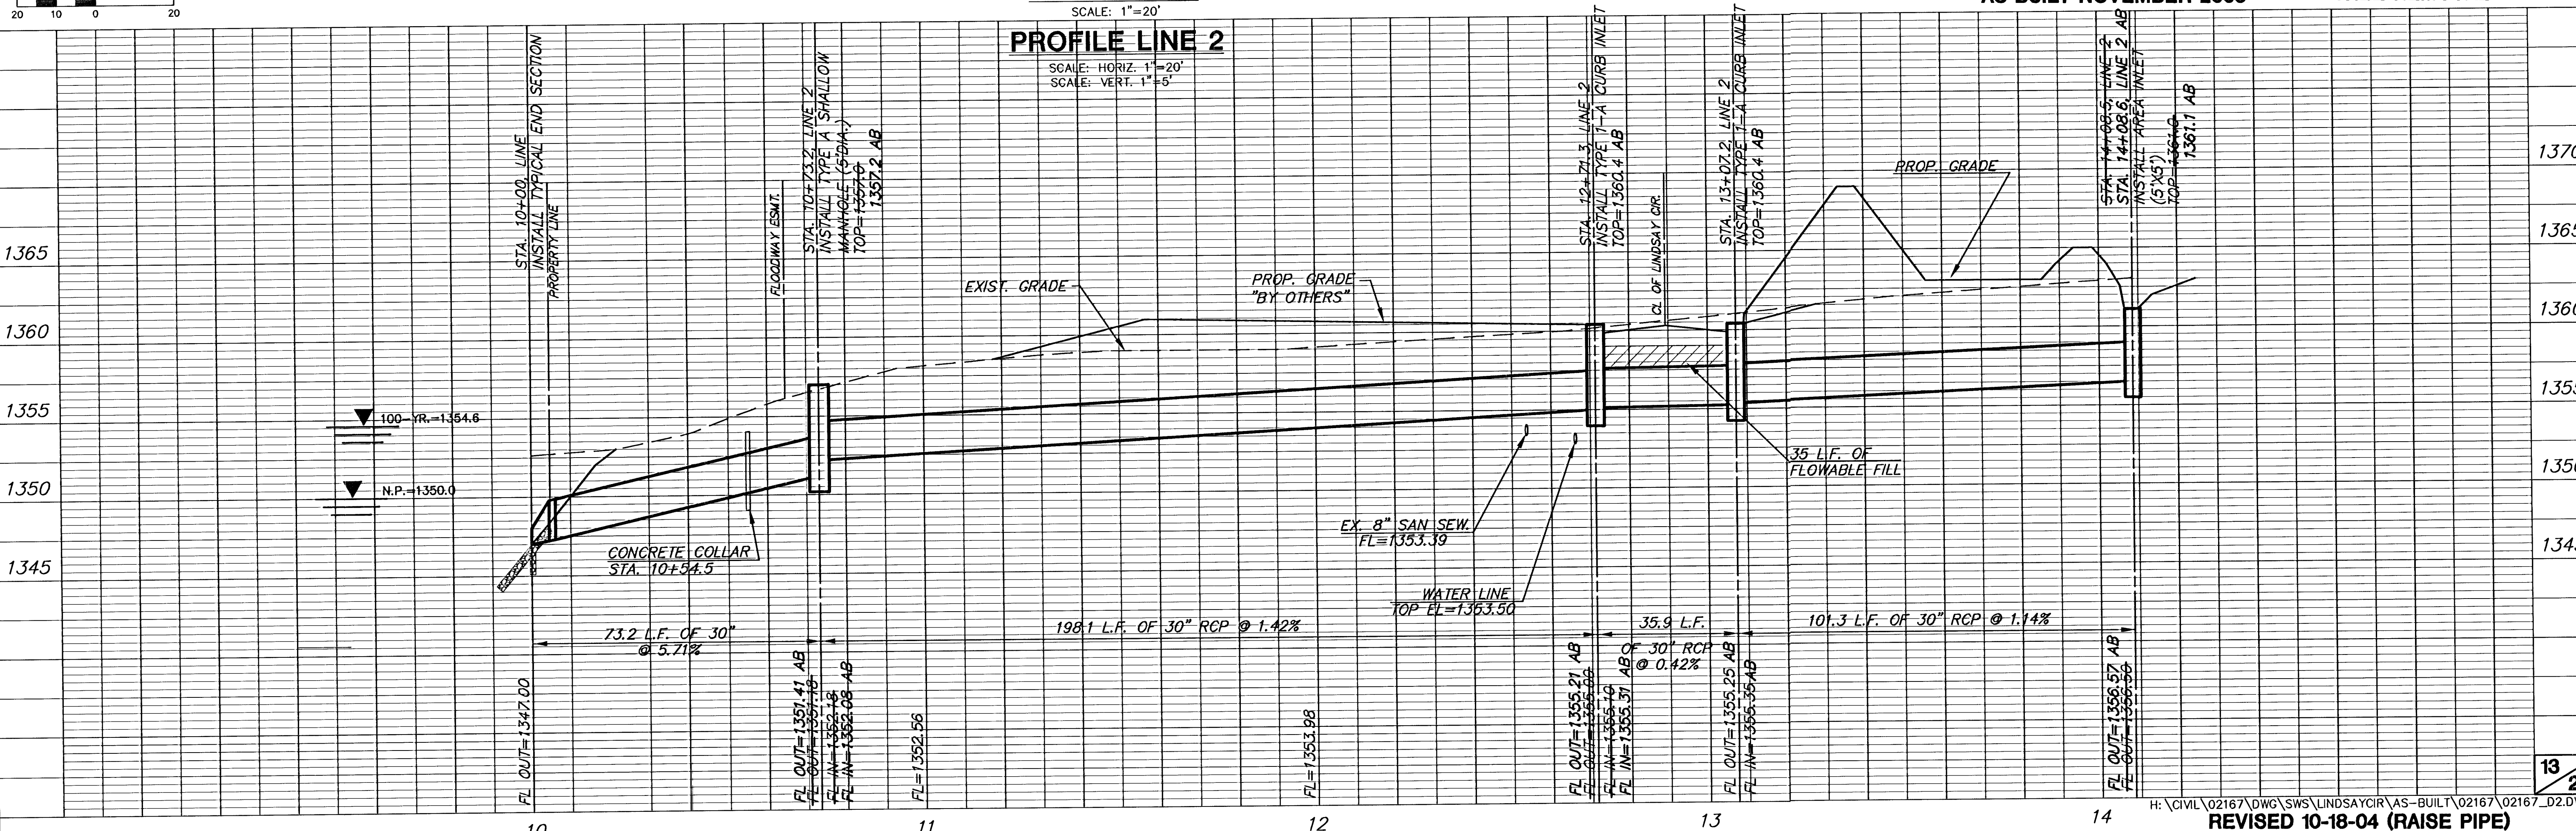

AS-BUILT NOVEMBER 2005

TREE REMOVAL