




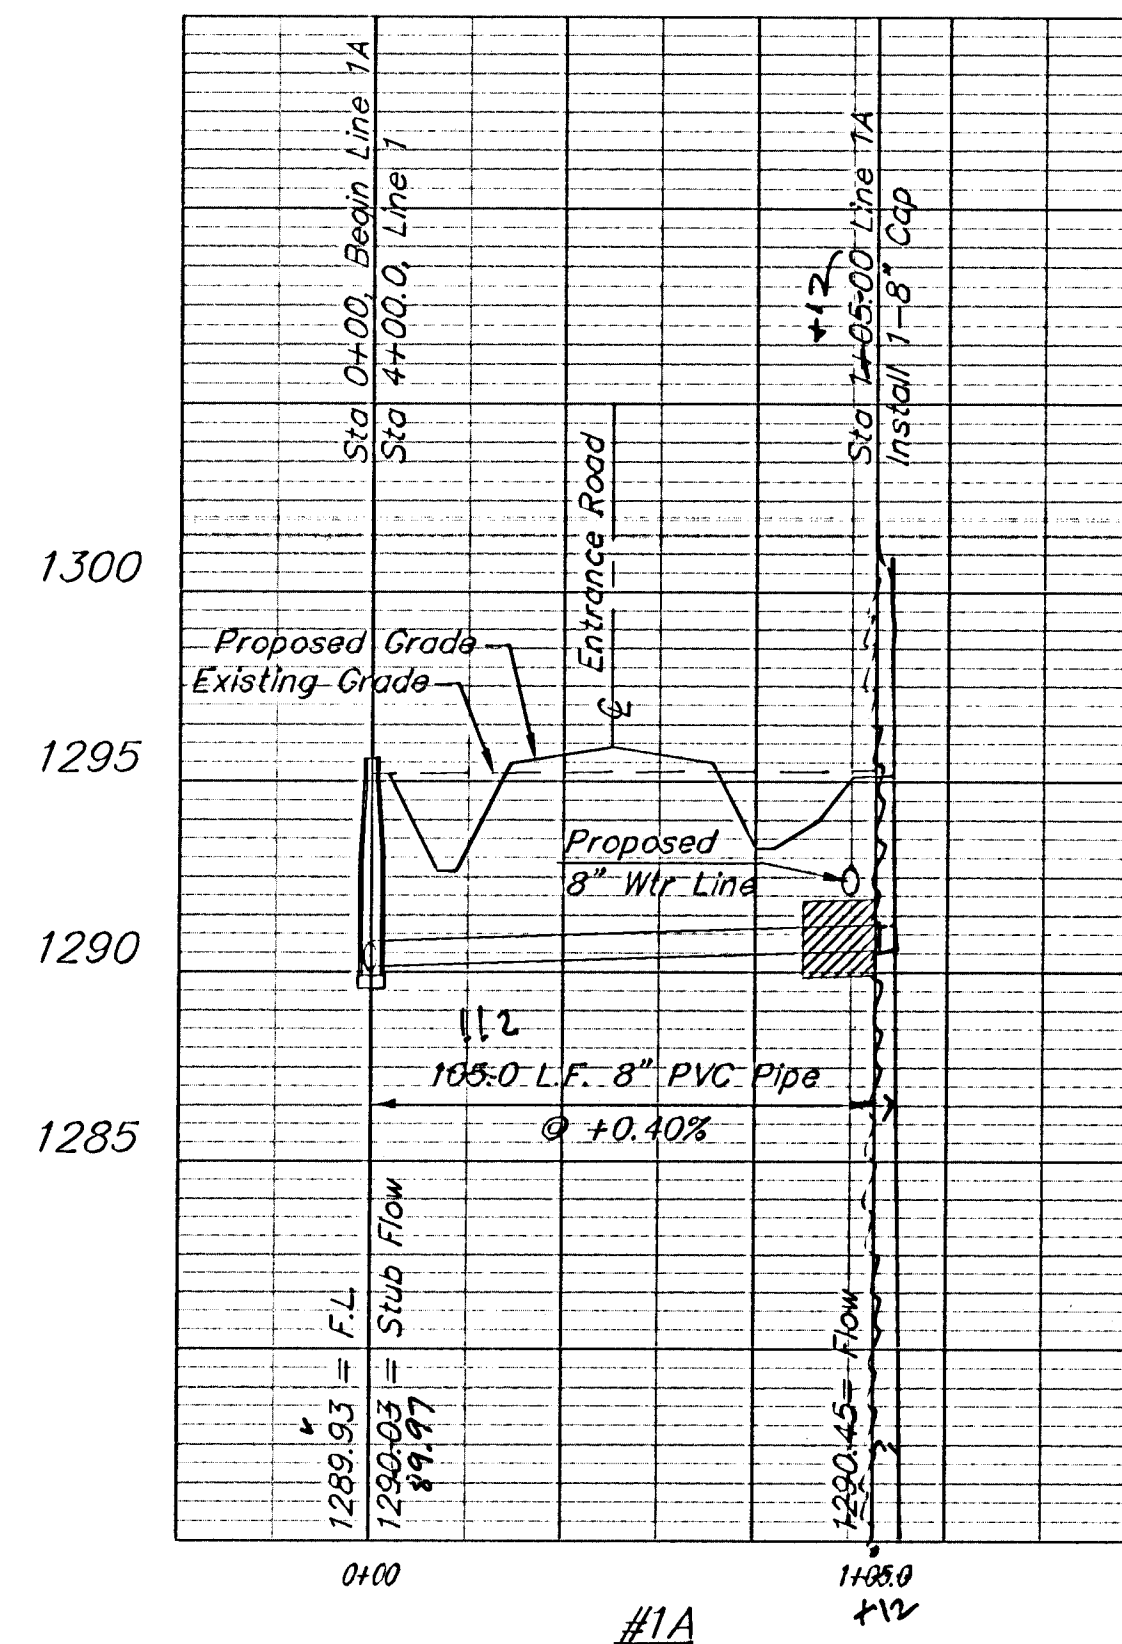


1300
1295
1290
1285

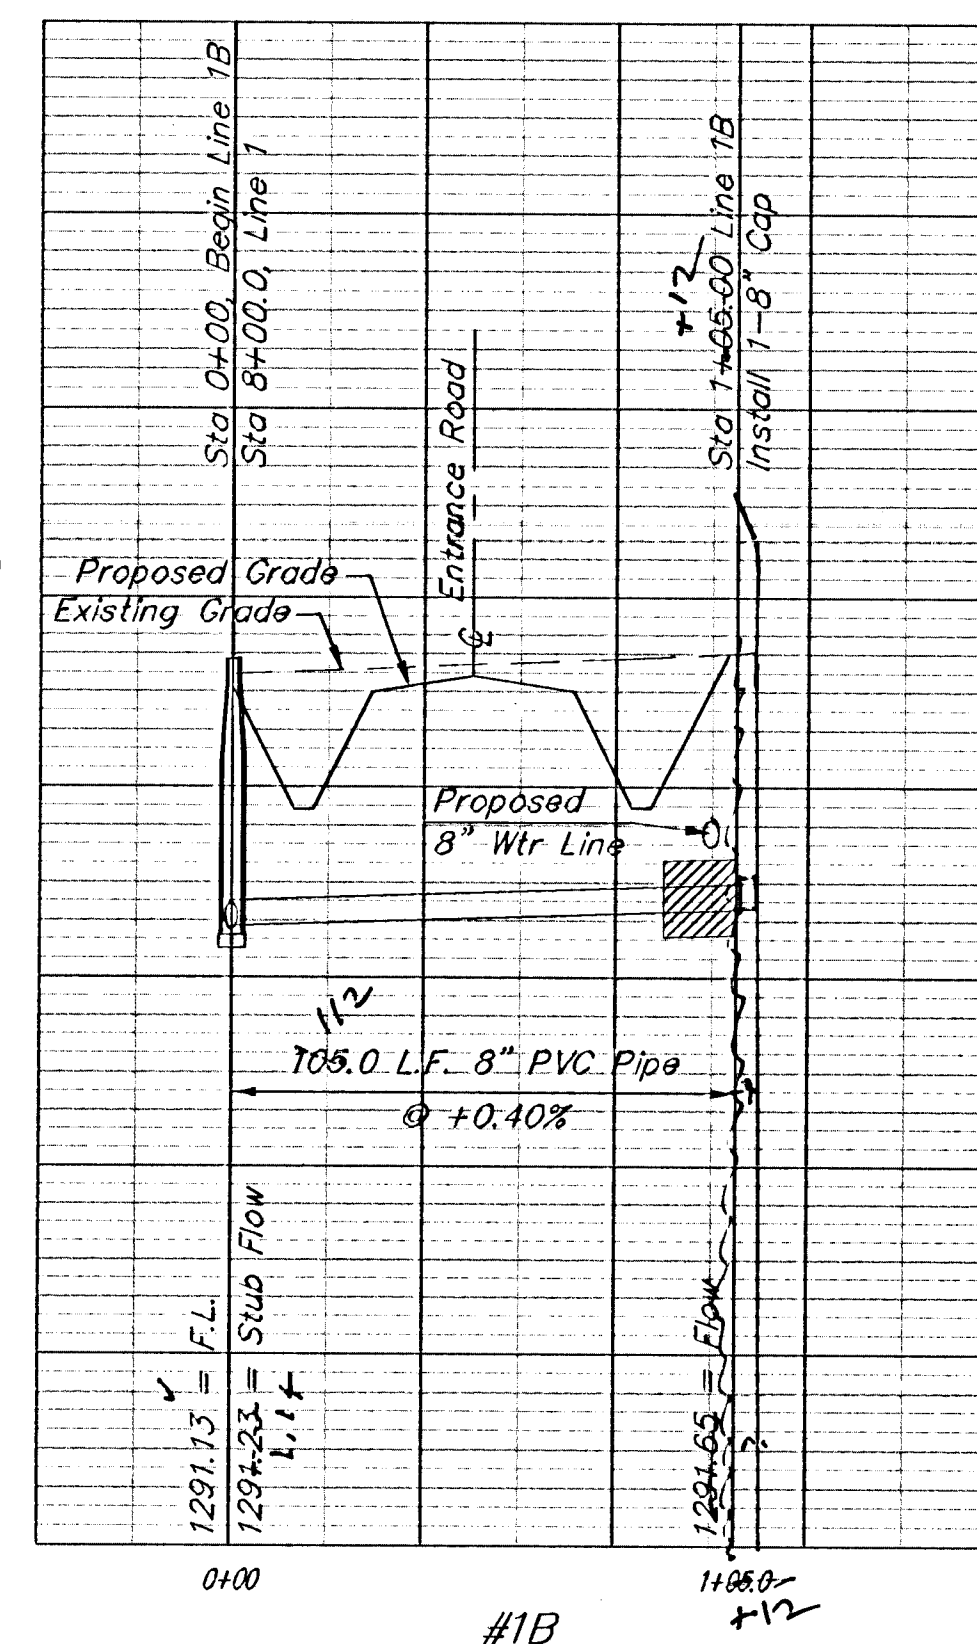


1300
1295
1290
1285

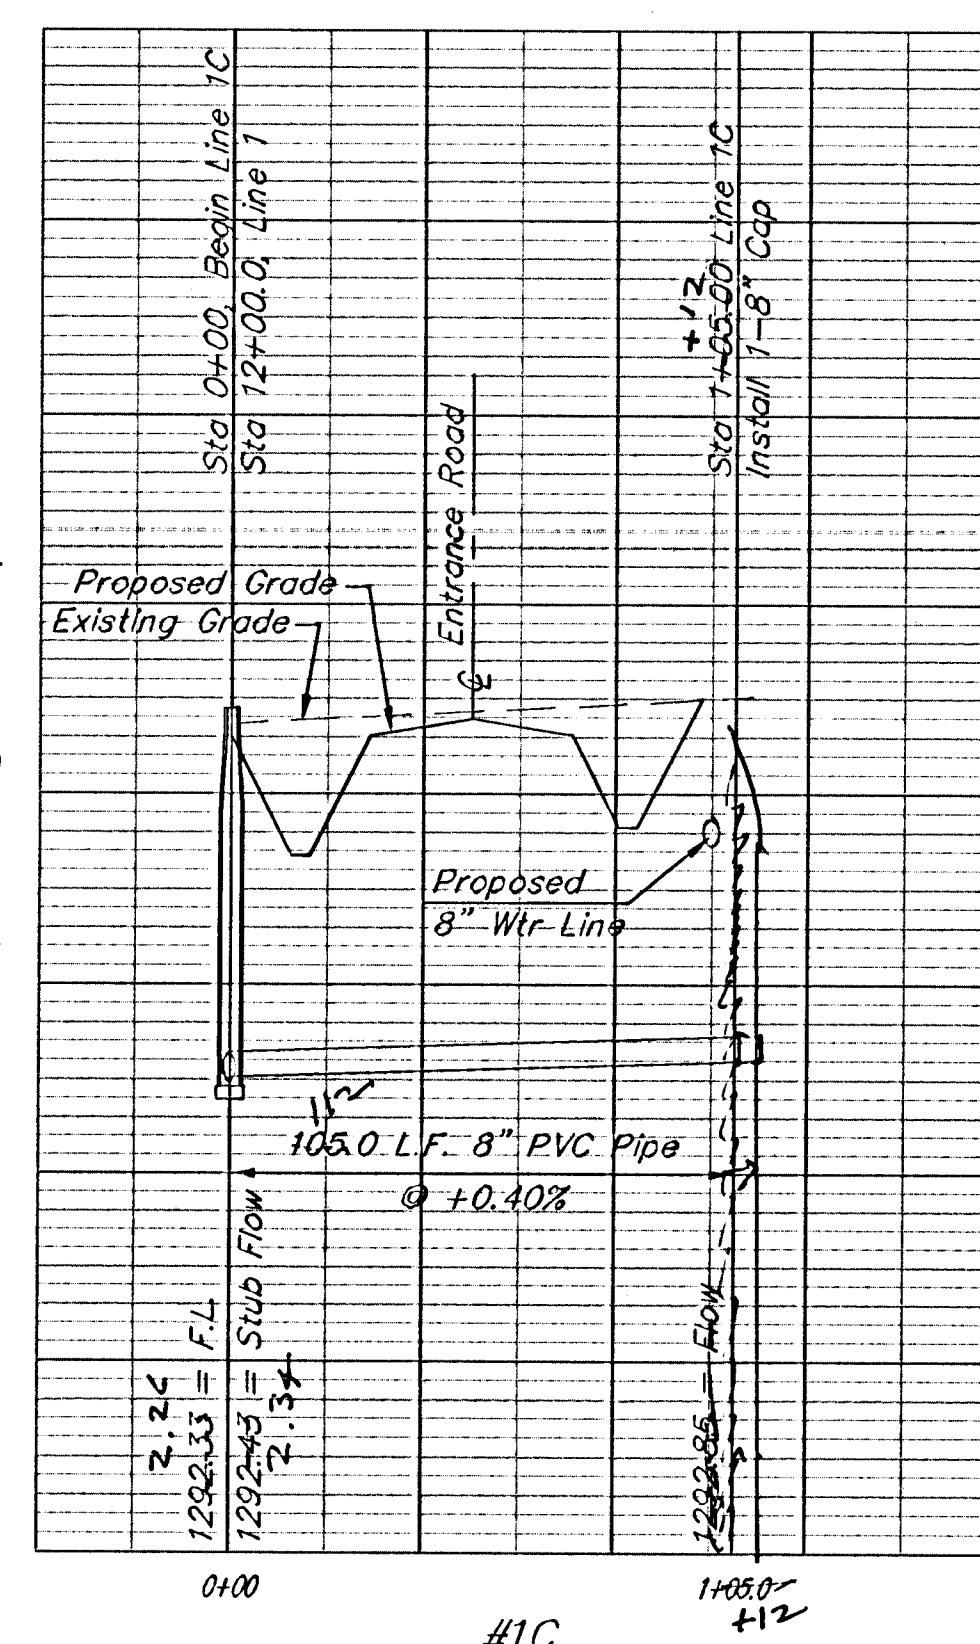


1305
1300
1295
1290

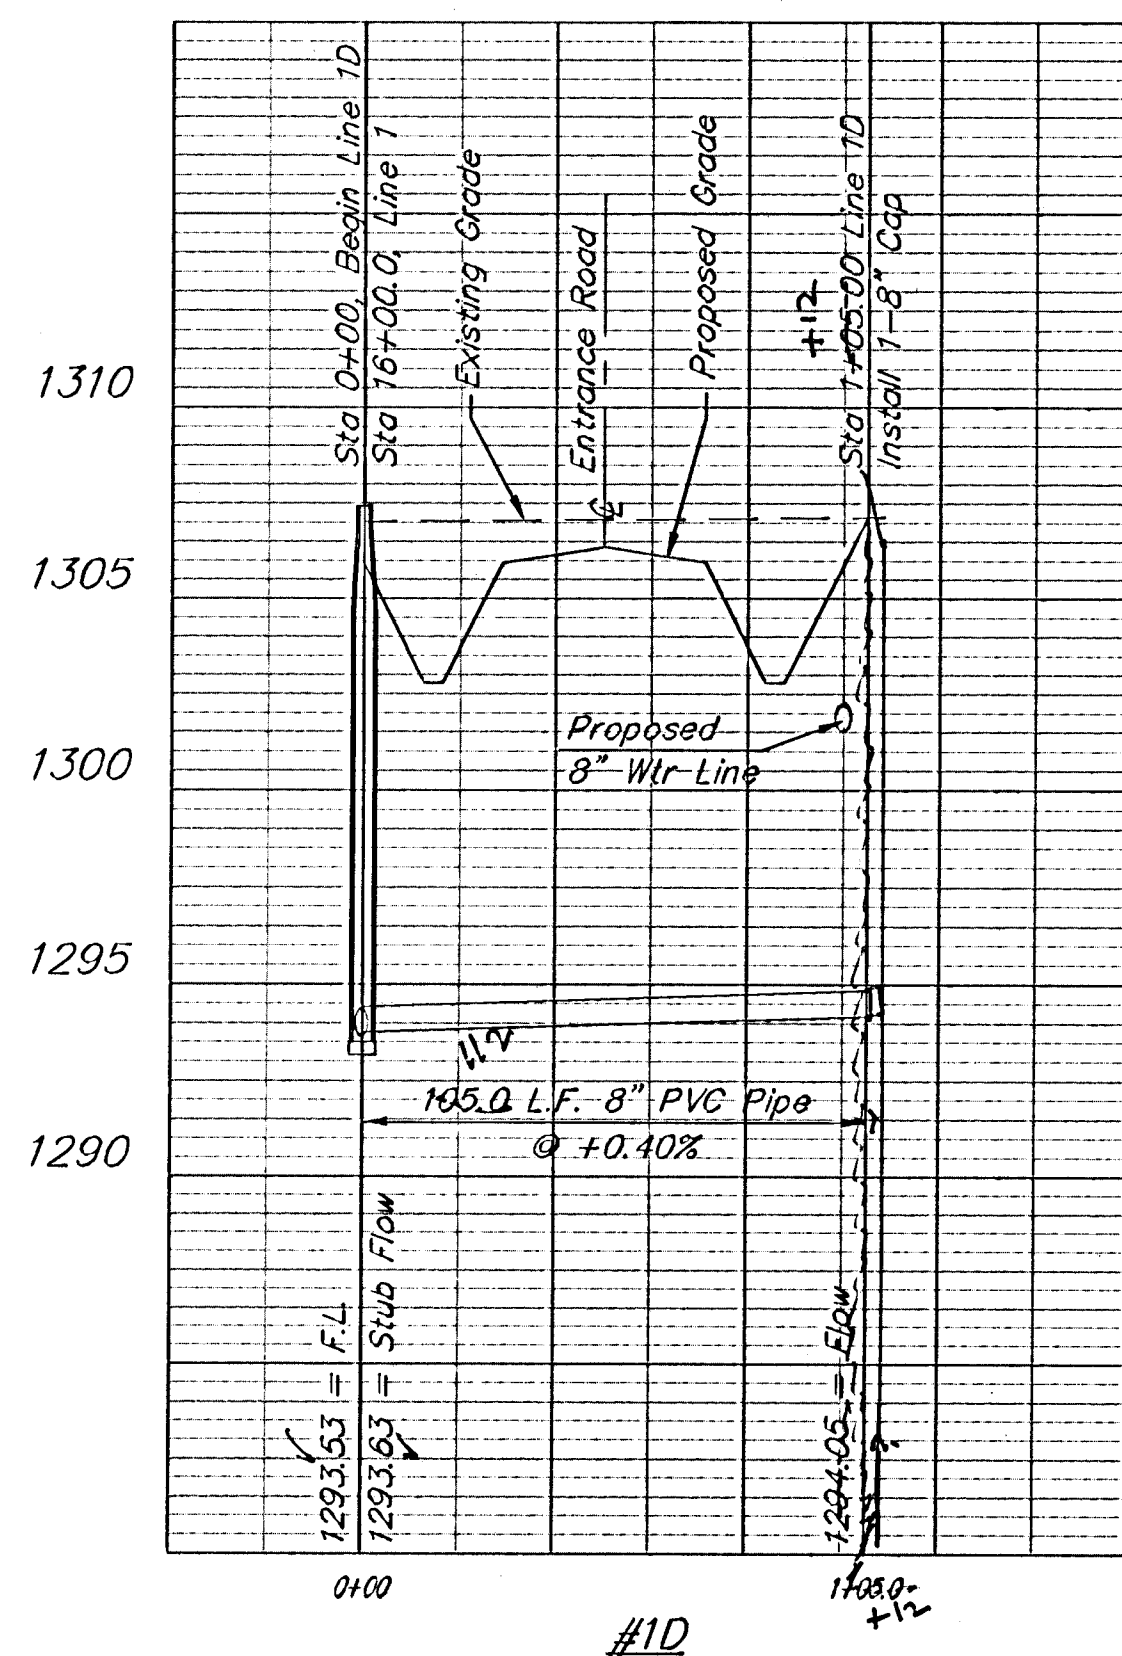

1310
1305
1300
1295
1290

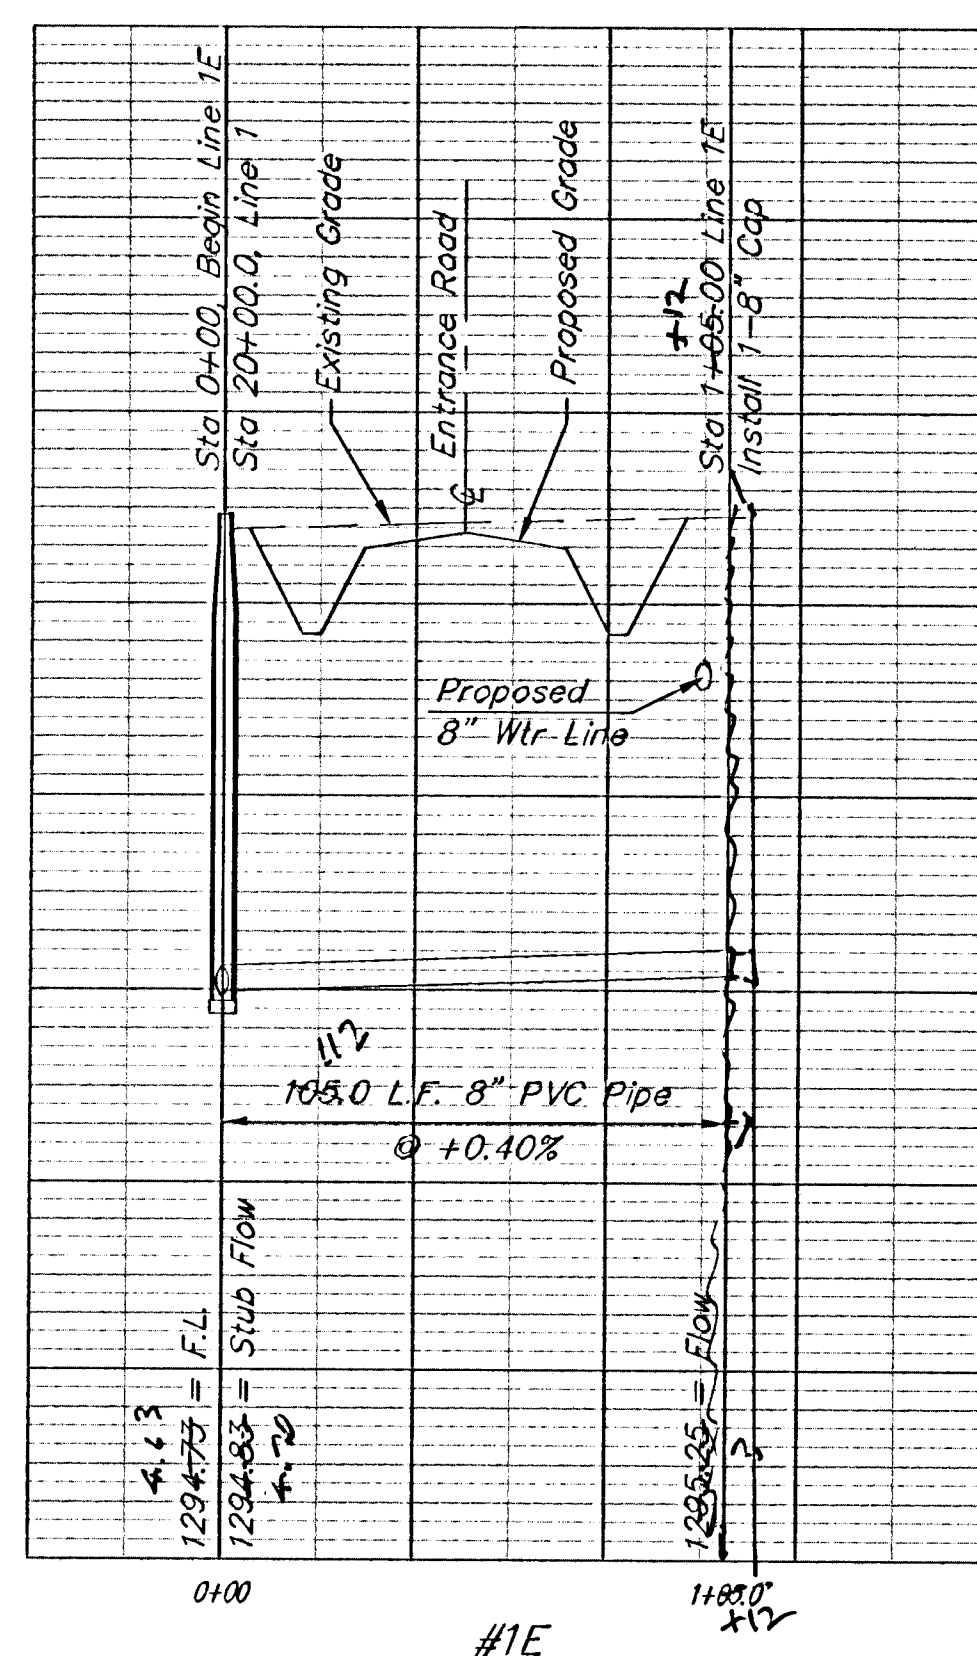


1310
1305
1300
1295
1290

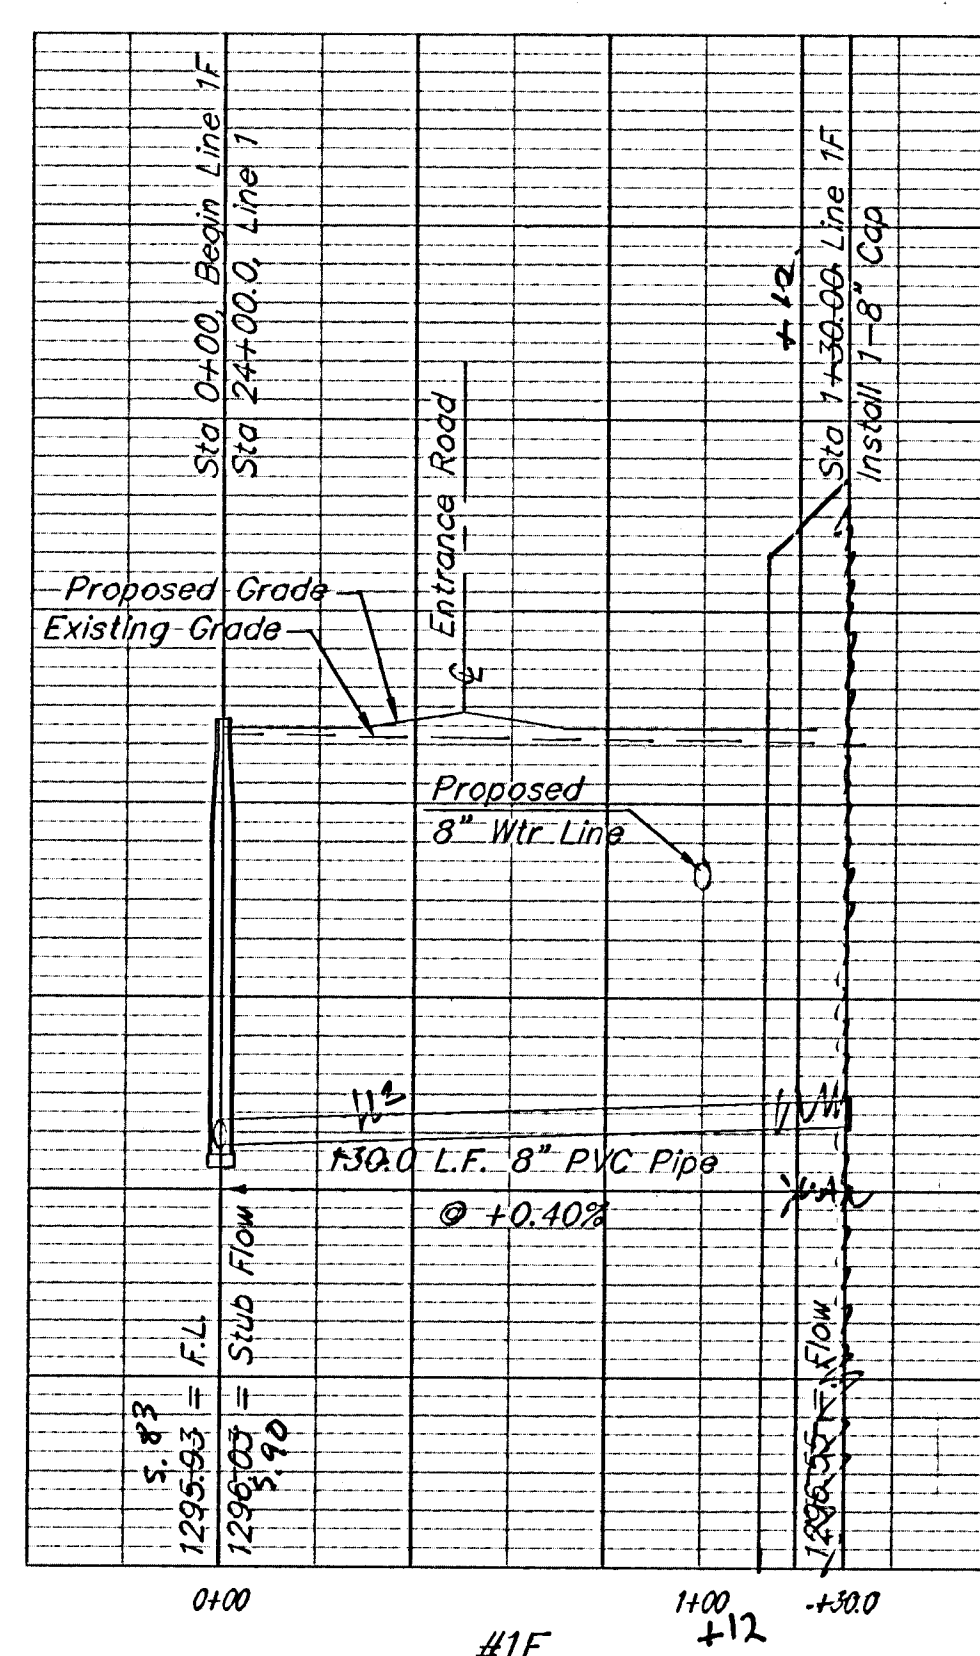

1310
1305
1300
1295

MARK ALL END OF STUBS WITH A #4 REBAR INSIDE A 3/4" I.D. PLASTIC PIPE. THE REBAR SHALL EXTEND FROM THE TOP OF THE RISER TO A POINT 6" (MAX.) BELOW THE GROUND SURFACE. THE PLASTIC PIPE SHALL EXTEND FROM THE TOP OF THE RISER TO A POINT 4 FEET (MIN.) ABOVE THE GROUND SURFACE. THE TOP 4 FEET OF THE PLASTIC PIPE SHALL BE PAINTED FLOURESCENT GREEN.

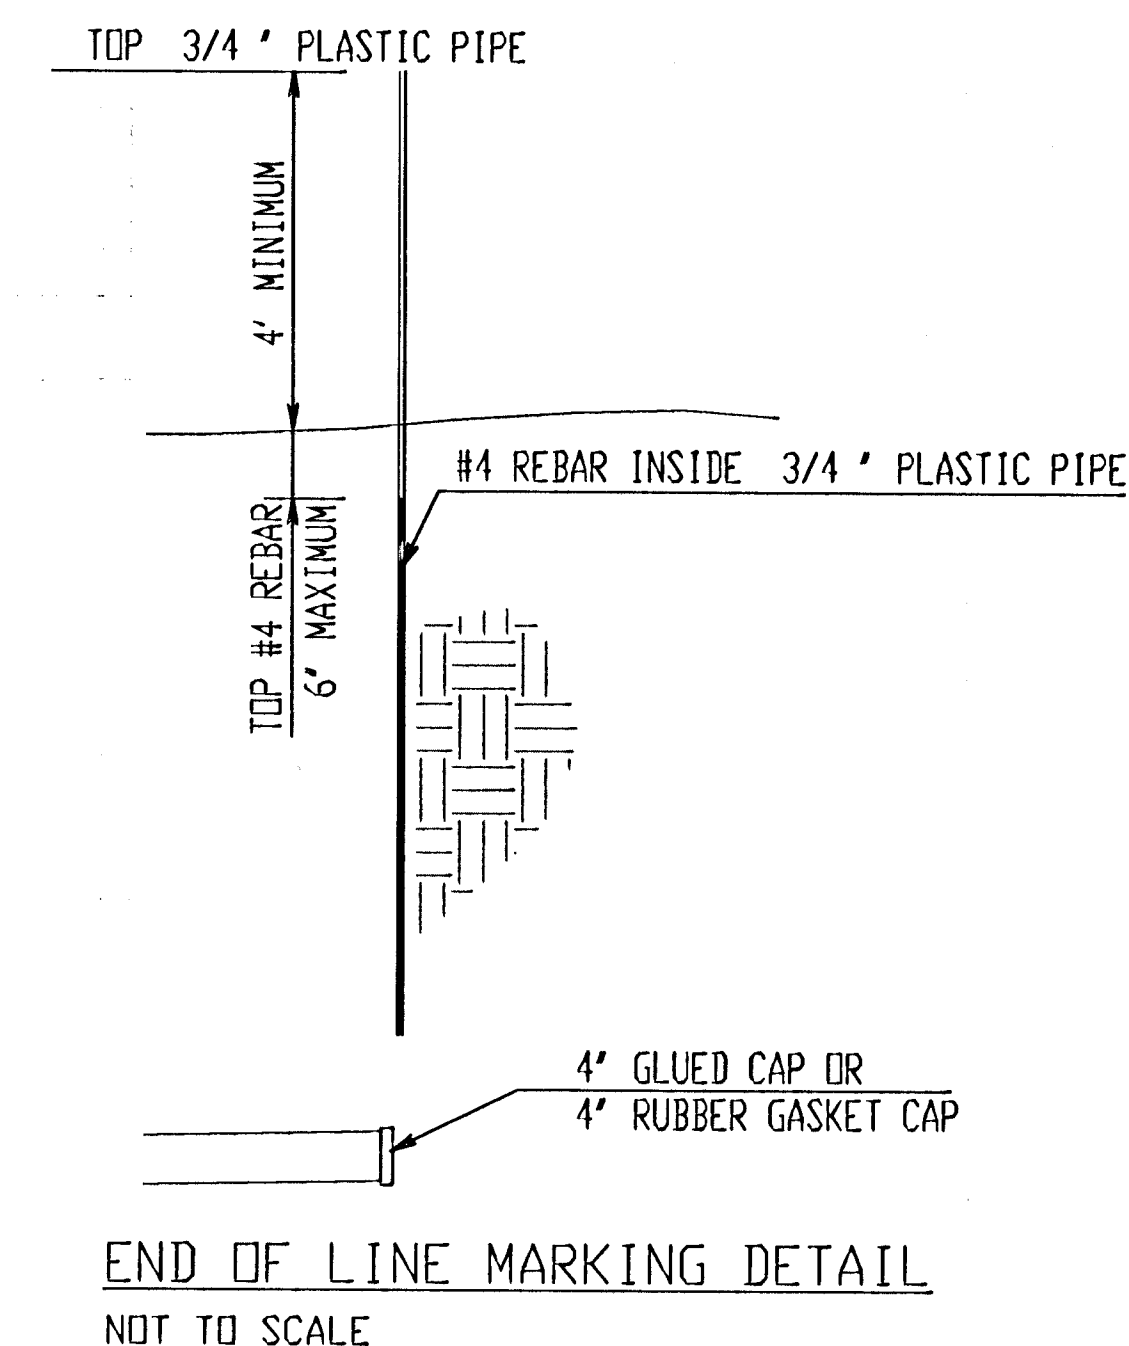

Scale: 1" = 5' Vertical

PROJECT NUMBER 1726 PPS (607861)		SHEET NAME Entrance Road		ENGINEERING DIRECTORY C&B Design	
DESIGN BLP	DRAWN MDC	APPROVED BLP	DATE 12/20/09	SCALE Noted	BAUGHMAN NO 08-10-HE280

ECCO INDUSTRIAL 2ND ADDITION
**SANITARY SEWER
CROSSINGS**

CARLSON-BAUGHMAN
ENGINEERING | SURVEYING | GIS | MAPPING
1508 Vine St. Hays, KS 67601 P 785-628-3219 F 785-628-2152

SHEET
4
OF
7

As Built 3/12/07 KSL