

SITE BENCHMARK
"□" Cut on Top of Curb
Along 34th Street North,
150' East of SW Corner of
Lot 7, Comotara Industrial
Park Fifth Addition.
Elev. = 1419.19 M.S.L.

SITE BENCHMARK:
"□" Cut on Top
of Curb
Elev. = 1419.19 M.S.L.

CAUTION!
Ex. UG Gas
crossing.
Depths Unknown.

Sta 0+00, Begin Line 1
Construct Std. Reinf. Conc.
Manhole over Existing 36"
RCP (5.5'x5.5' O.D.)
Remove 18.1 L.F. Ex. 8" SWS
Top Elev. = 1419.50

CAUTION!
Ex. UG Gas
Crossing
Depth Unknown



CAUTION!
Ex. UG
Electric

Sta 0+18.1, Line 1
Construct Std. Shallow
Manhole (4' Dia.)
1 - 12" PVC Stub (N)
Top Elev. = 1421.50

Sta 1+17.9, Line 1
Construct Type 1
Inlet (3'x5')
Top Elev. = 120.35
Install Sediment Barrier

Scale: 1" = 20' Horizontal
1" = 5' Vertical
• = Iron

Scale: 1" = 20' Horizontal
1" = 5' Vertical
• = Iron

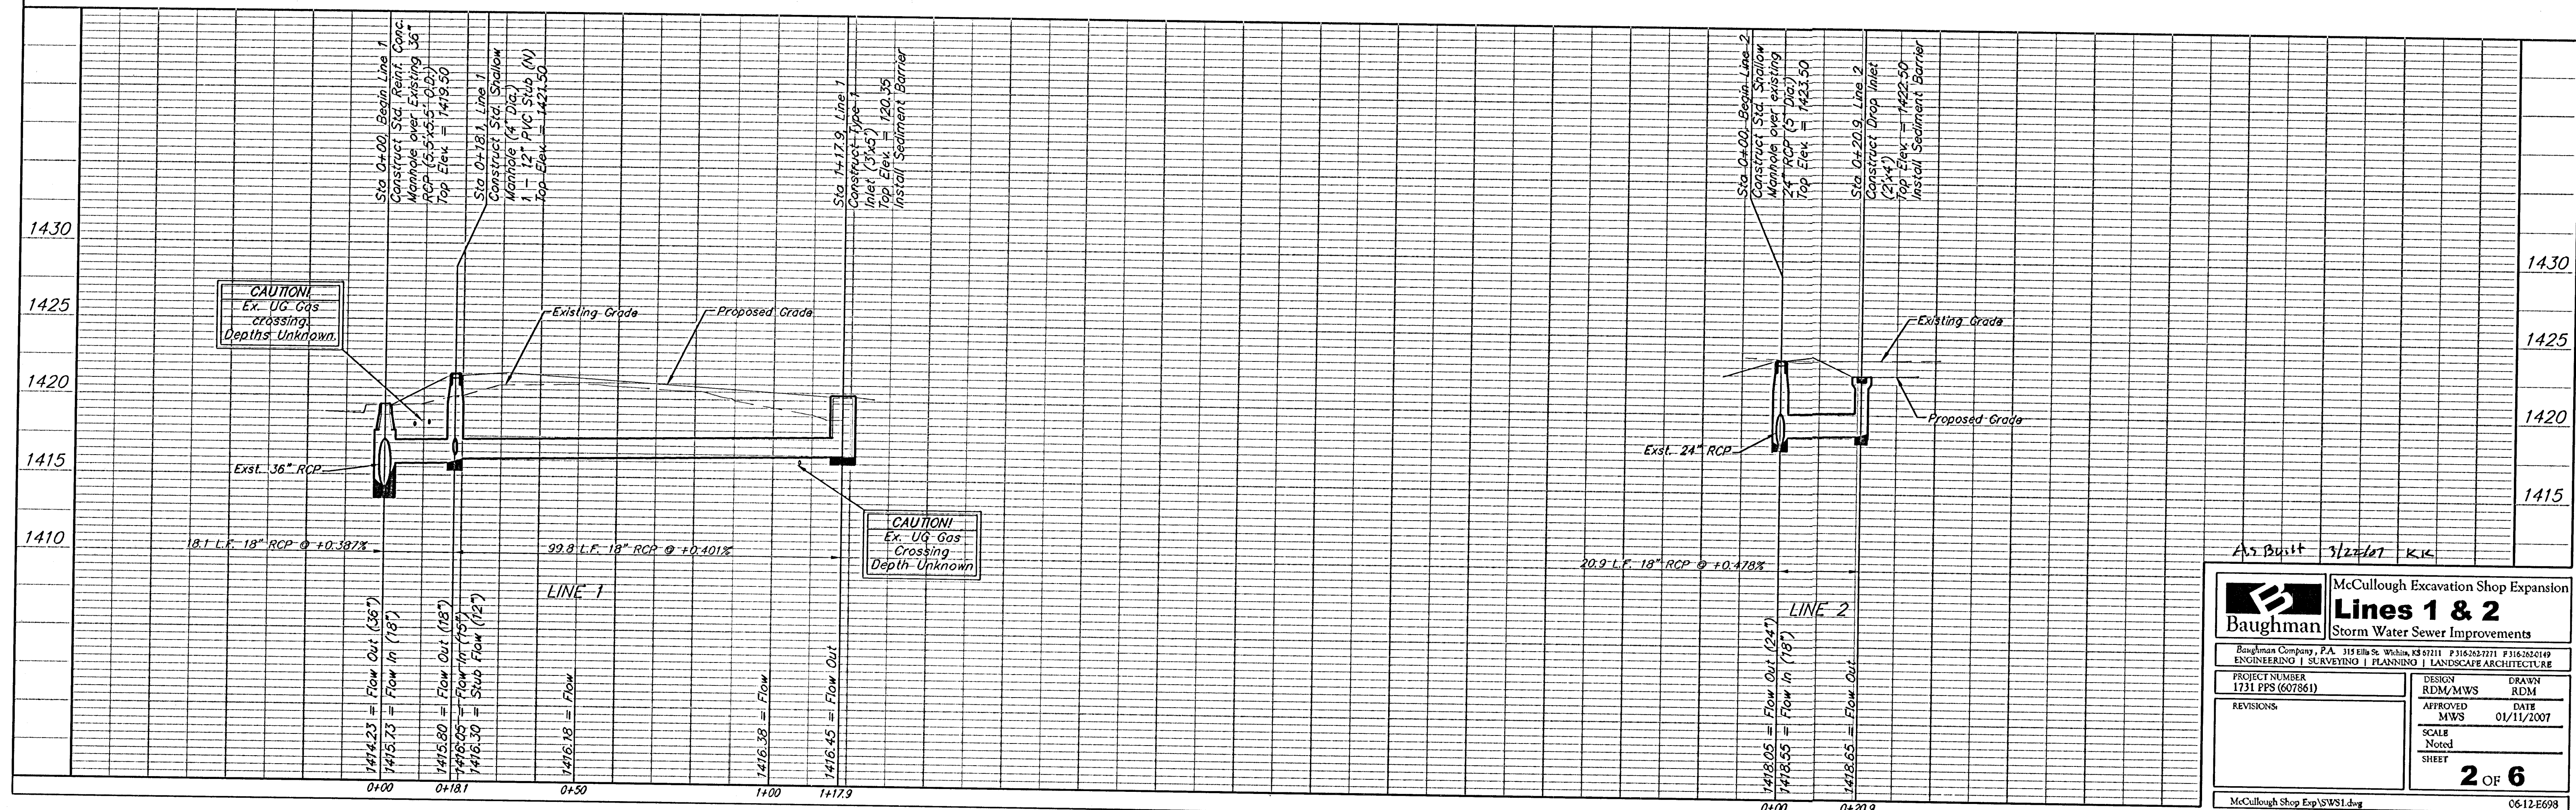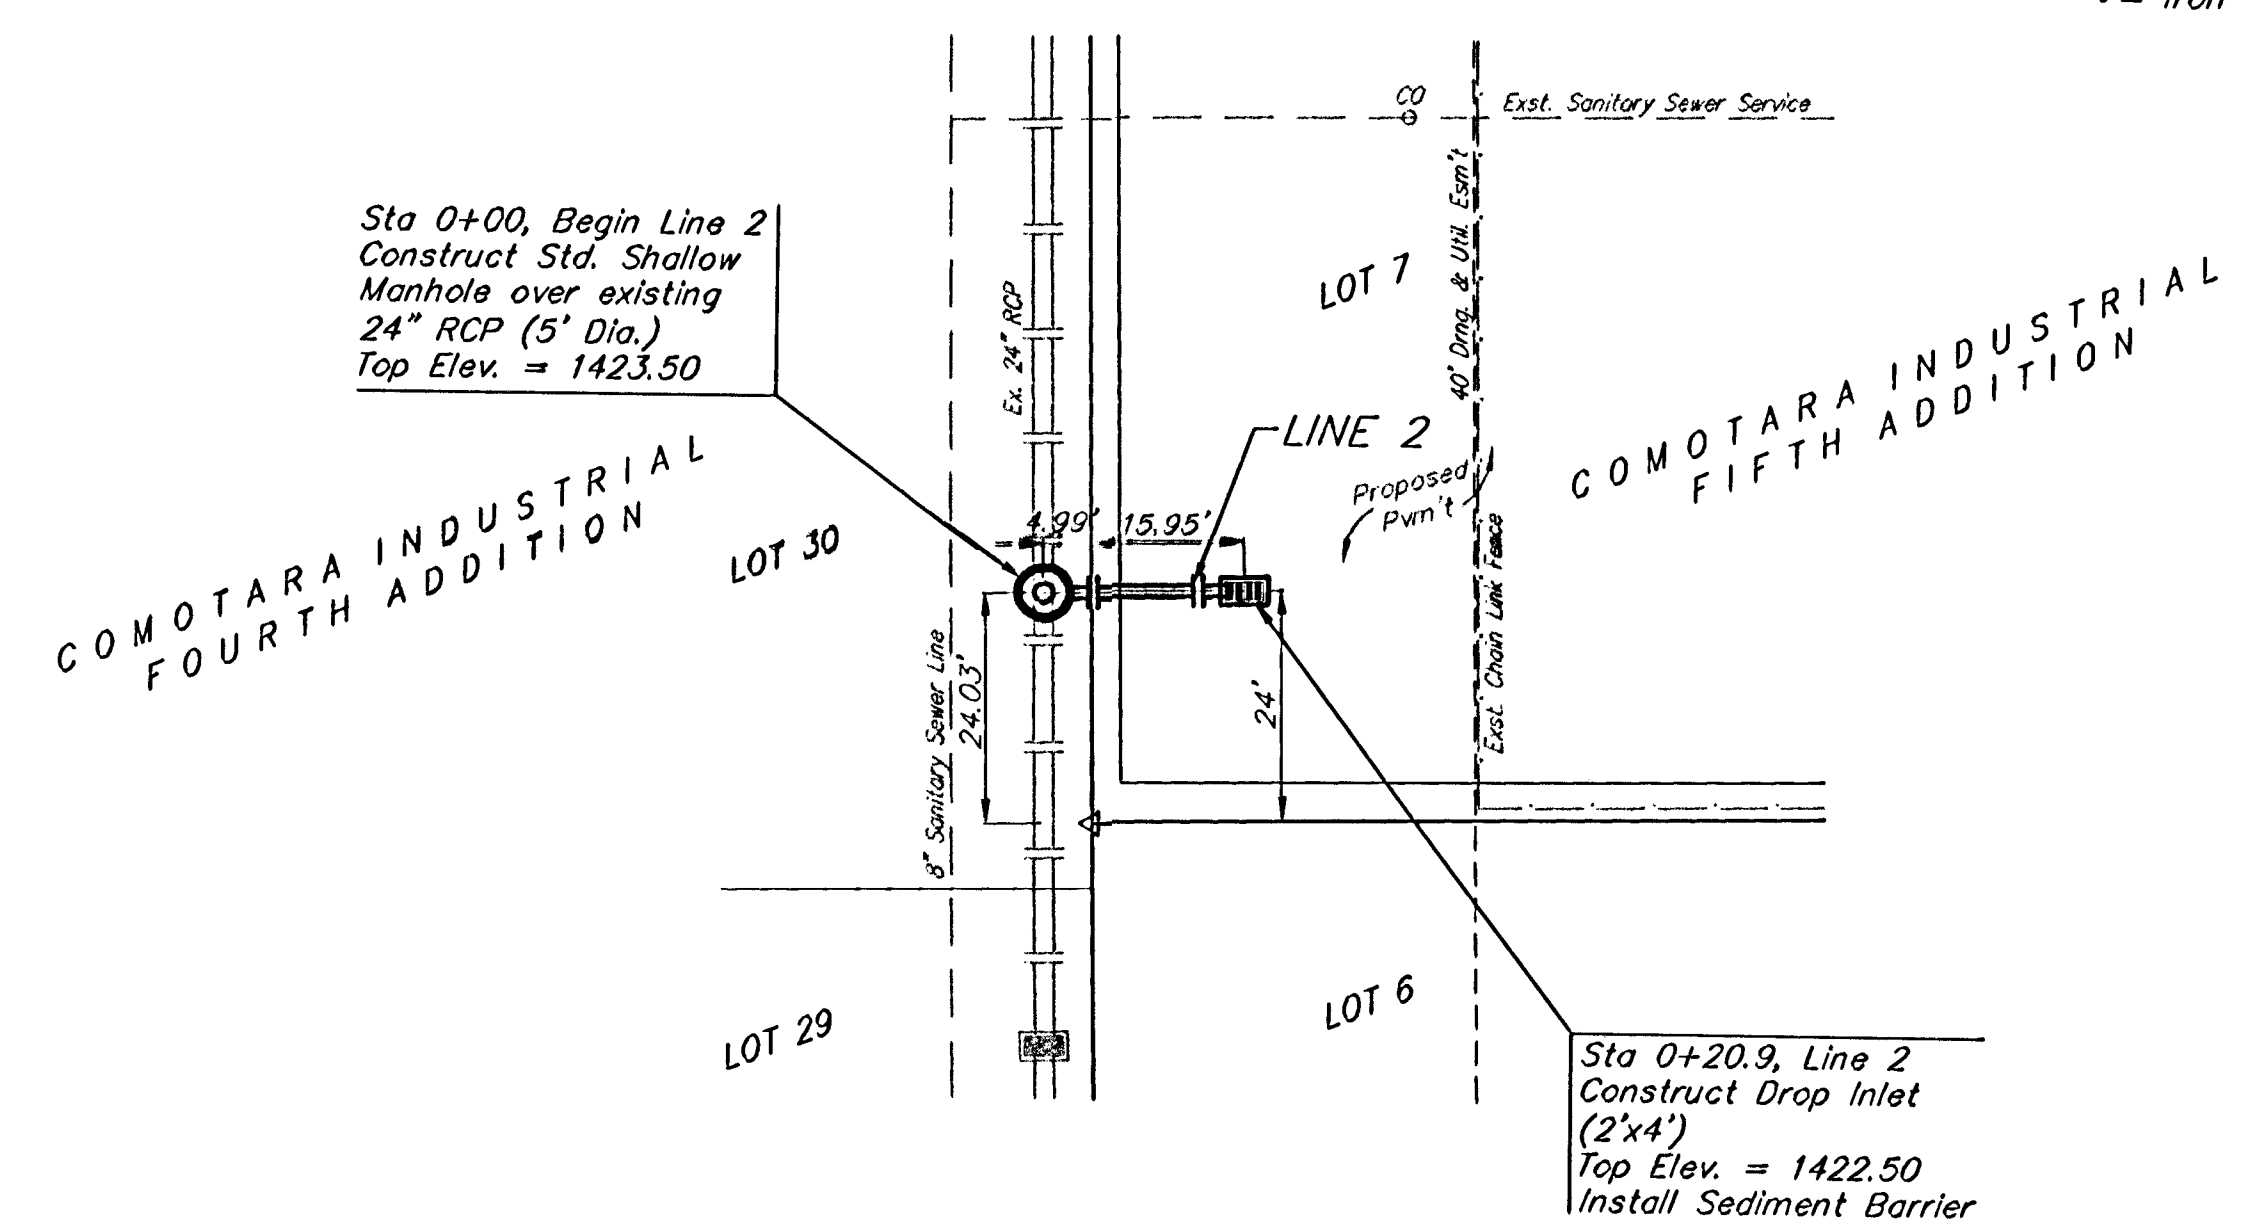

As Built 3/22/07 KIC

Baughman		McCullough Excavation Shop Expansion	
Lines 1 & 2		Storm Water Sewer Improvements	
Baughman Company, P.A. 3115 Ellis St. Wichita, KS 67211 P 316-262-7711 F 316-262-0149 ENGINEERING SURVEYING PLANNING LANDSCAPE ARCHITECTURE			
PROJECT NUMBER 1731 PPS (607861)		DESIGN RDM/MWS	DRAWN RDM
REVISIONS:		APPROVED MWS	DATE 01/11/2007
		SCALE Noted	
		SHEET	2 OF 6
McCullough Shop Exp SWS1.dwg		0612.E698	