


STA. 0+00 LINE 3
CONNECT TO EXISTING SANITARY SEWER MH
REMOVE EXISTING RING & COVER & REPLACE
W/ STD. CITY OF WICHITA COVER
MATCH RIM ELEV.=1333.52
FL. IN =1326.96 (E)
FL. OUT=1326.86 (S)

STA. 0+55.90 LINE 3
(1)-8" CLEANOUT RISER W/ DOUBLE WYE
CLEANOUT COVER ELEV.=1334.40
LOTS SERVED (12,13 BLOCK 2)

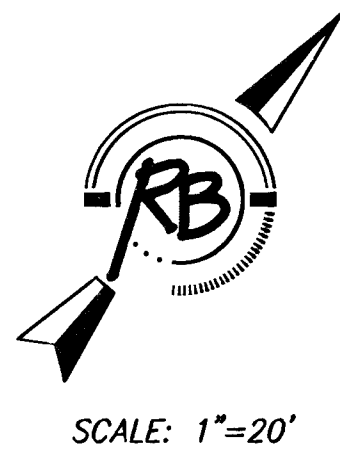

SCALE: 1"=20'

CONQUEST NORTH
PRIVATE

EXISTING SANITARY SEWER MH
TOP RIM=1333.52

REMOVE AND REPLACE
EXISTING PAVEMENT

LINE 3

CONQUEST NORTH
PRIVATE

EXIST. VALLEY GUTTER

PROPOSED DRIVE

STA. 0+31.00 LINE 4
CONSTRUCT STD. TYPE P MH
TOP RIM=1335.60
FL. OUT=1328.02
FL. 4" STUB=1330.02 (SE)

EXISTING 8" SANITARY SEWER

EXISTING SANITARY SEWER MH
TOP RIM=1333.93
FL. =1327.76

18" PRIVATE STREET EASEMENT

REMOVE EXISTING SIDEWALK
AS NECESSARY (DO NOT REPLACE)

STA. 0+00 LINE 4
CONNECT TO EXISTING SANITARY SEWER MH
REMOVE EXISTING RING & COVER & REPLACE
W/ STD. CITY OF WICHITA COVER
ADJUST RIM ELEV.=1335.40
FL. IN =1327.86
FL. OUT=1327.76 (MATCH)



SCALE: 1"=20'

LINE 4

Rev. as built 9-11-06 JCR

